


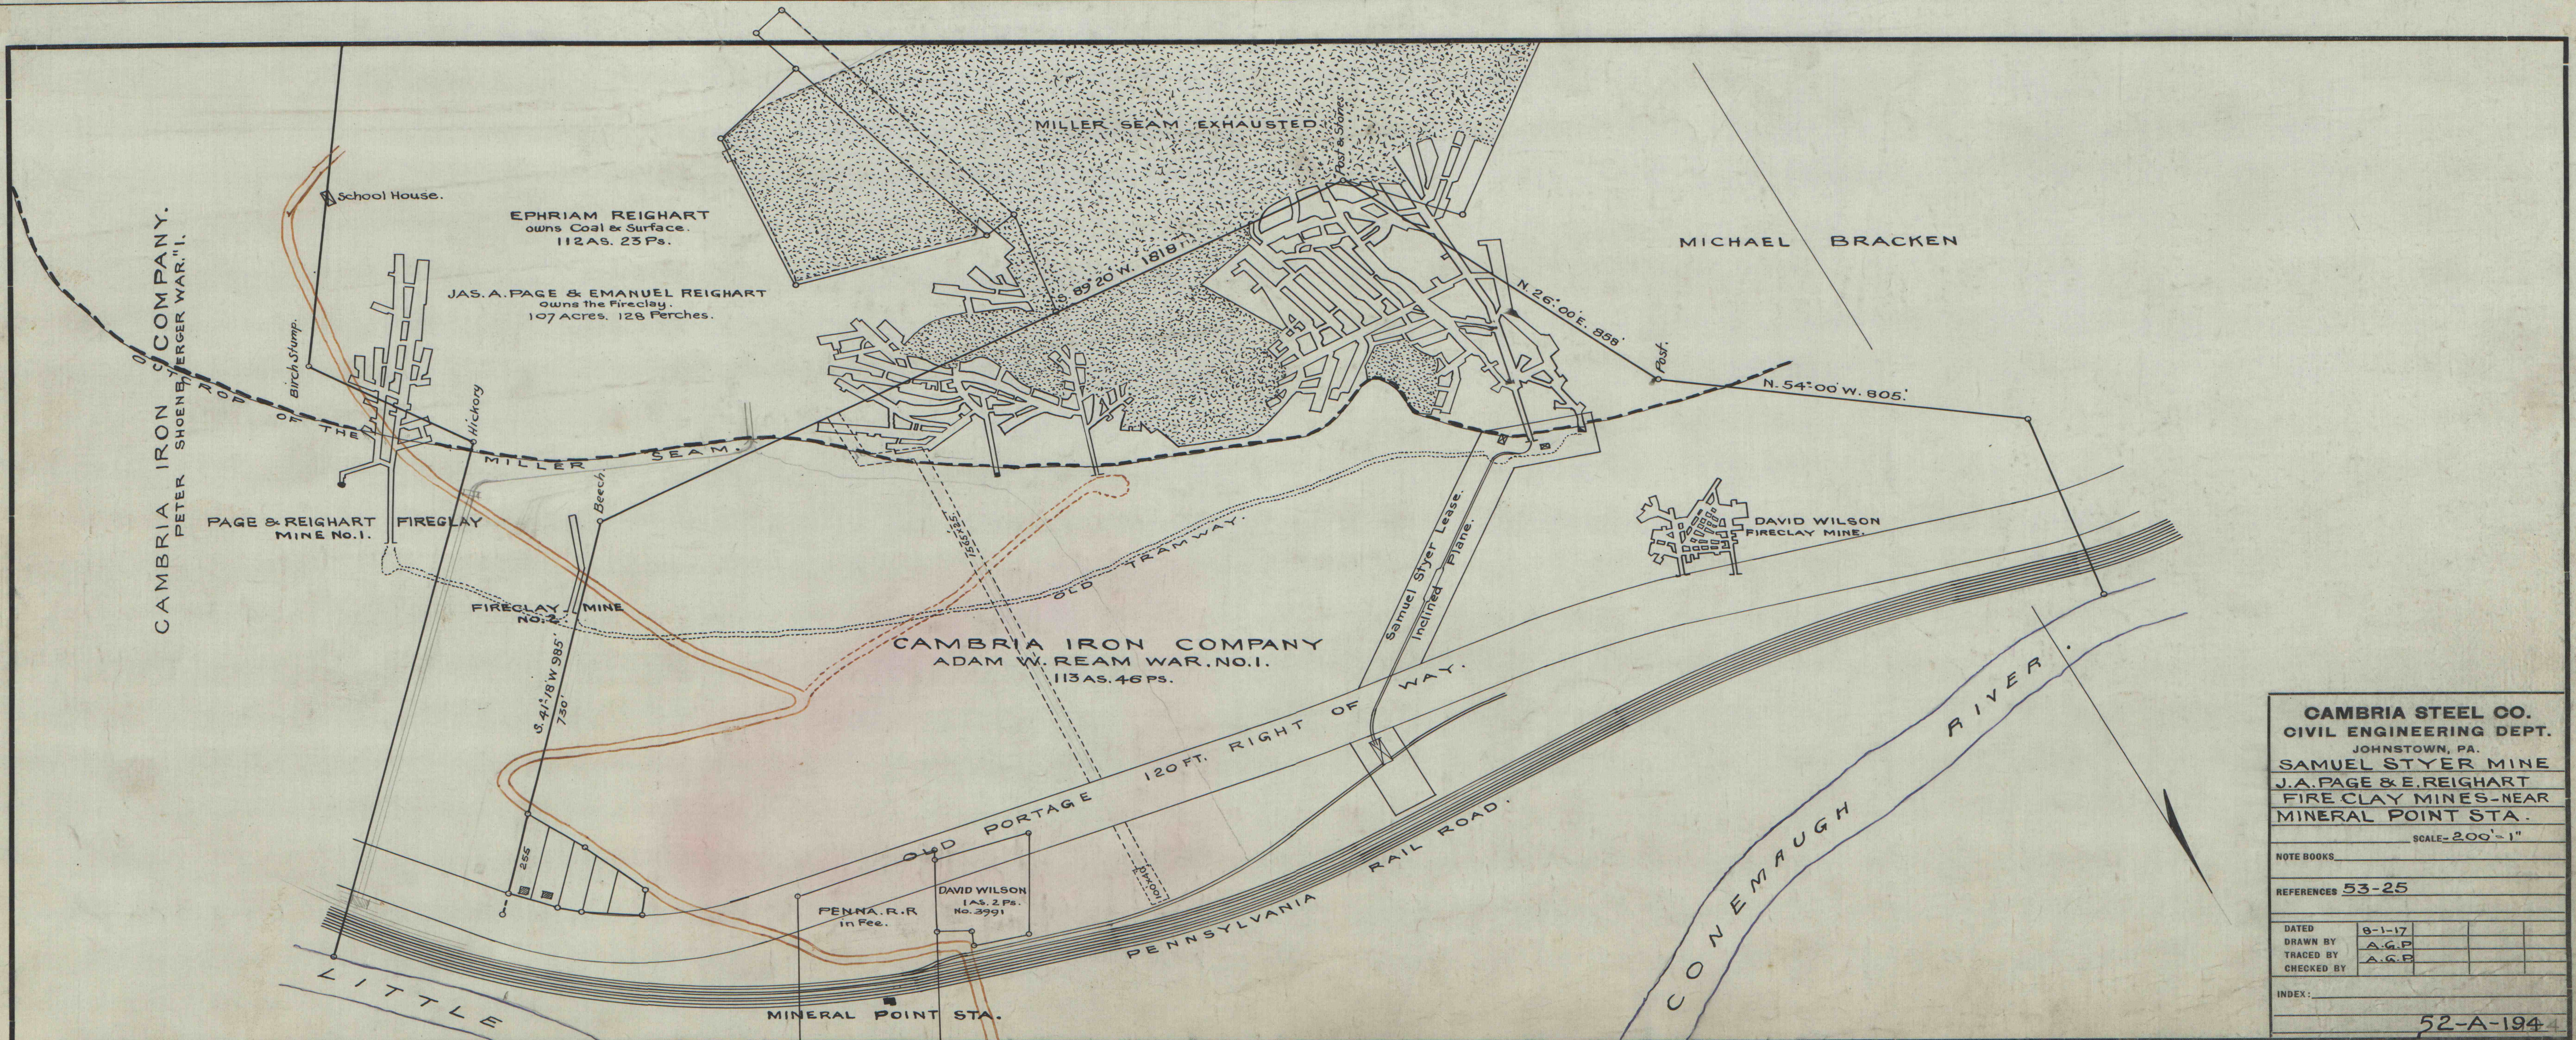

CAMBRIA STEEL CO.
CIVIL ENGINEERING DEPT.
JOHNSTOWN, PA.
SAMUEL STYER MINE
J.A. PAGE & E. REIGHART
FIRE CLAY MINES - NEAR
MINERAL POINT STA.
SCALE - 200' = 1"
NOTE BOOKS _____
REFERENCES 53-25
DATED 8-1-17
DRAWN BY A.G.P.
TRACED BY A.G.P.
CHECKED BY _____
INDEX: _____
52-A-194