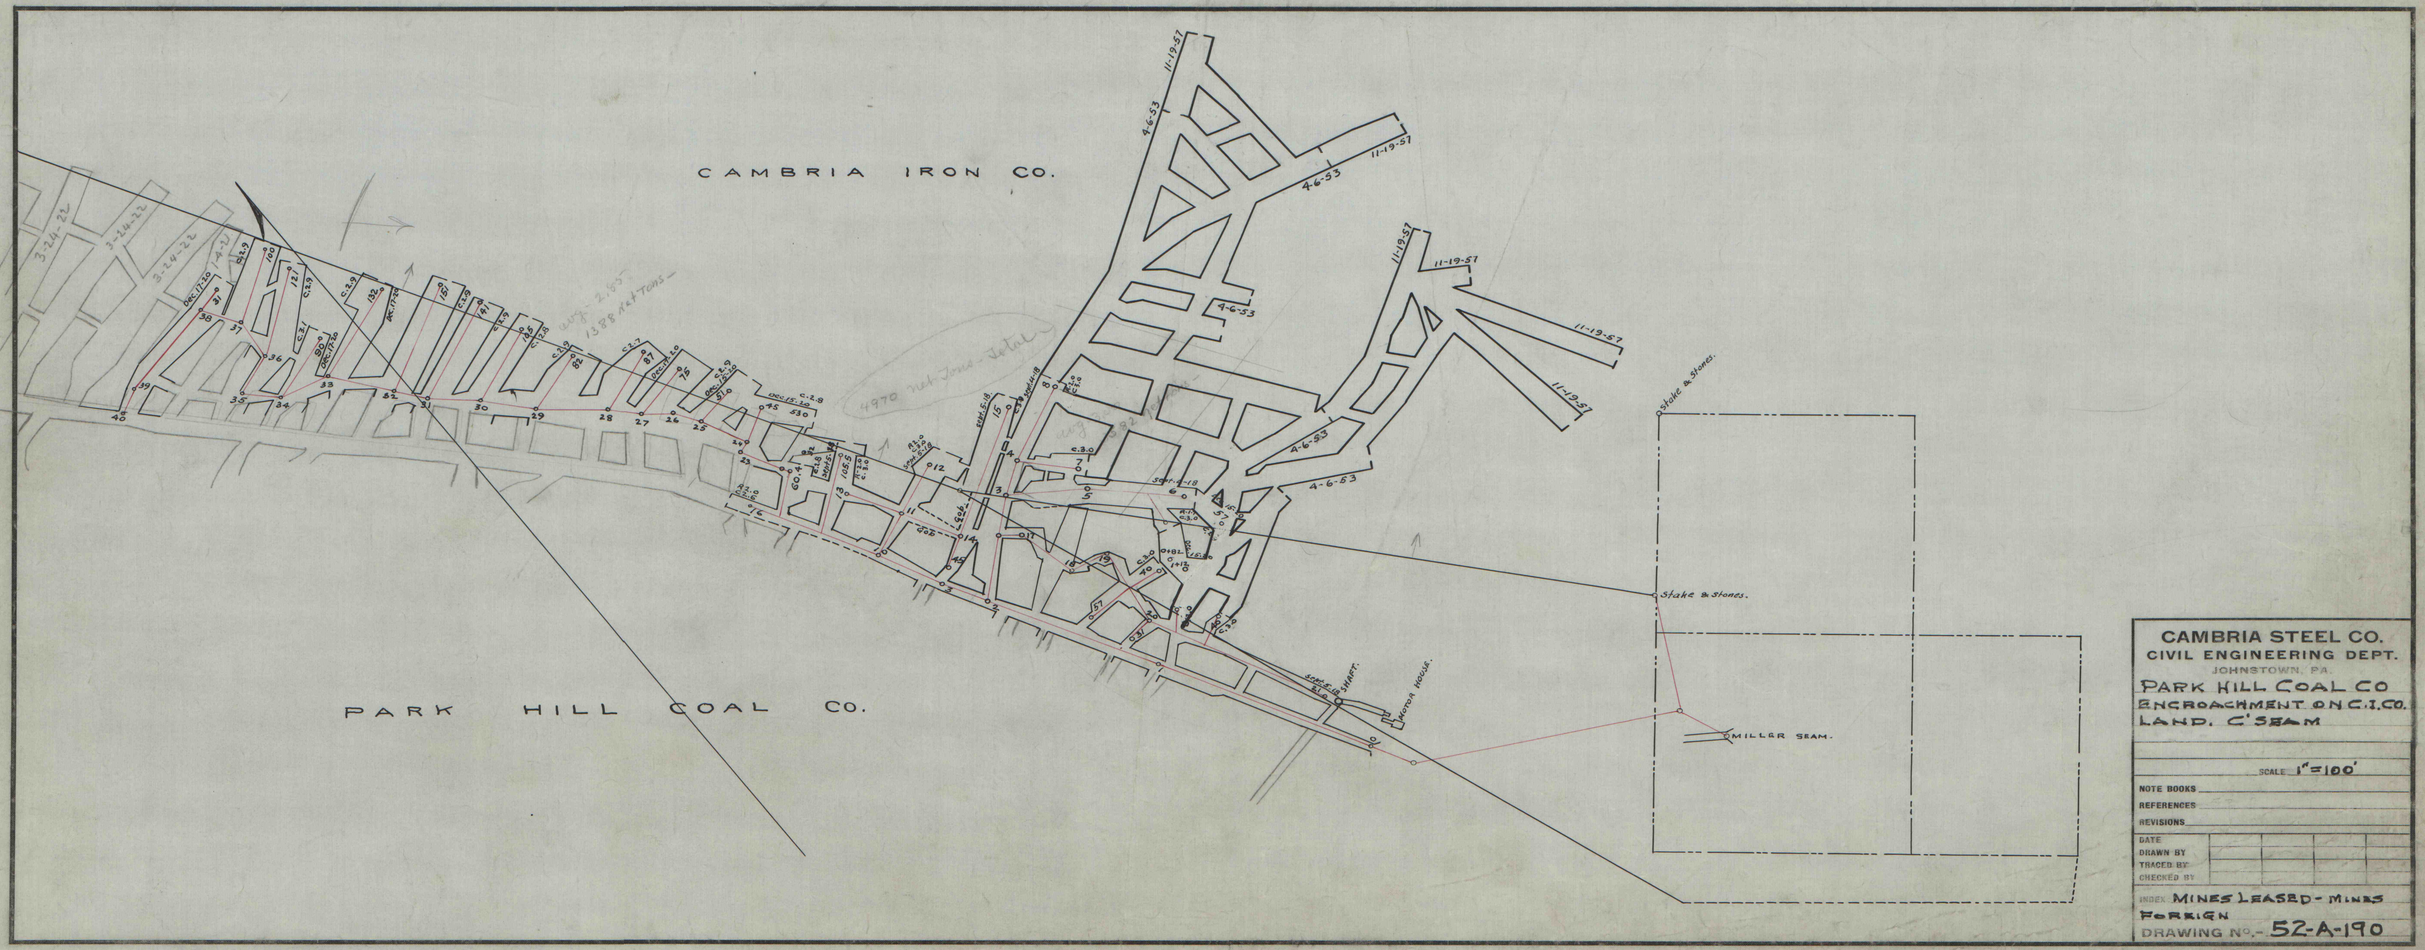


CAMBRIA STEEL CO.
CIVIL ENGINEERING DEPT.
JOHNSTOWN, PA.

PARK HILL COAL CO
ENCROACHMENT ON C.I.CO.
LAND. C' SEAM

SCALE 1" = 100'

NOTE BOOKS
REFERENCES
REVISIONS

| | | | | |
|---|---|---|---|---|
| DATE | | | | |
| DRAWN BY | | | | |
| TRACED BY | | | | |
| CHECKED BY | | | | |

INDEX MINES LEASED - MINES FOREIGN

DRAWING No.- 52-A-190

D-9

"VENUS" TRACING CLOTH
K. & E. CO., N. Y.