


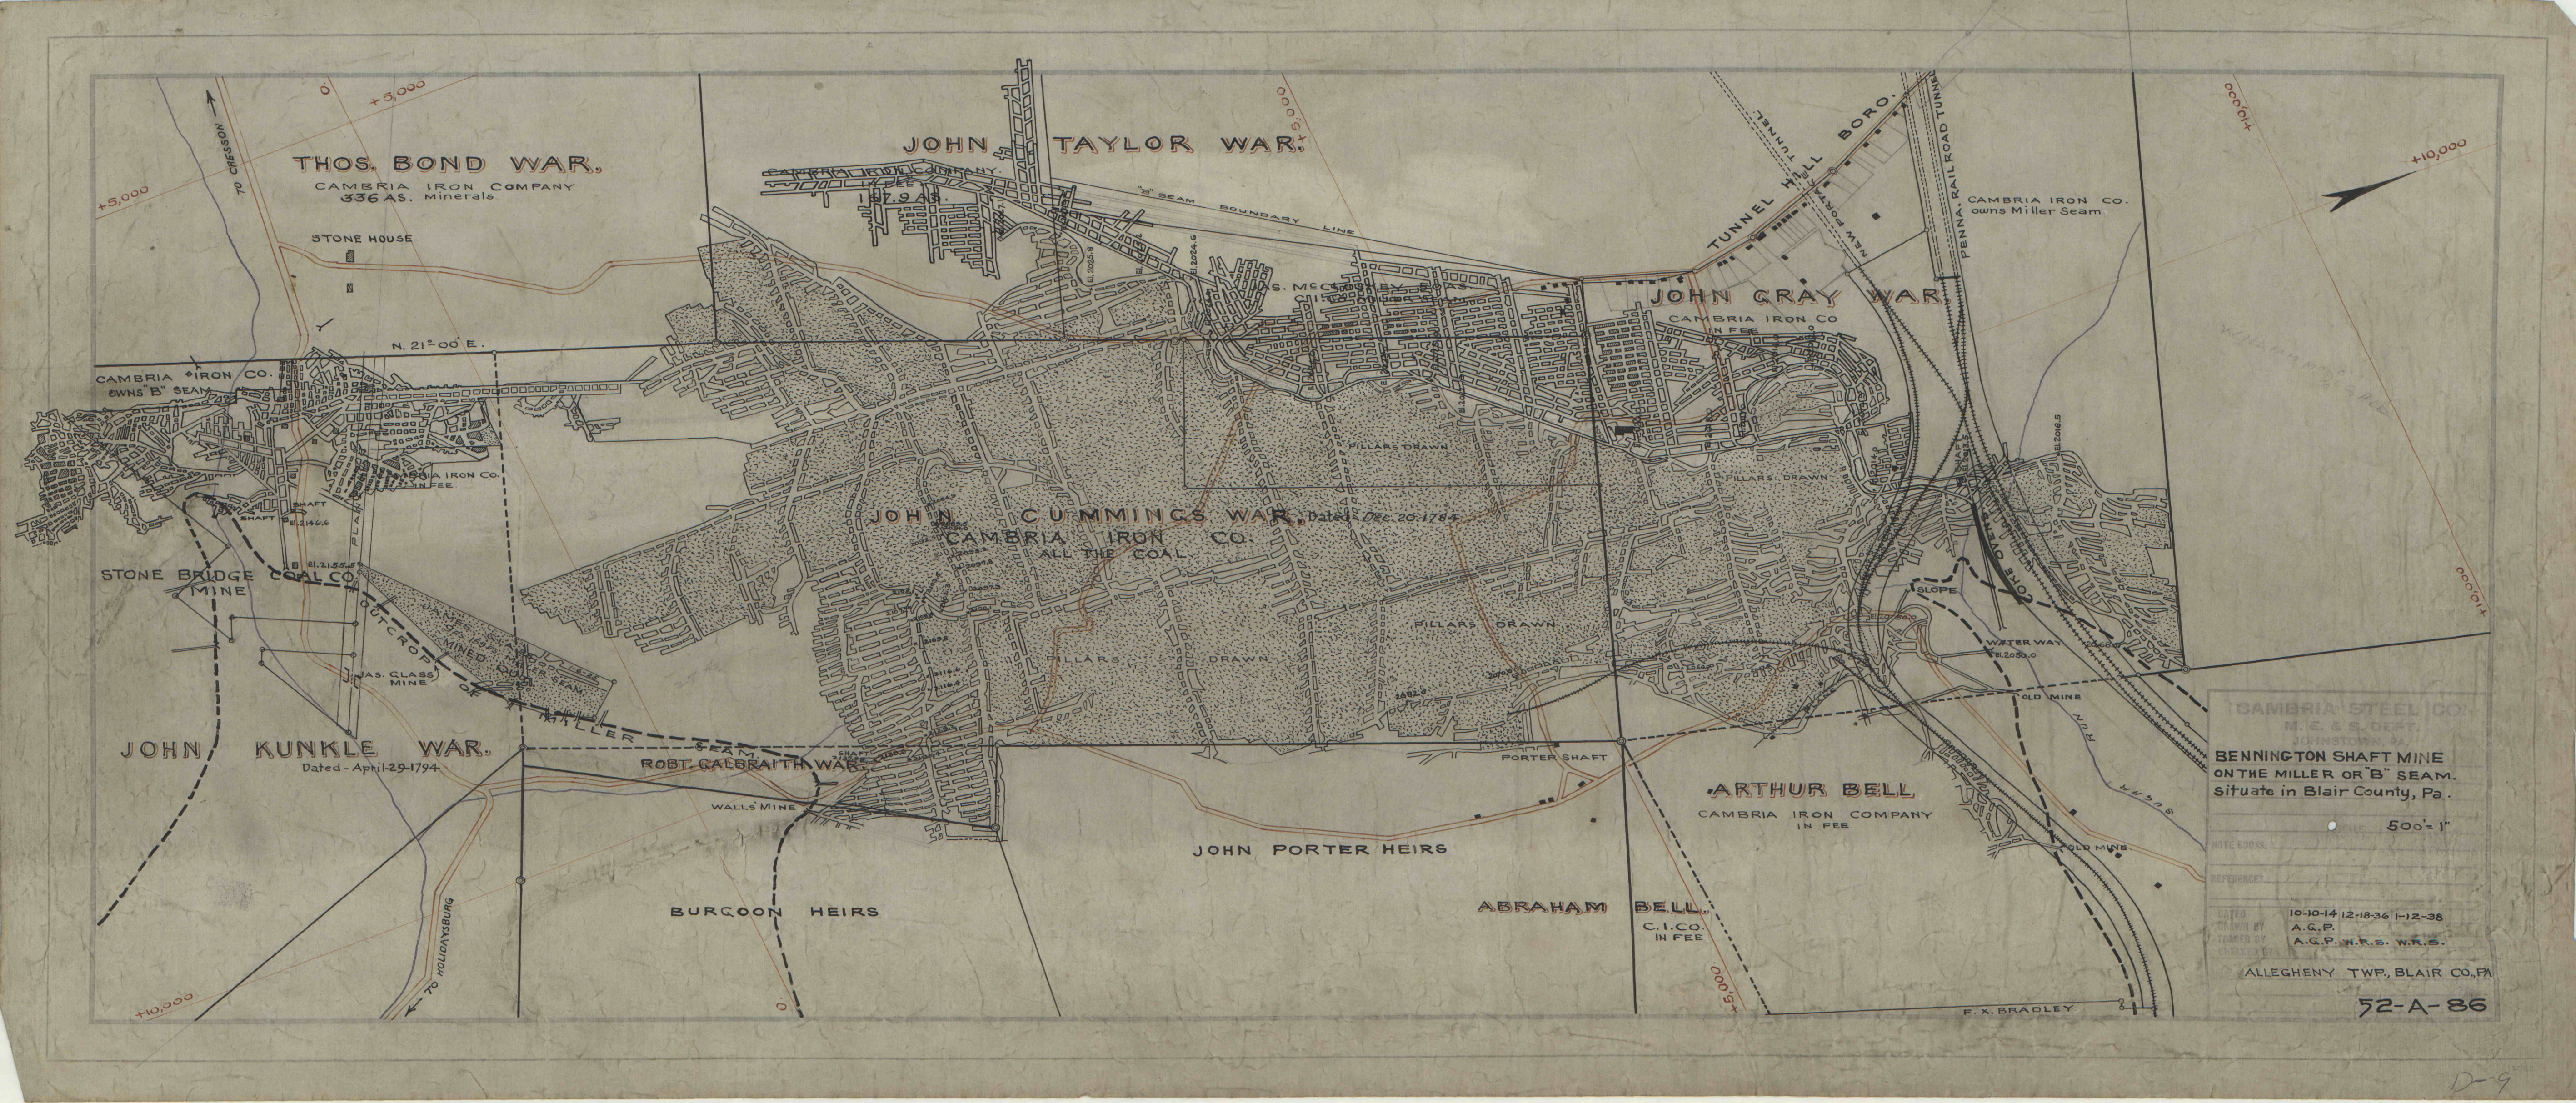

THOS. BOND WAR.

CAMBRIA IRON COMPANY
336 AS. Minerals

JOHN TAYLOR WAR

JOHN GRAY WAR

JOHN CUMMINGS WAR. Dated Dec. 20-1784

CAMBRIA IRON CO.
ALL THE COAL

JOHN KUNKLE WAR.
Dated - April-29-1794

ROBT. CALBRAITH WAR

JOHN PORTER HEIRS

ARTHUR BELL
CAMBRIA IRON COMPANY
IN FEE

ABRAHAM BELL
C.I. CO.
IN FEE

BURGOON HEIRS

CAMBRIA STEEL CO.
M. E. & S. DEPT.
JOHNSTOWN, PA.
BENNINGTON SHAFT MINE
ON THE MILLER OR "B" SEAM.
situate in Blair County, Pa.

500' = 1"

NOTE BOOKS.
REFERENCES.
DATED 10-10-14 12-18-36 1-12-38
DRAWN BY A.G.P.
CHECKED BY A.G.P. W.R.S. W.R.S.

ALLEGHENY TWP., BLAIR CO., PA

52-A-86