


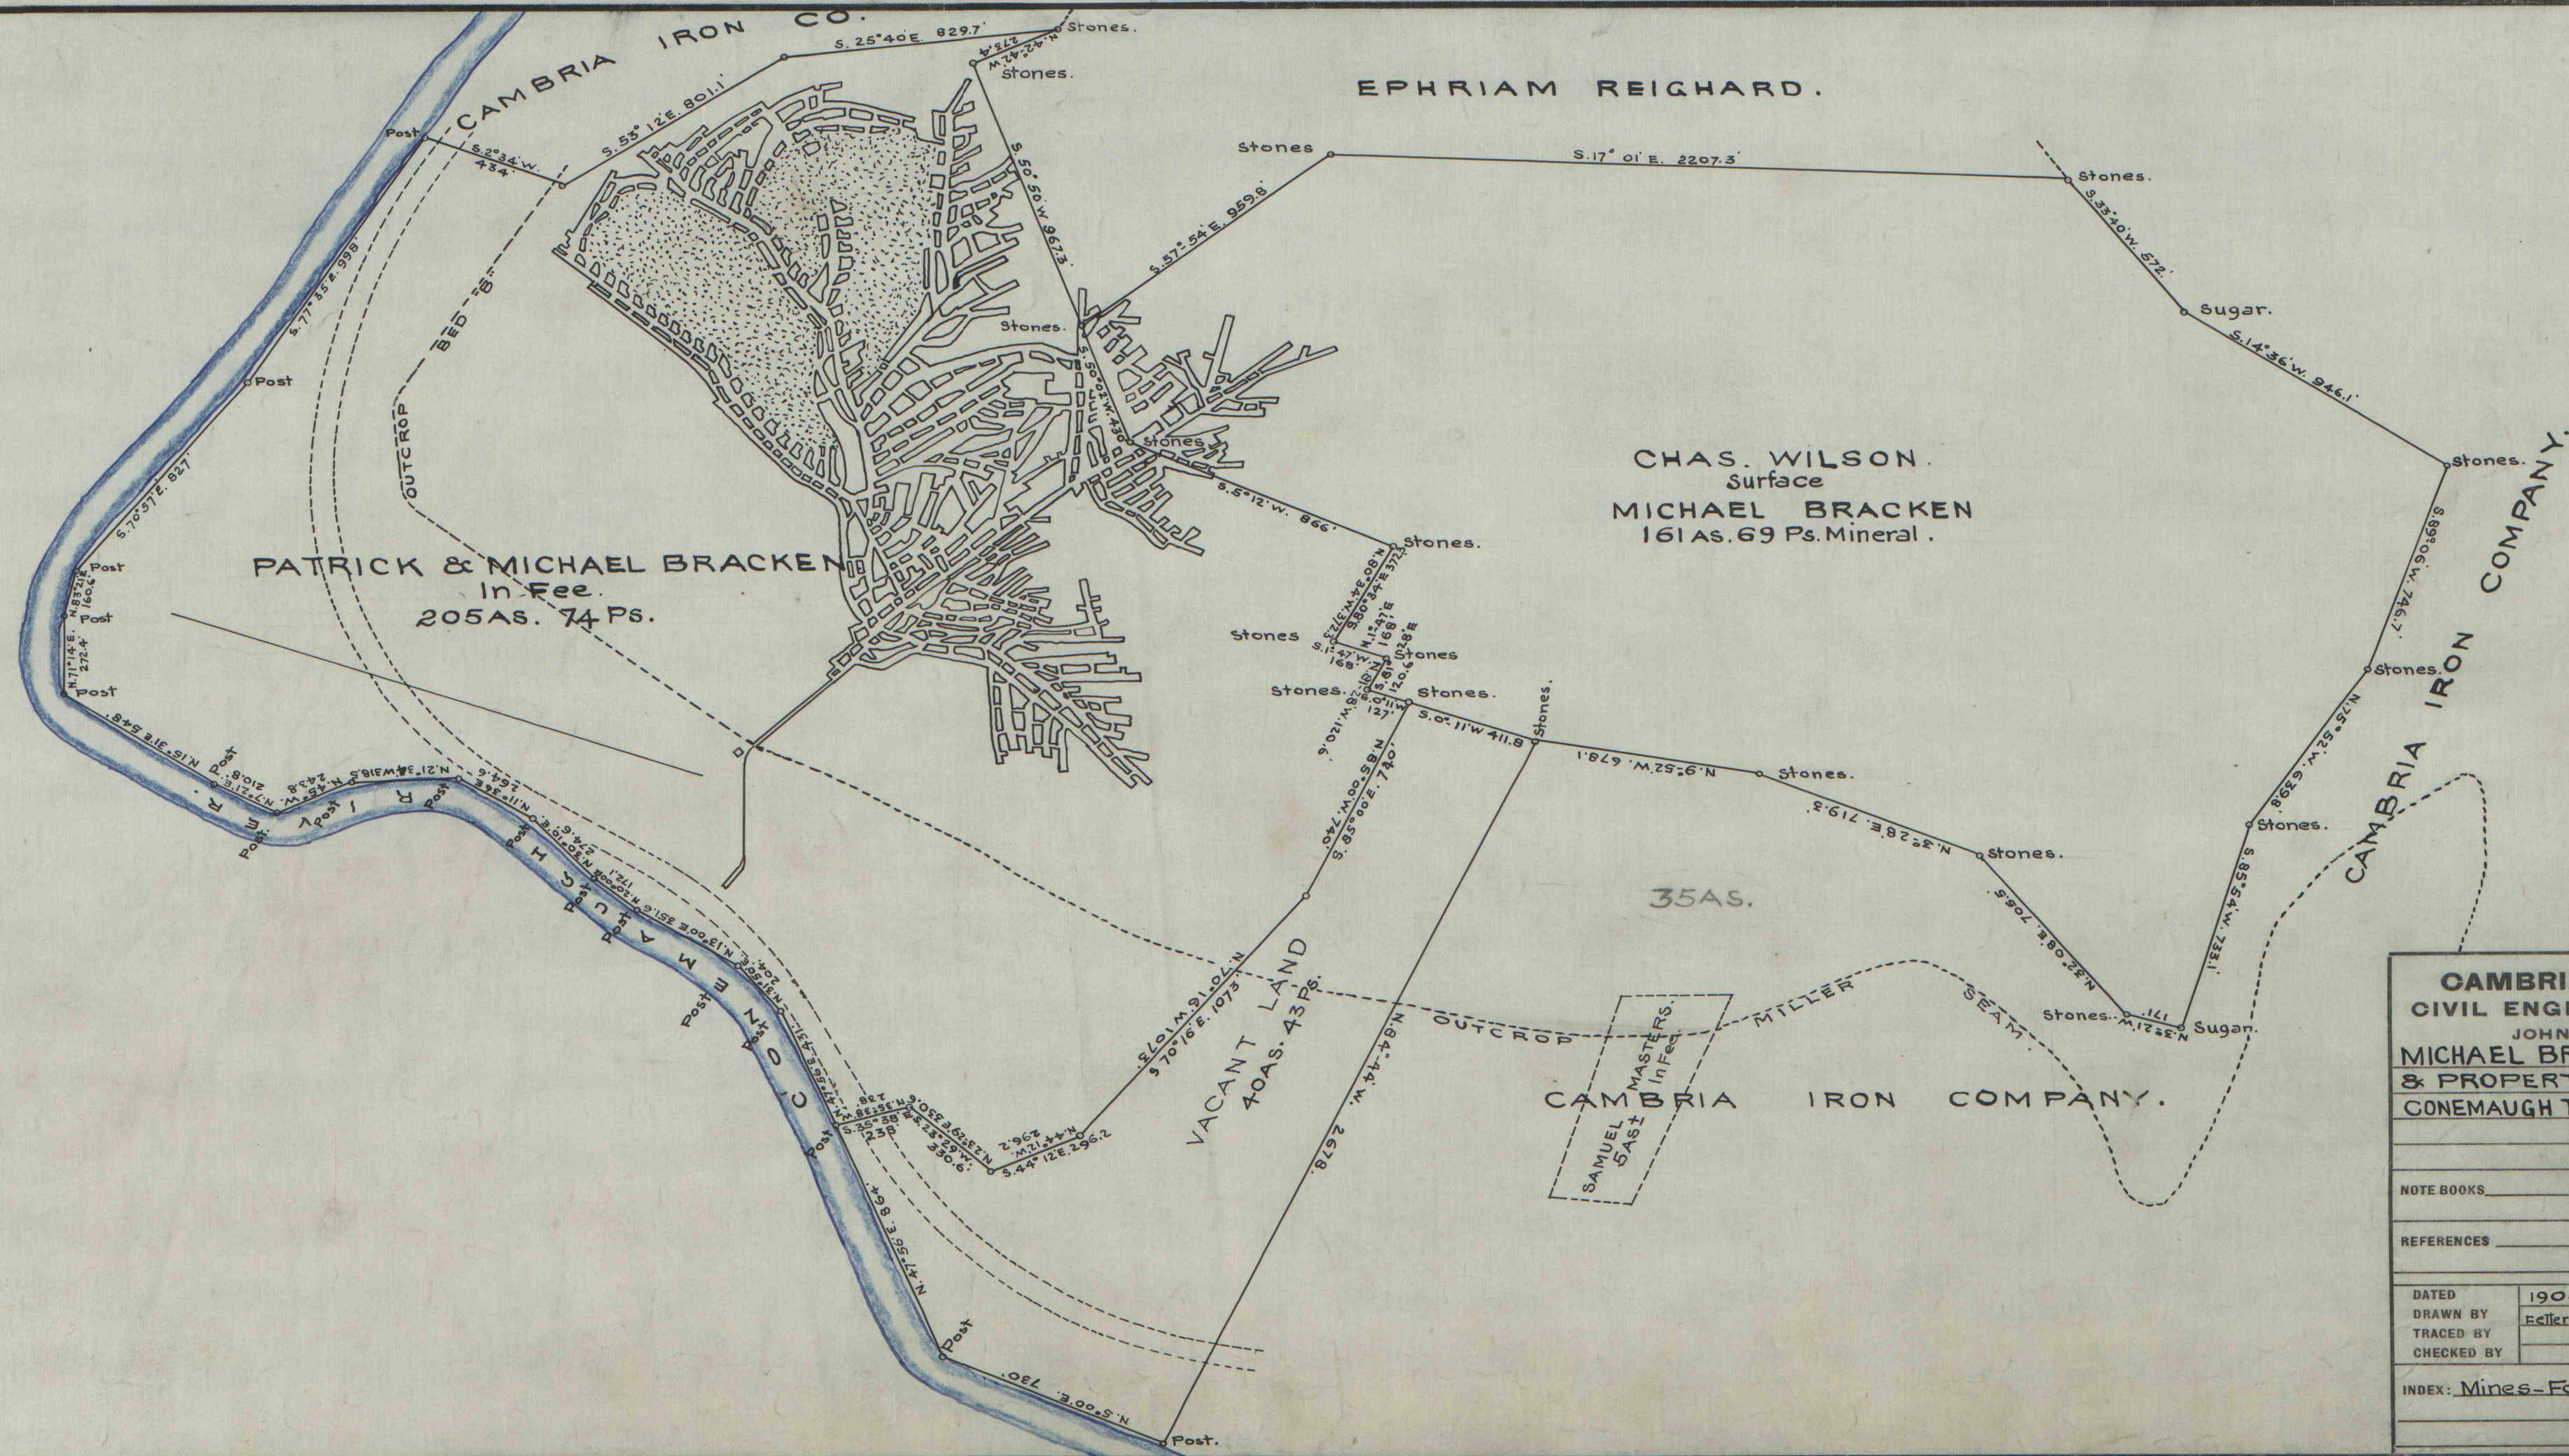

CAMBRIA STEEL CO.			
CIVIL ENGINEERING DEPT.			
JOHNSTOWN, PA.			
MICHAEL BRACKEN MINE.			
8 PROPERTIES		SITUATE	
CONEMAUGH TWP, CAMBRIA CO.			
SCALE 400' = 1"			
NOTE BOOKS			
REFERENCES			
DATED	1904	10-2-18	
DRAWN BY	Fellerman	Engr Co.	
TRACED BY		A.G.P.	
CHECKED BY			
INDEX: Mines- Foreign.			
52-A-191.			