


JOHN KUNKLE WARRANT.
CAMBRIA IRON COMPANY.
In fee.

THOS. BOND WARRANT
CAMBRIA IRON COMPANY
Minerals

CAMBRIA IRON CO.
Sells Miller Seam to
ADAM GLASS

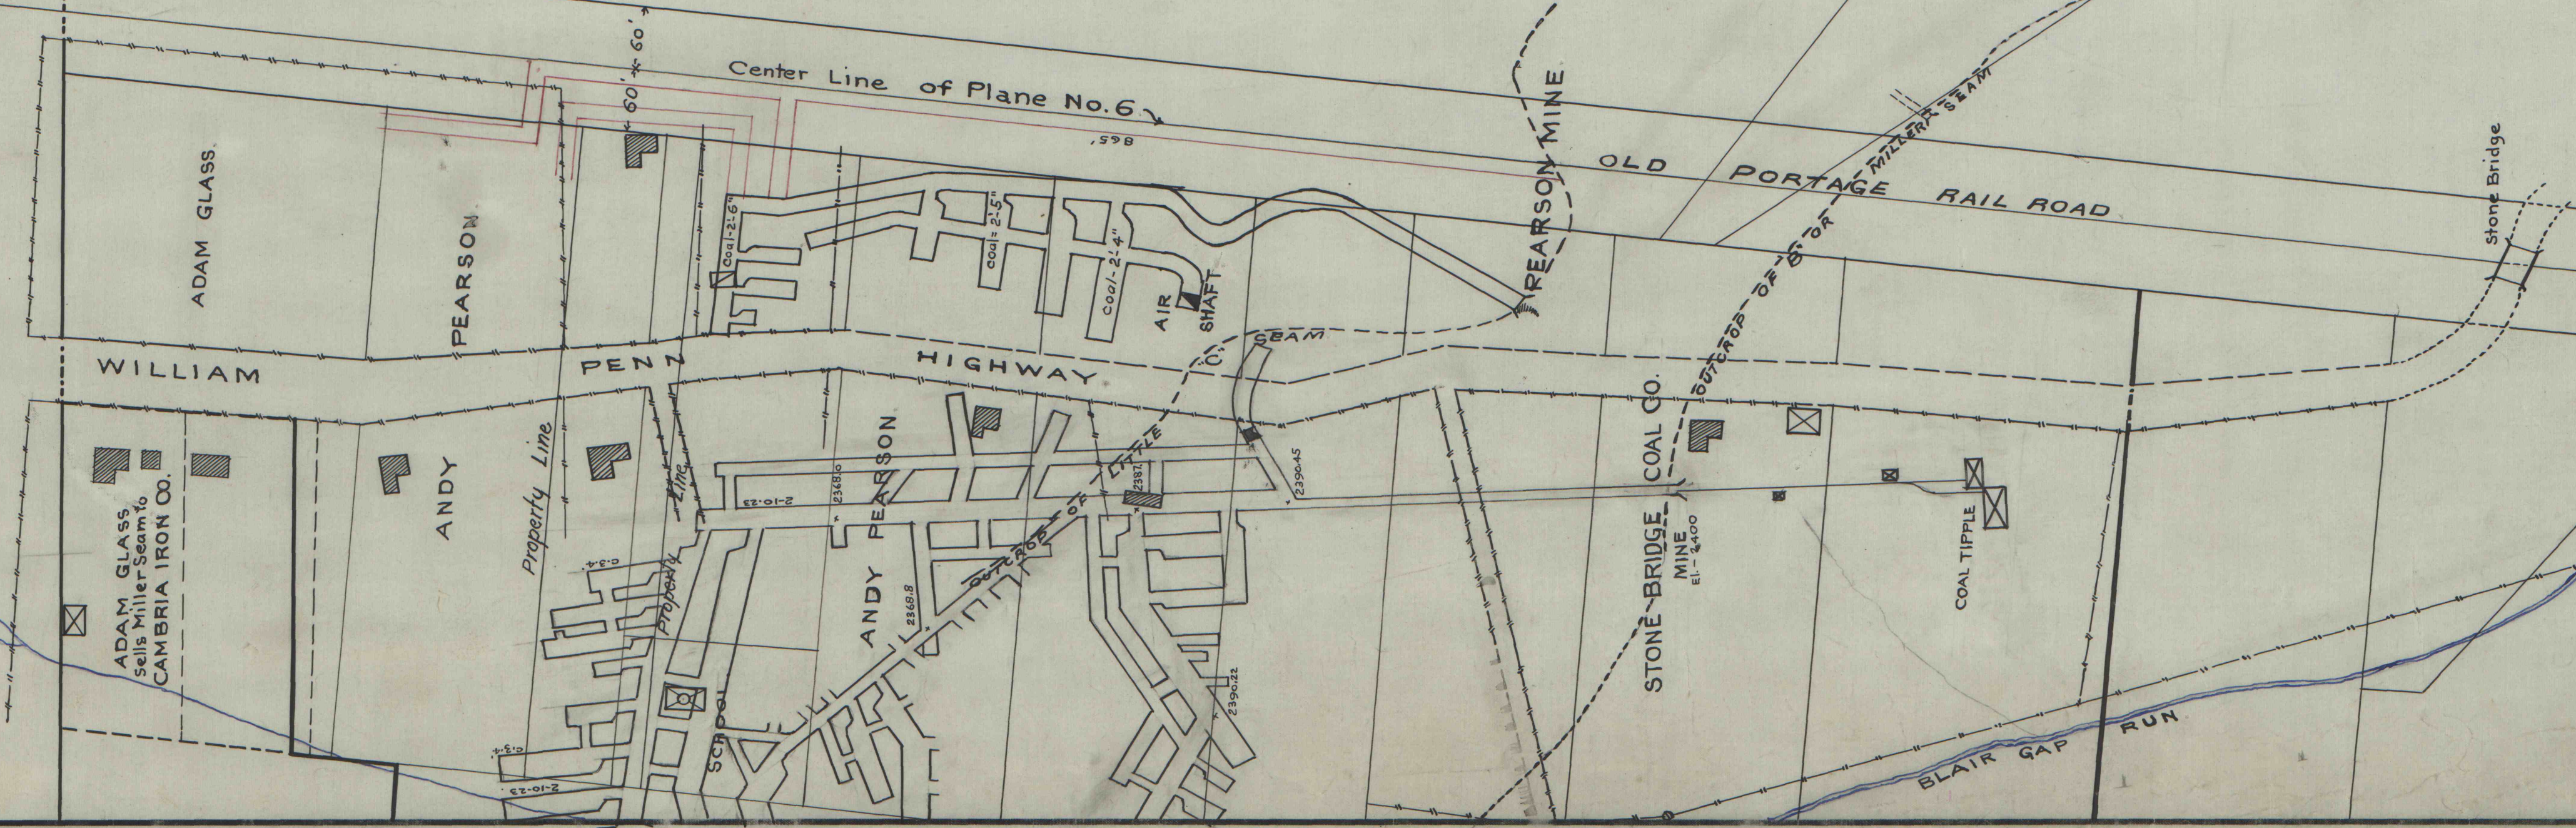

CAMBRIA STEEL CO.
CIVIL ENGINEERING DEPT.
JOHNSTOWN, PA.
ROCKTOWN
BLAIR COUNTY, PENNA.
PEARSON MINE
on the Little "C" Seam, or "B" Seam
Rider
SCALE 100' = 1"

NOTE BOOKS

REFERENCES

DATED	7-6-22		
DRAWN BY	A.C.P.		
TRACED BY	A.C.P.		
CHECKED BY			

INDEX: OTHER COAL MINES FOREIGN, BLAIR CO.
LANDS FOREIGN

52-A-219