


MAP
TO ACCOMPANY THE AGREEMENT
BETWEEN
BETHLEHEM STEEL COMPANY
AND
GEORGE W. GRIFFITH
SITUATE IN LOWER YODER TWP, CAMBRIA CO, PENNA.
SCALE 1"=100' MAY 27, 1946.

BATEY

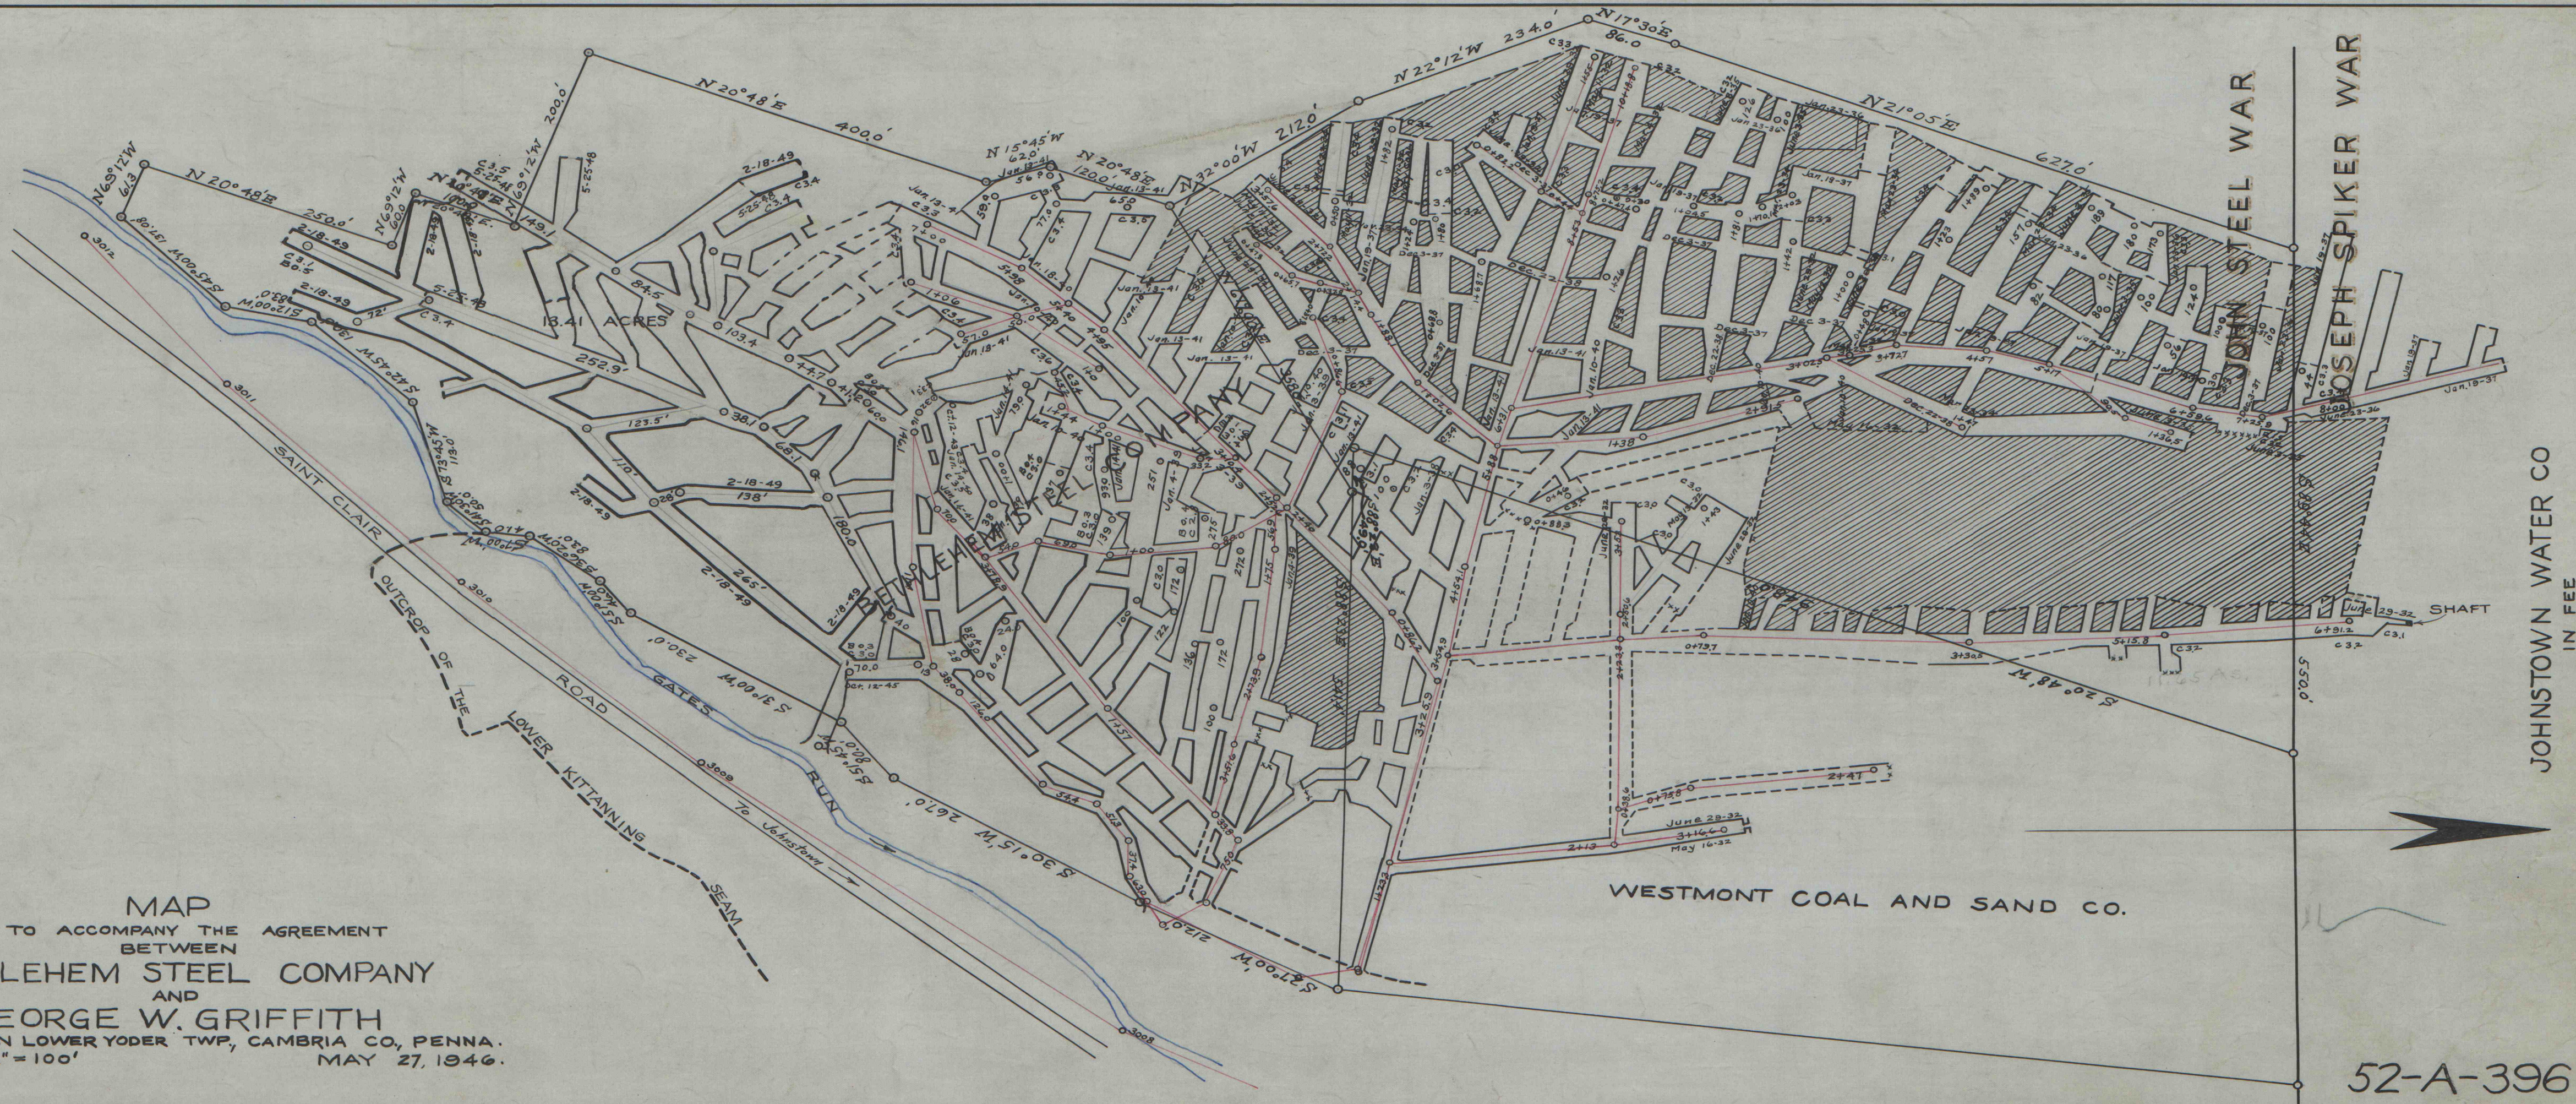

52-A-396

D-9