


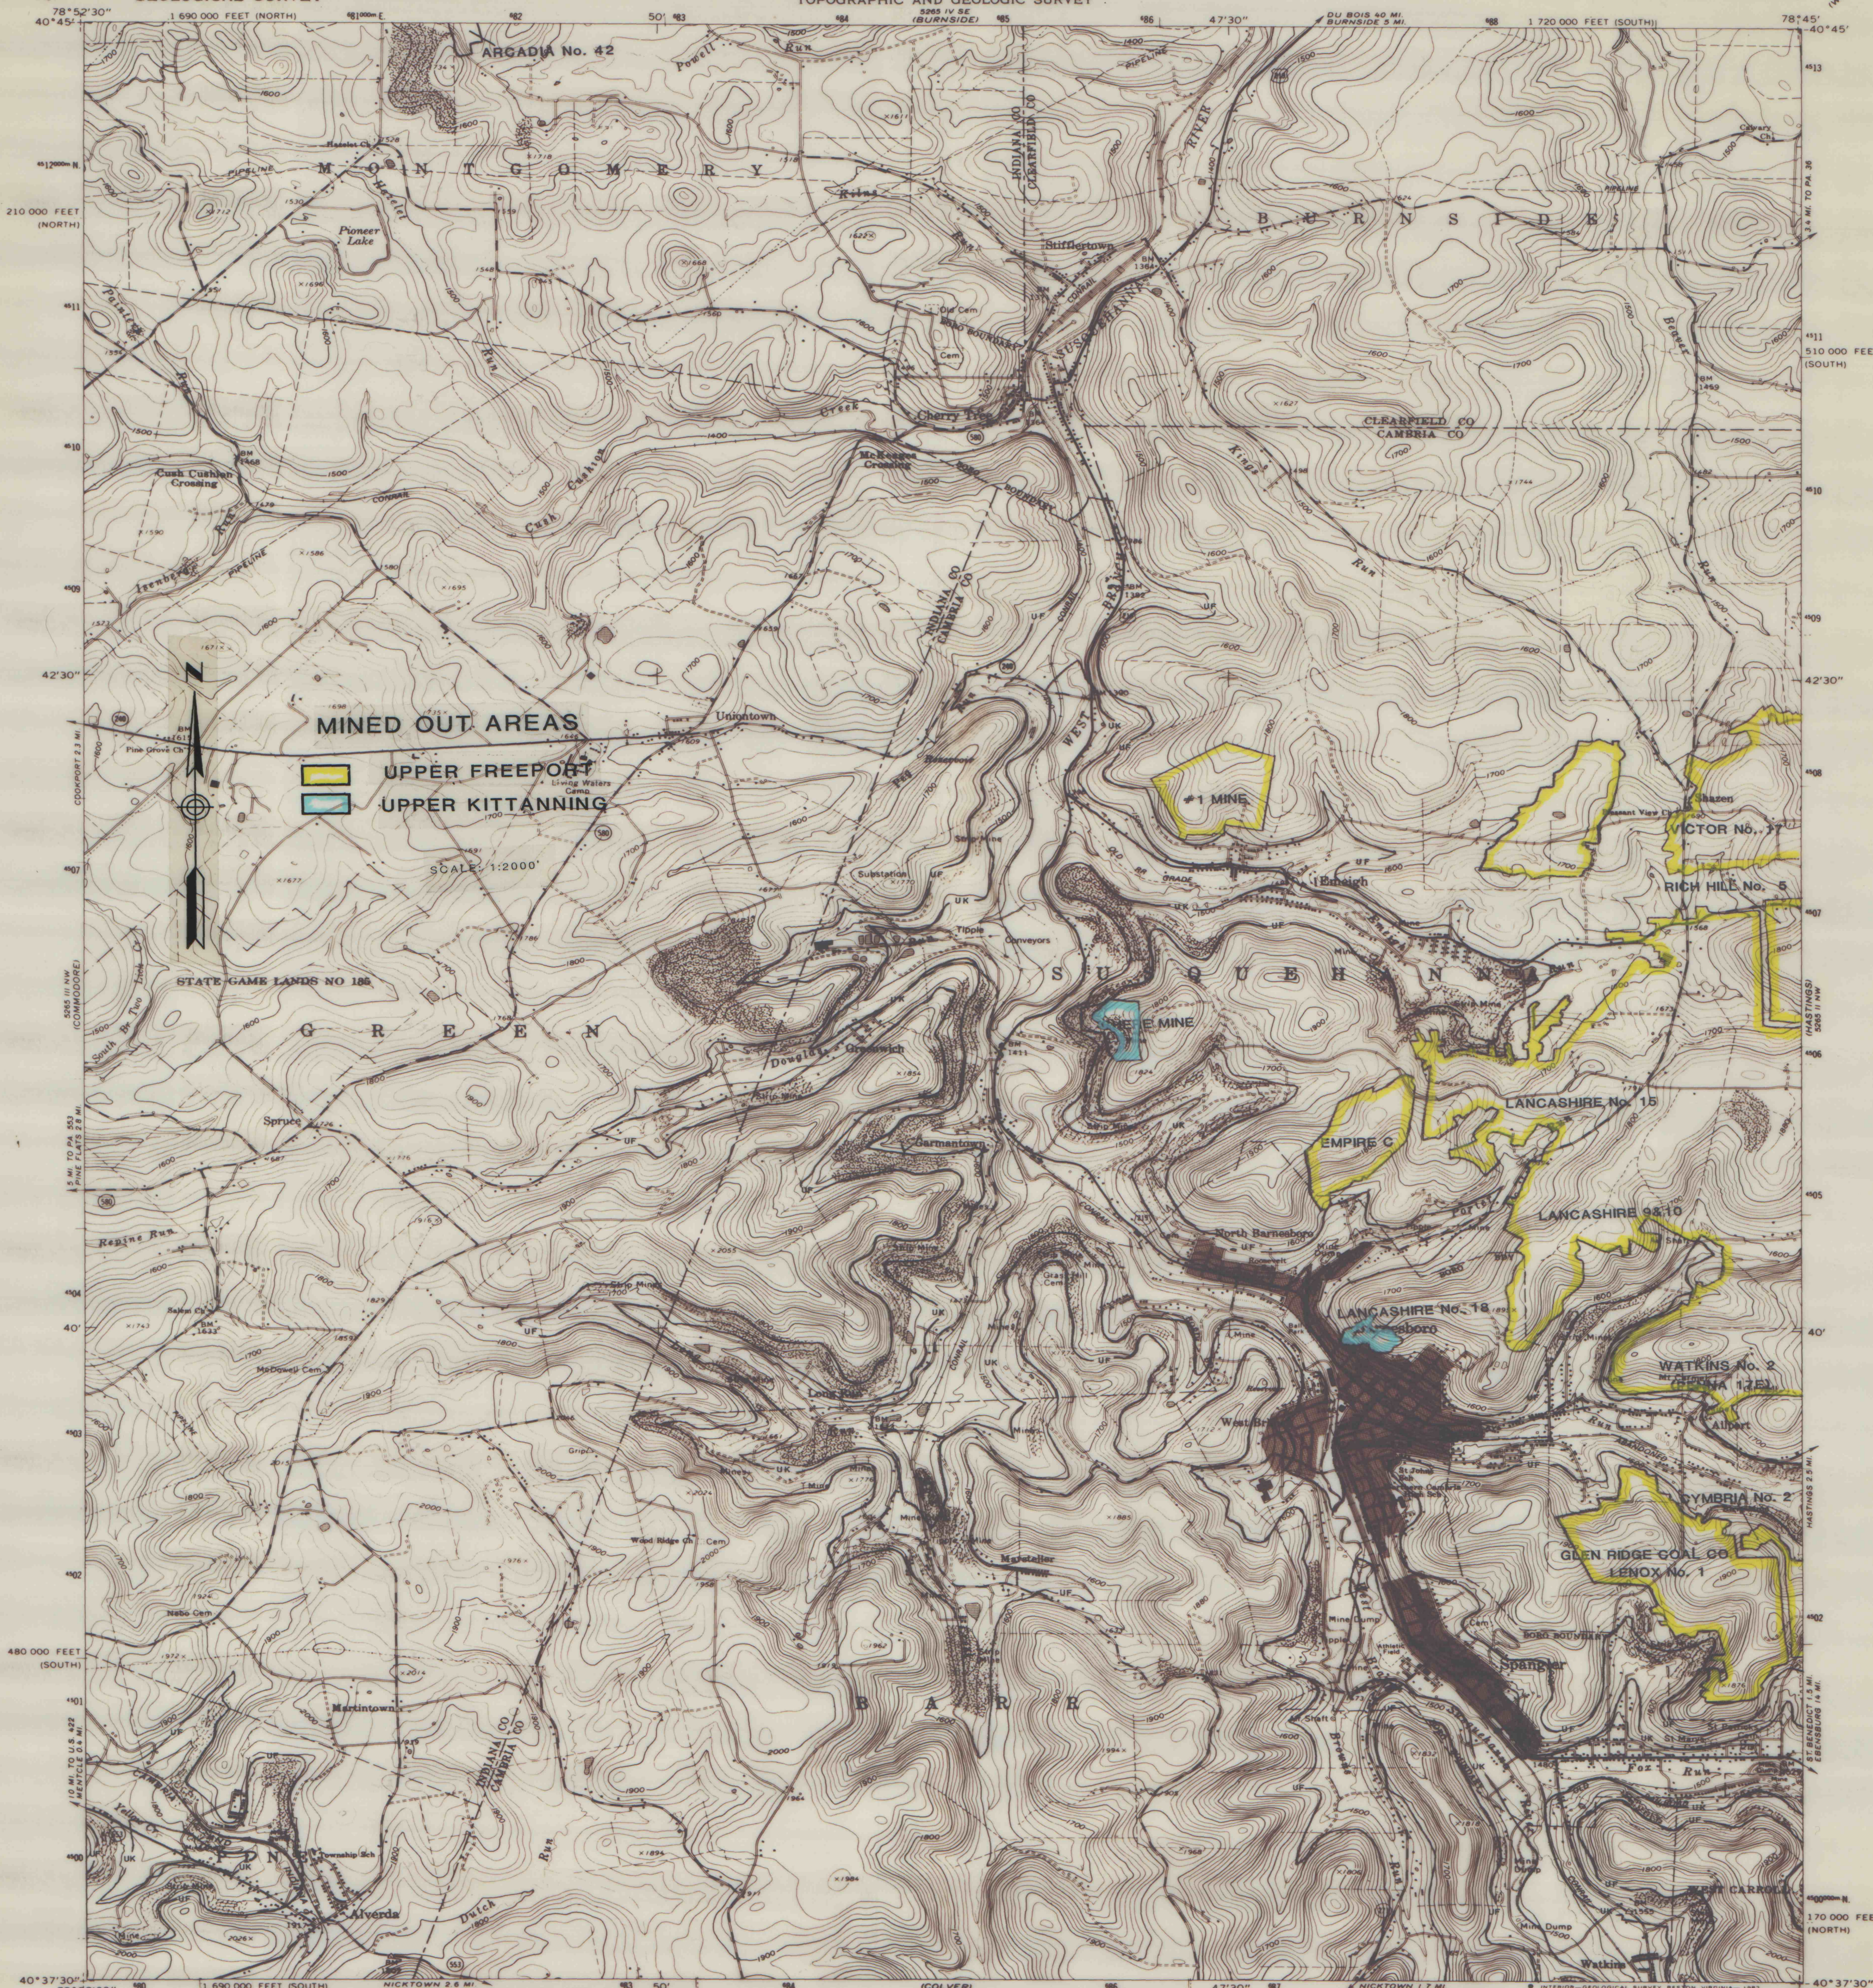

MINED OUT AREAS

- UPPER FREEPORT
- UPPER KITTANNING


SCALE 1:2000

SCALE 1:24,000

CONTOUR INTERVAL 20 FEET
NATIONAL GEODETIC VERTICAL DATUM OF 1929

- UPPER FREEPORT
- UPPER KITTANNING

- ROAD CLASSIFICATION
- Heavy-duty
- Light-duty
- Medium-duty
- Unimproved dirt
- U.S. Route
- State Route

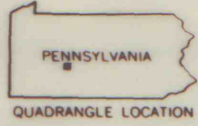

BARNESBORO, PA.

N4037.5—W7845/7.5

1961
PHOTOREVISED 1981
DMA 5285 III NE-SERIES V831

Mapped, edited, and published by the Geological Survey

Control by USGS and NOS/NOAA

Topography by photogrammetric methods from aerial photographs taken 1958. Field checked in 1961

Polycyclic projection, 10,000-foot grid ticks based on Pennsylvania coordinate system, south and north zones

1000-meter Universal Transverse Mercator grid ticks, zone 17, shown in blue, 1927 North American Datum

To place on the predicted North American Datum 1983 move the projection lines 4 meters south and 21 meters west as shown by dashed corner ticks

Fine red dashed lines indicate selected fence and field lines where generally visible on aerial photographs. This information is unchecked

Red tint indicates areas in which only landmark buildings are shown

There may be private inholdings within the boundaries of the National or State reservations shown on this map

THIS MAP COMPLIES WITH NATIONAL MAP ACCURACY STANDARDS
FOR SALE BY U.S. GEOLOGICAL SURVEY, RESTON, VIRGINIA 22092
A FOLDER DESCRIBING TOPOGRAPHIC MAPS AND SYMBOLS IS AVAILABLE ON REQUEST

IMAPS # 10991