


Rochester & Pittsburgh Coal Co.
PYRRA # 1
UPPER FREEPORT (E) SEAM
ASH % (MINEABLE SEAM)

Legend

- DIAMOND DRILL HOLE
- AIR DRILL HOLE
- SE SURFACE ELEVATION
- CHANNLED
- ISOPACH LINE

JLC/JKS SCALE 1"=400' 6/78

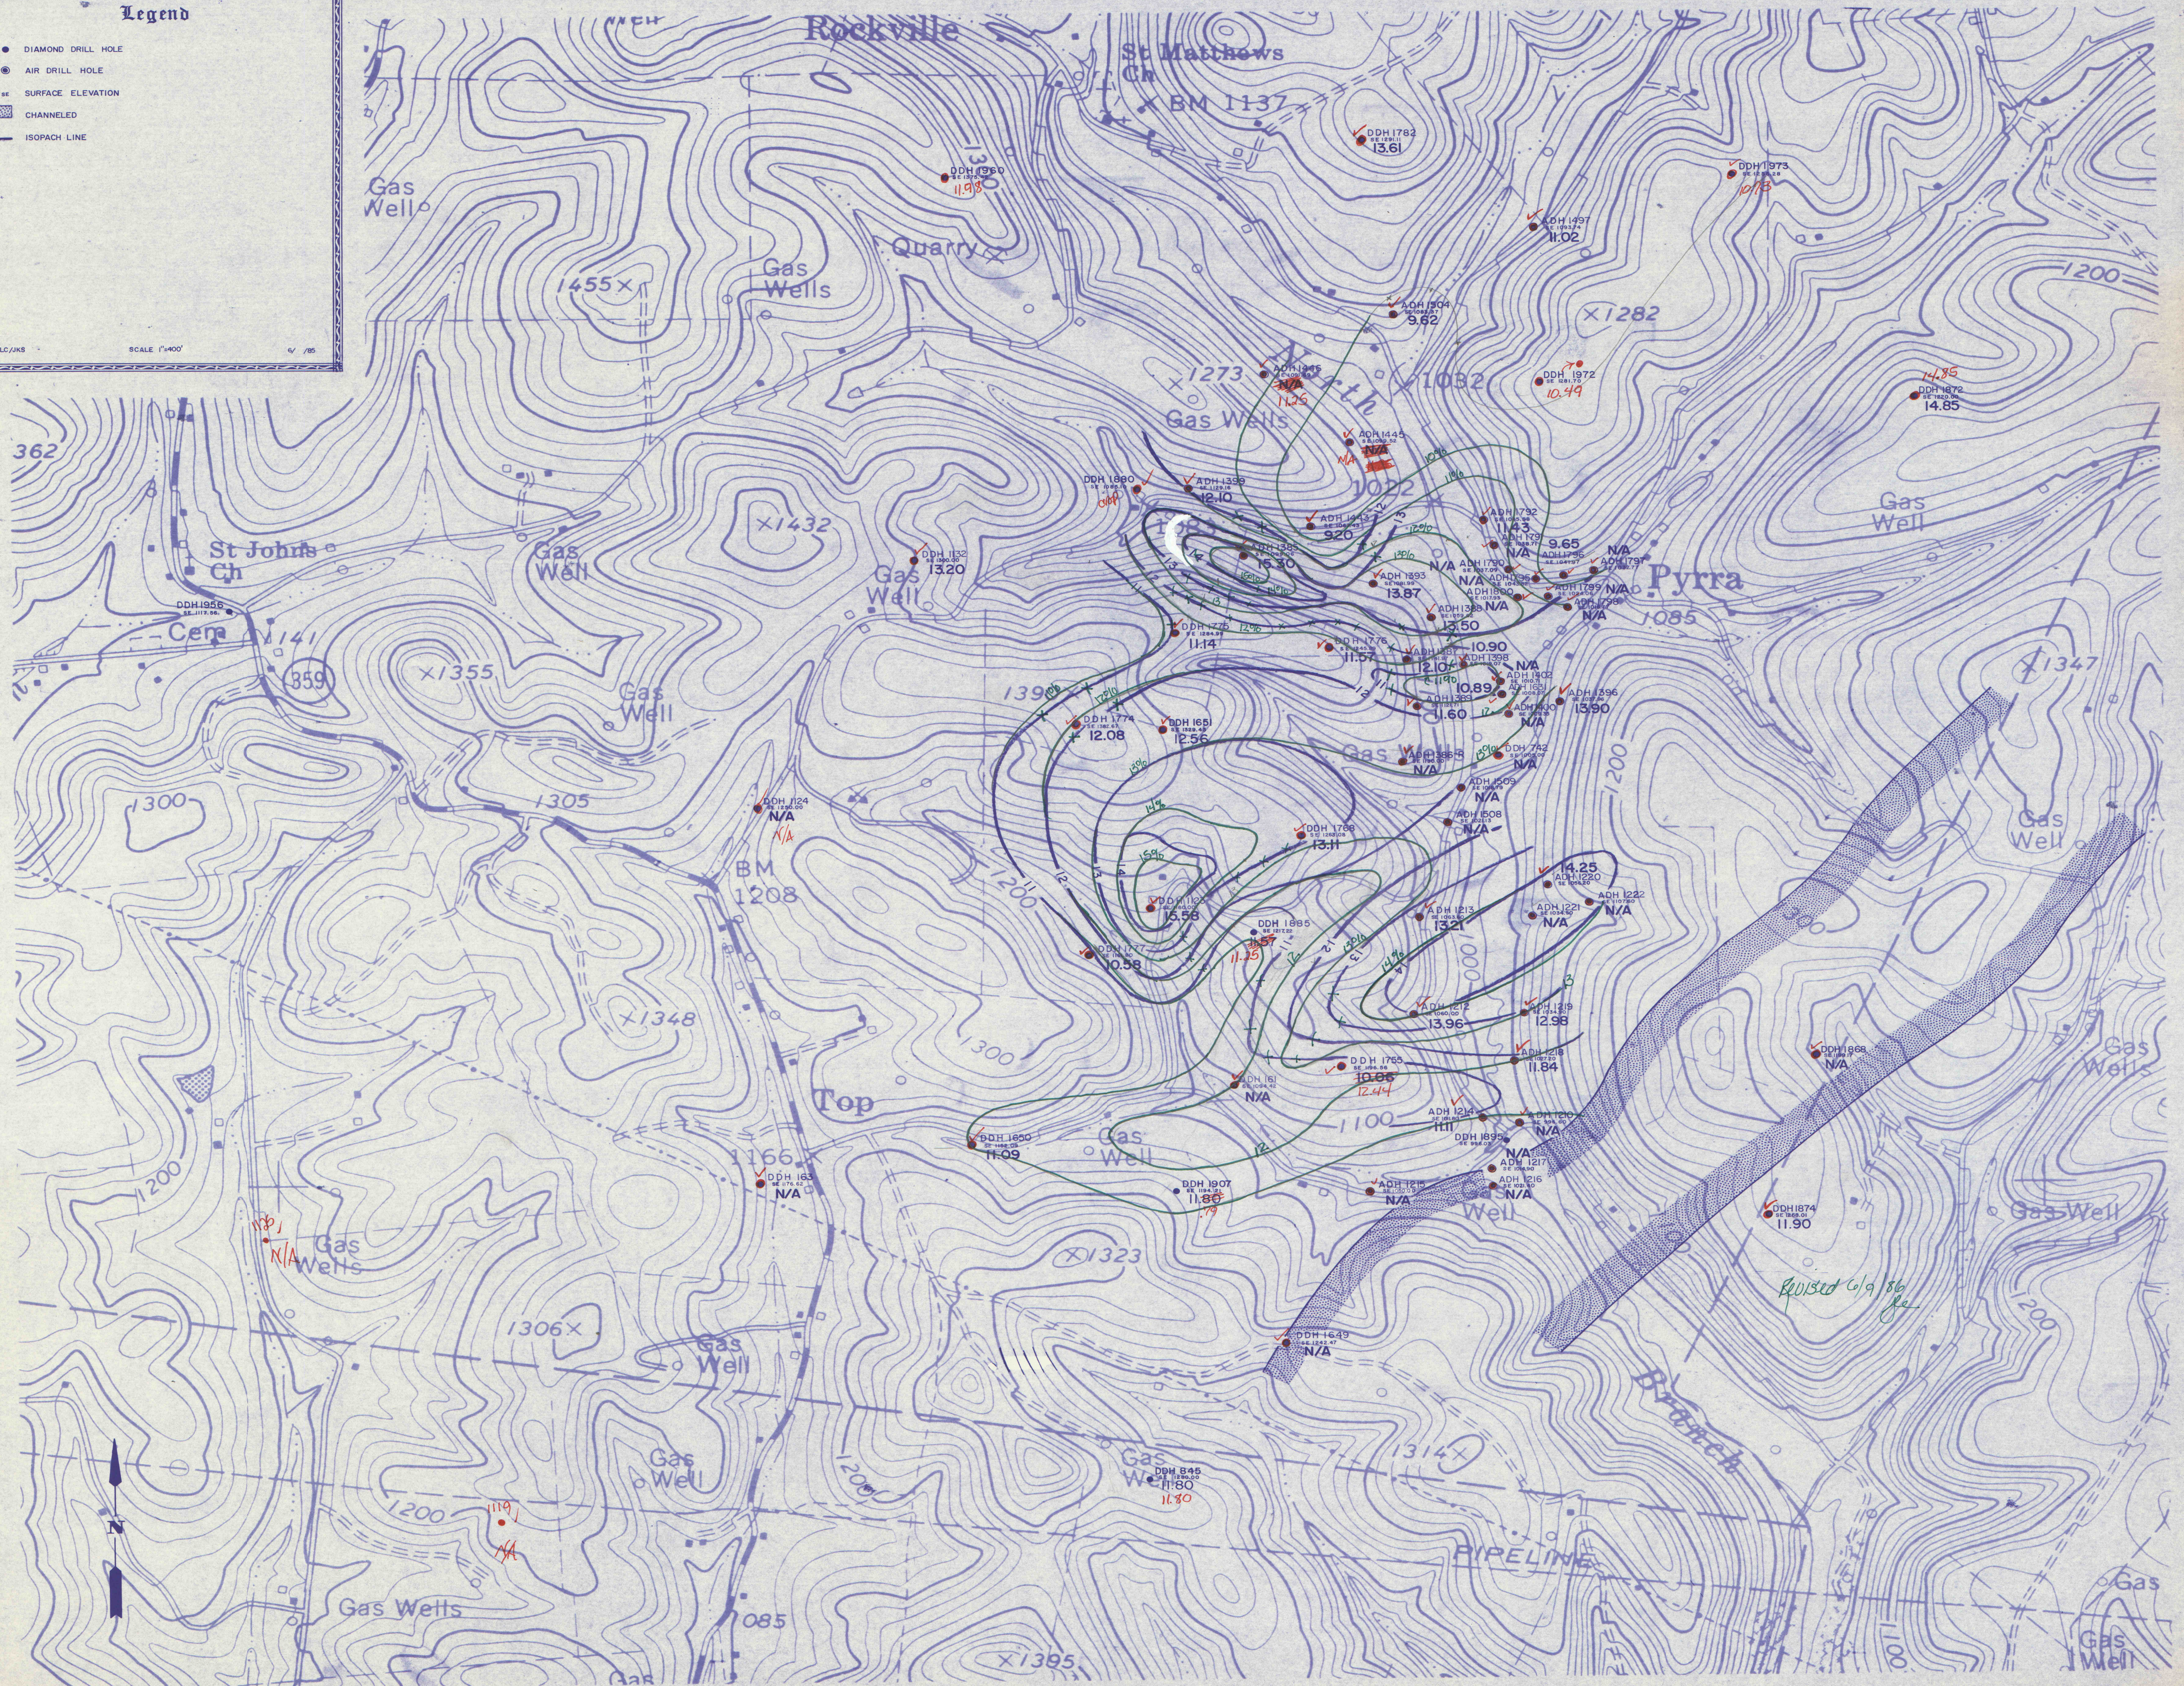

Revised 6/9/86