


PYRRA # 1

Legend

JLC/JKS SCALE 1"=1000' 6/ /85

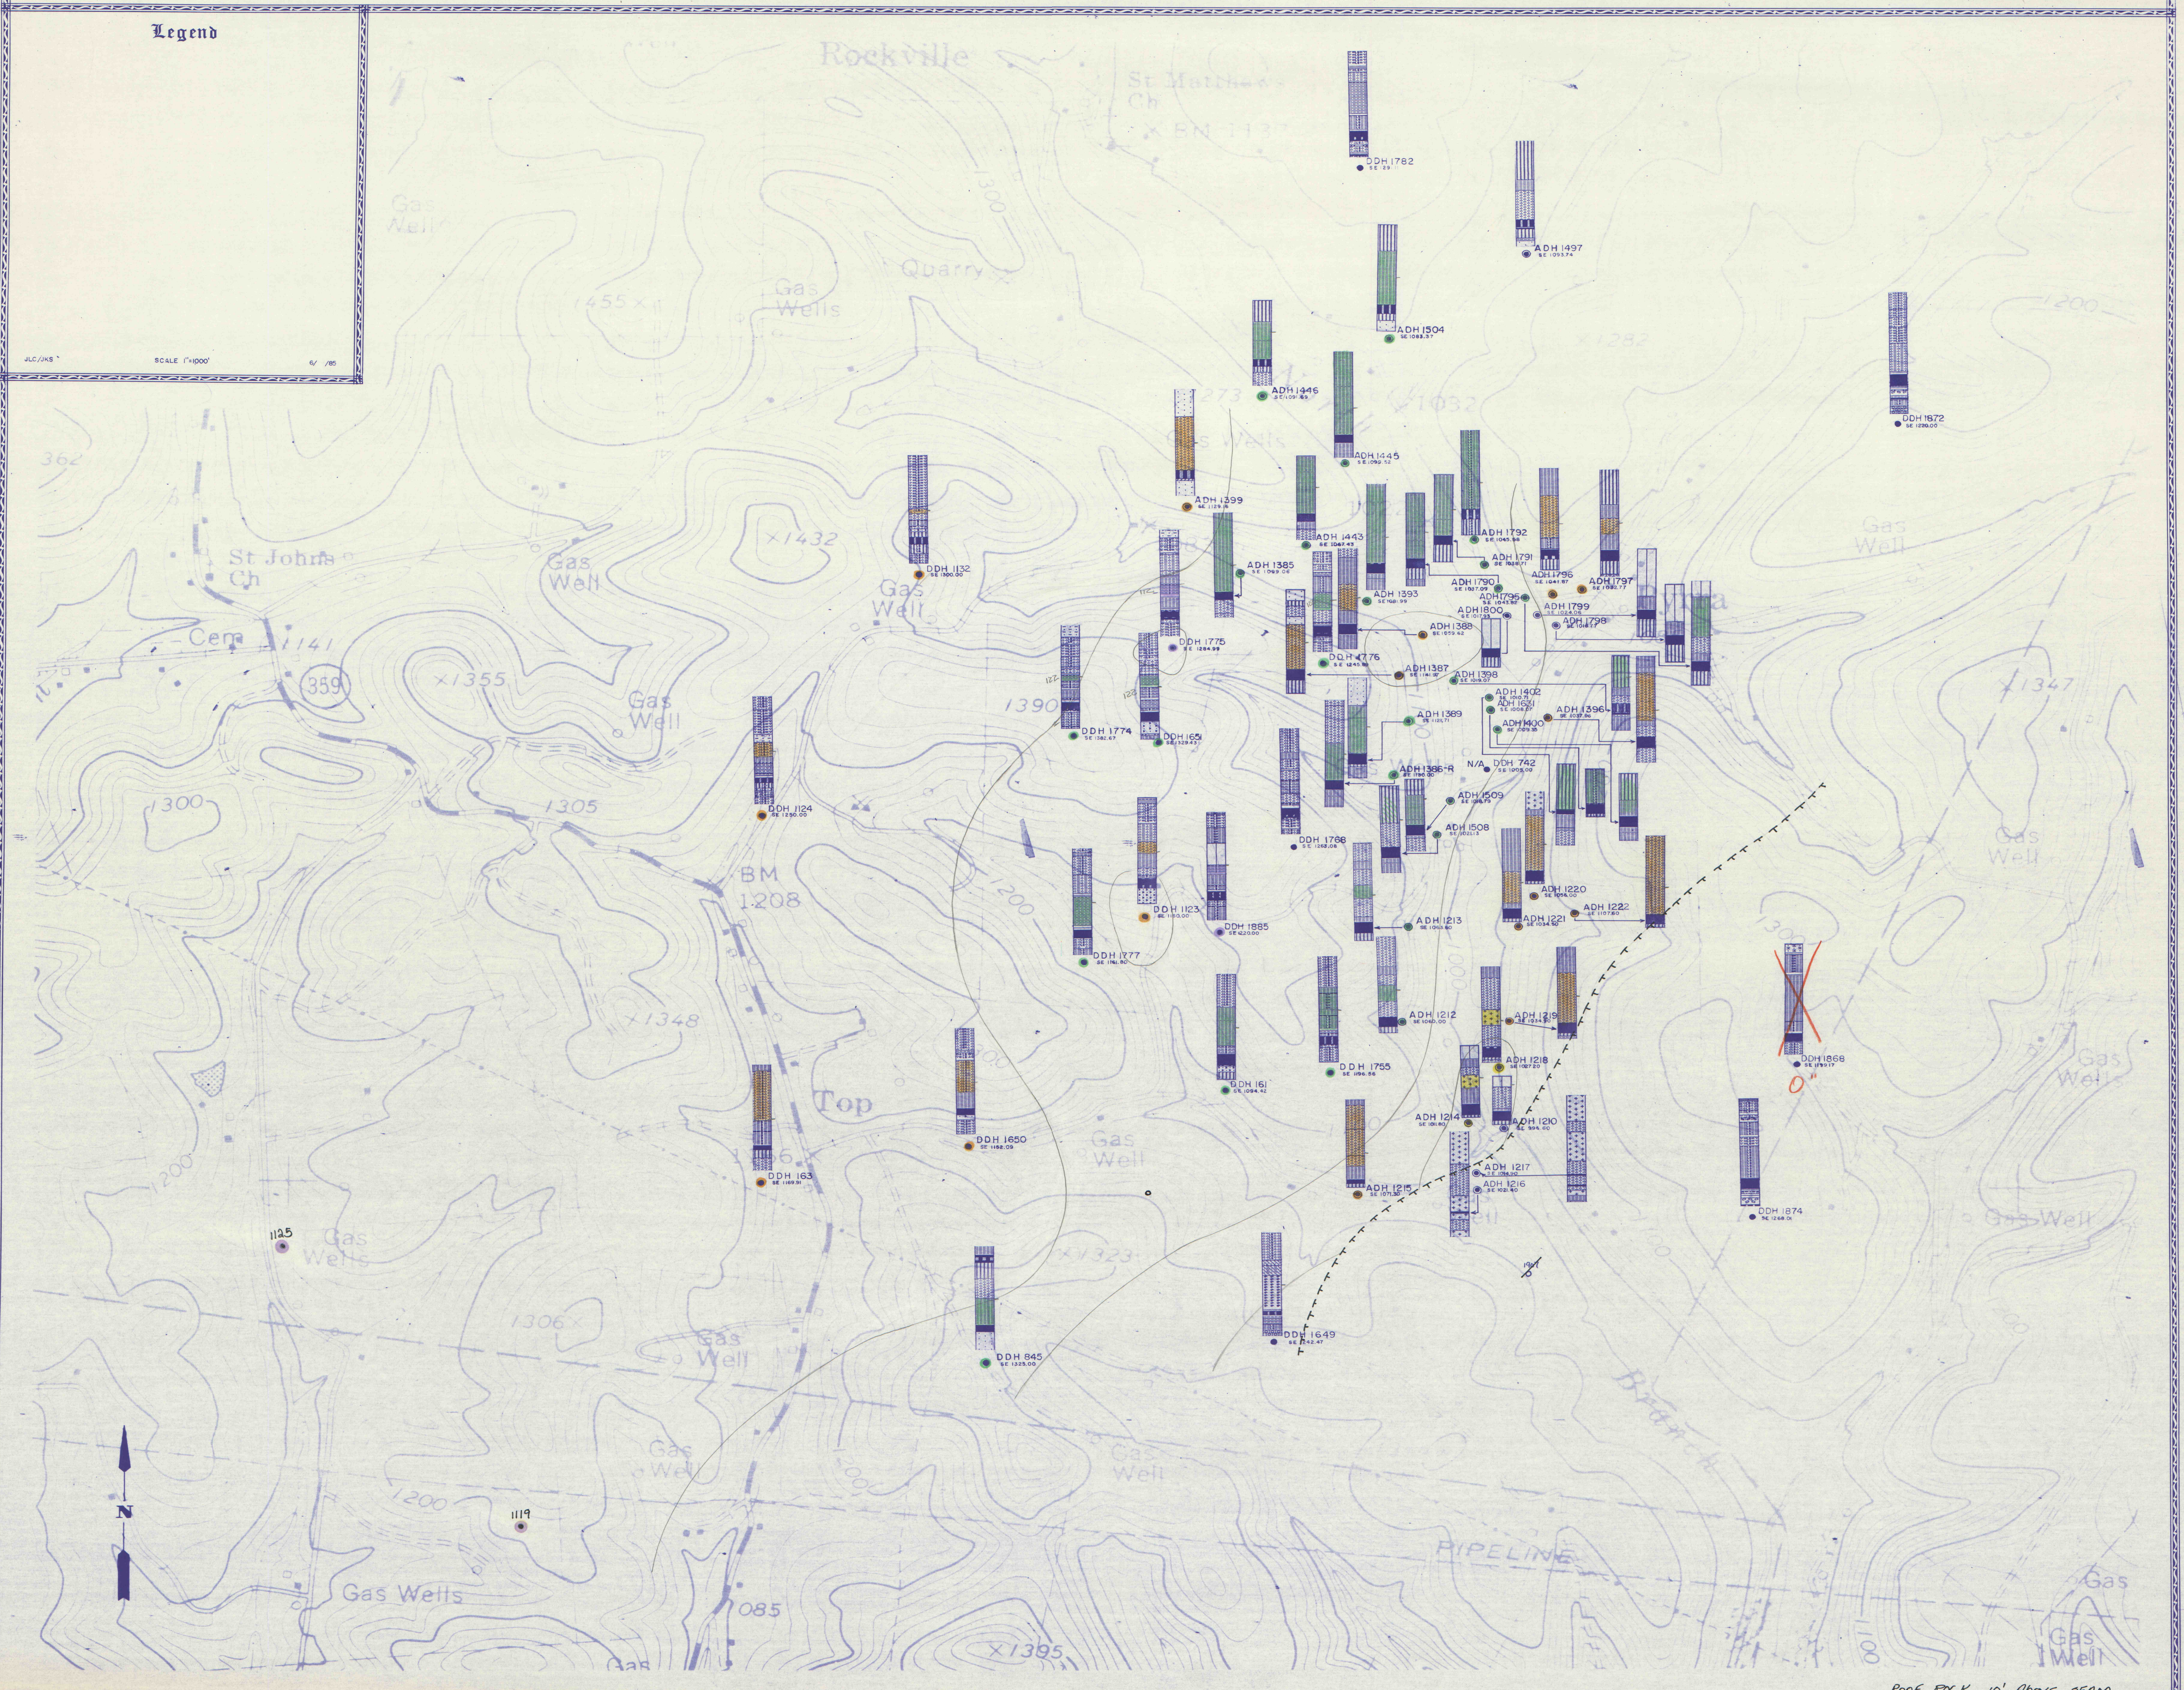

ROOF ROCK 10' ABOVE SEAM

IMAPS#11168