

Rochester & Pittsburgh Coal Co.
PYRRA #1
UPPER FREEPORT (E) SEAM
STRUCTURAL CONTOUR


Legend

- DIAMOND DRILL HOLE
- AIR DRILL HOLE
- SE SURFACE ELEVATION
- CH CHanneled
- ISOPACH LINE

JLC/JSK

SCALE 1"=400'

6/7/85

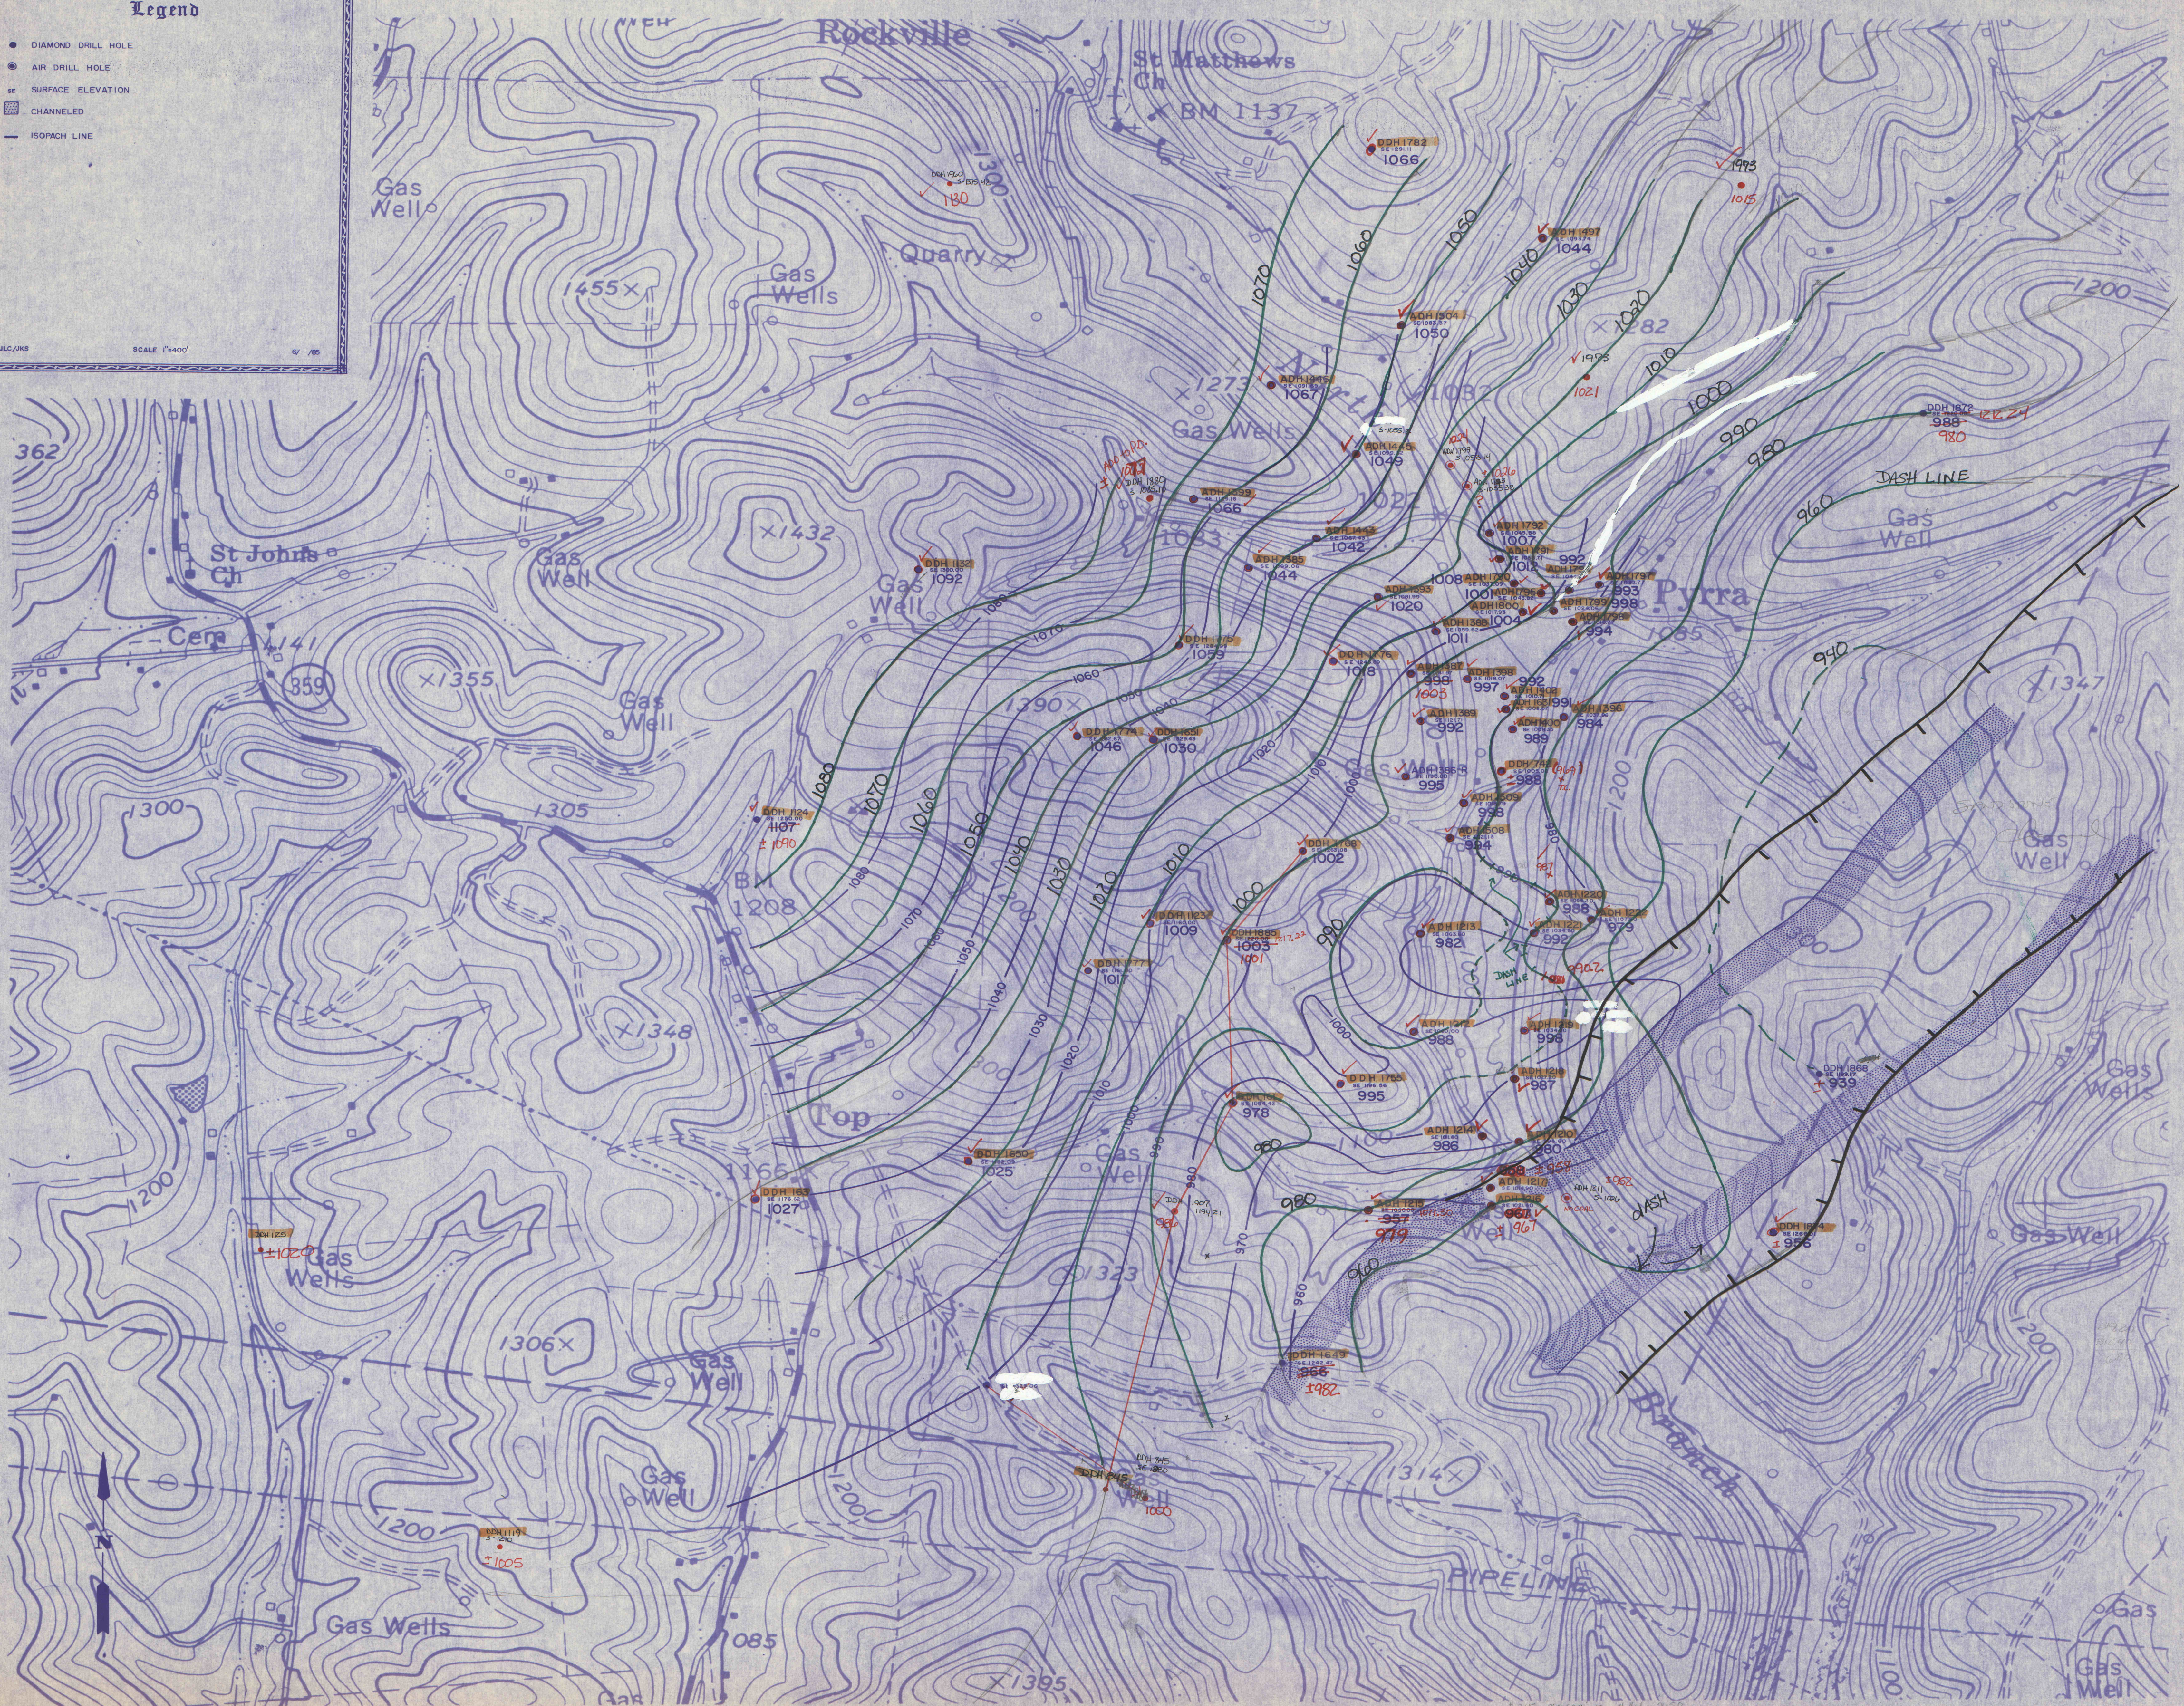

IMAPS 11174

6/4/86