


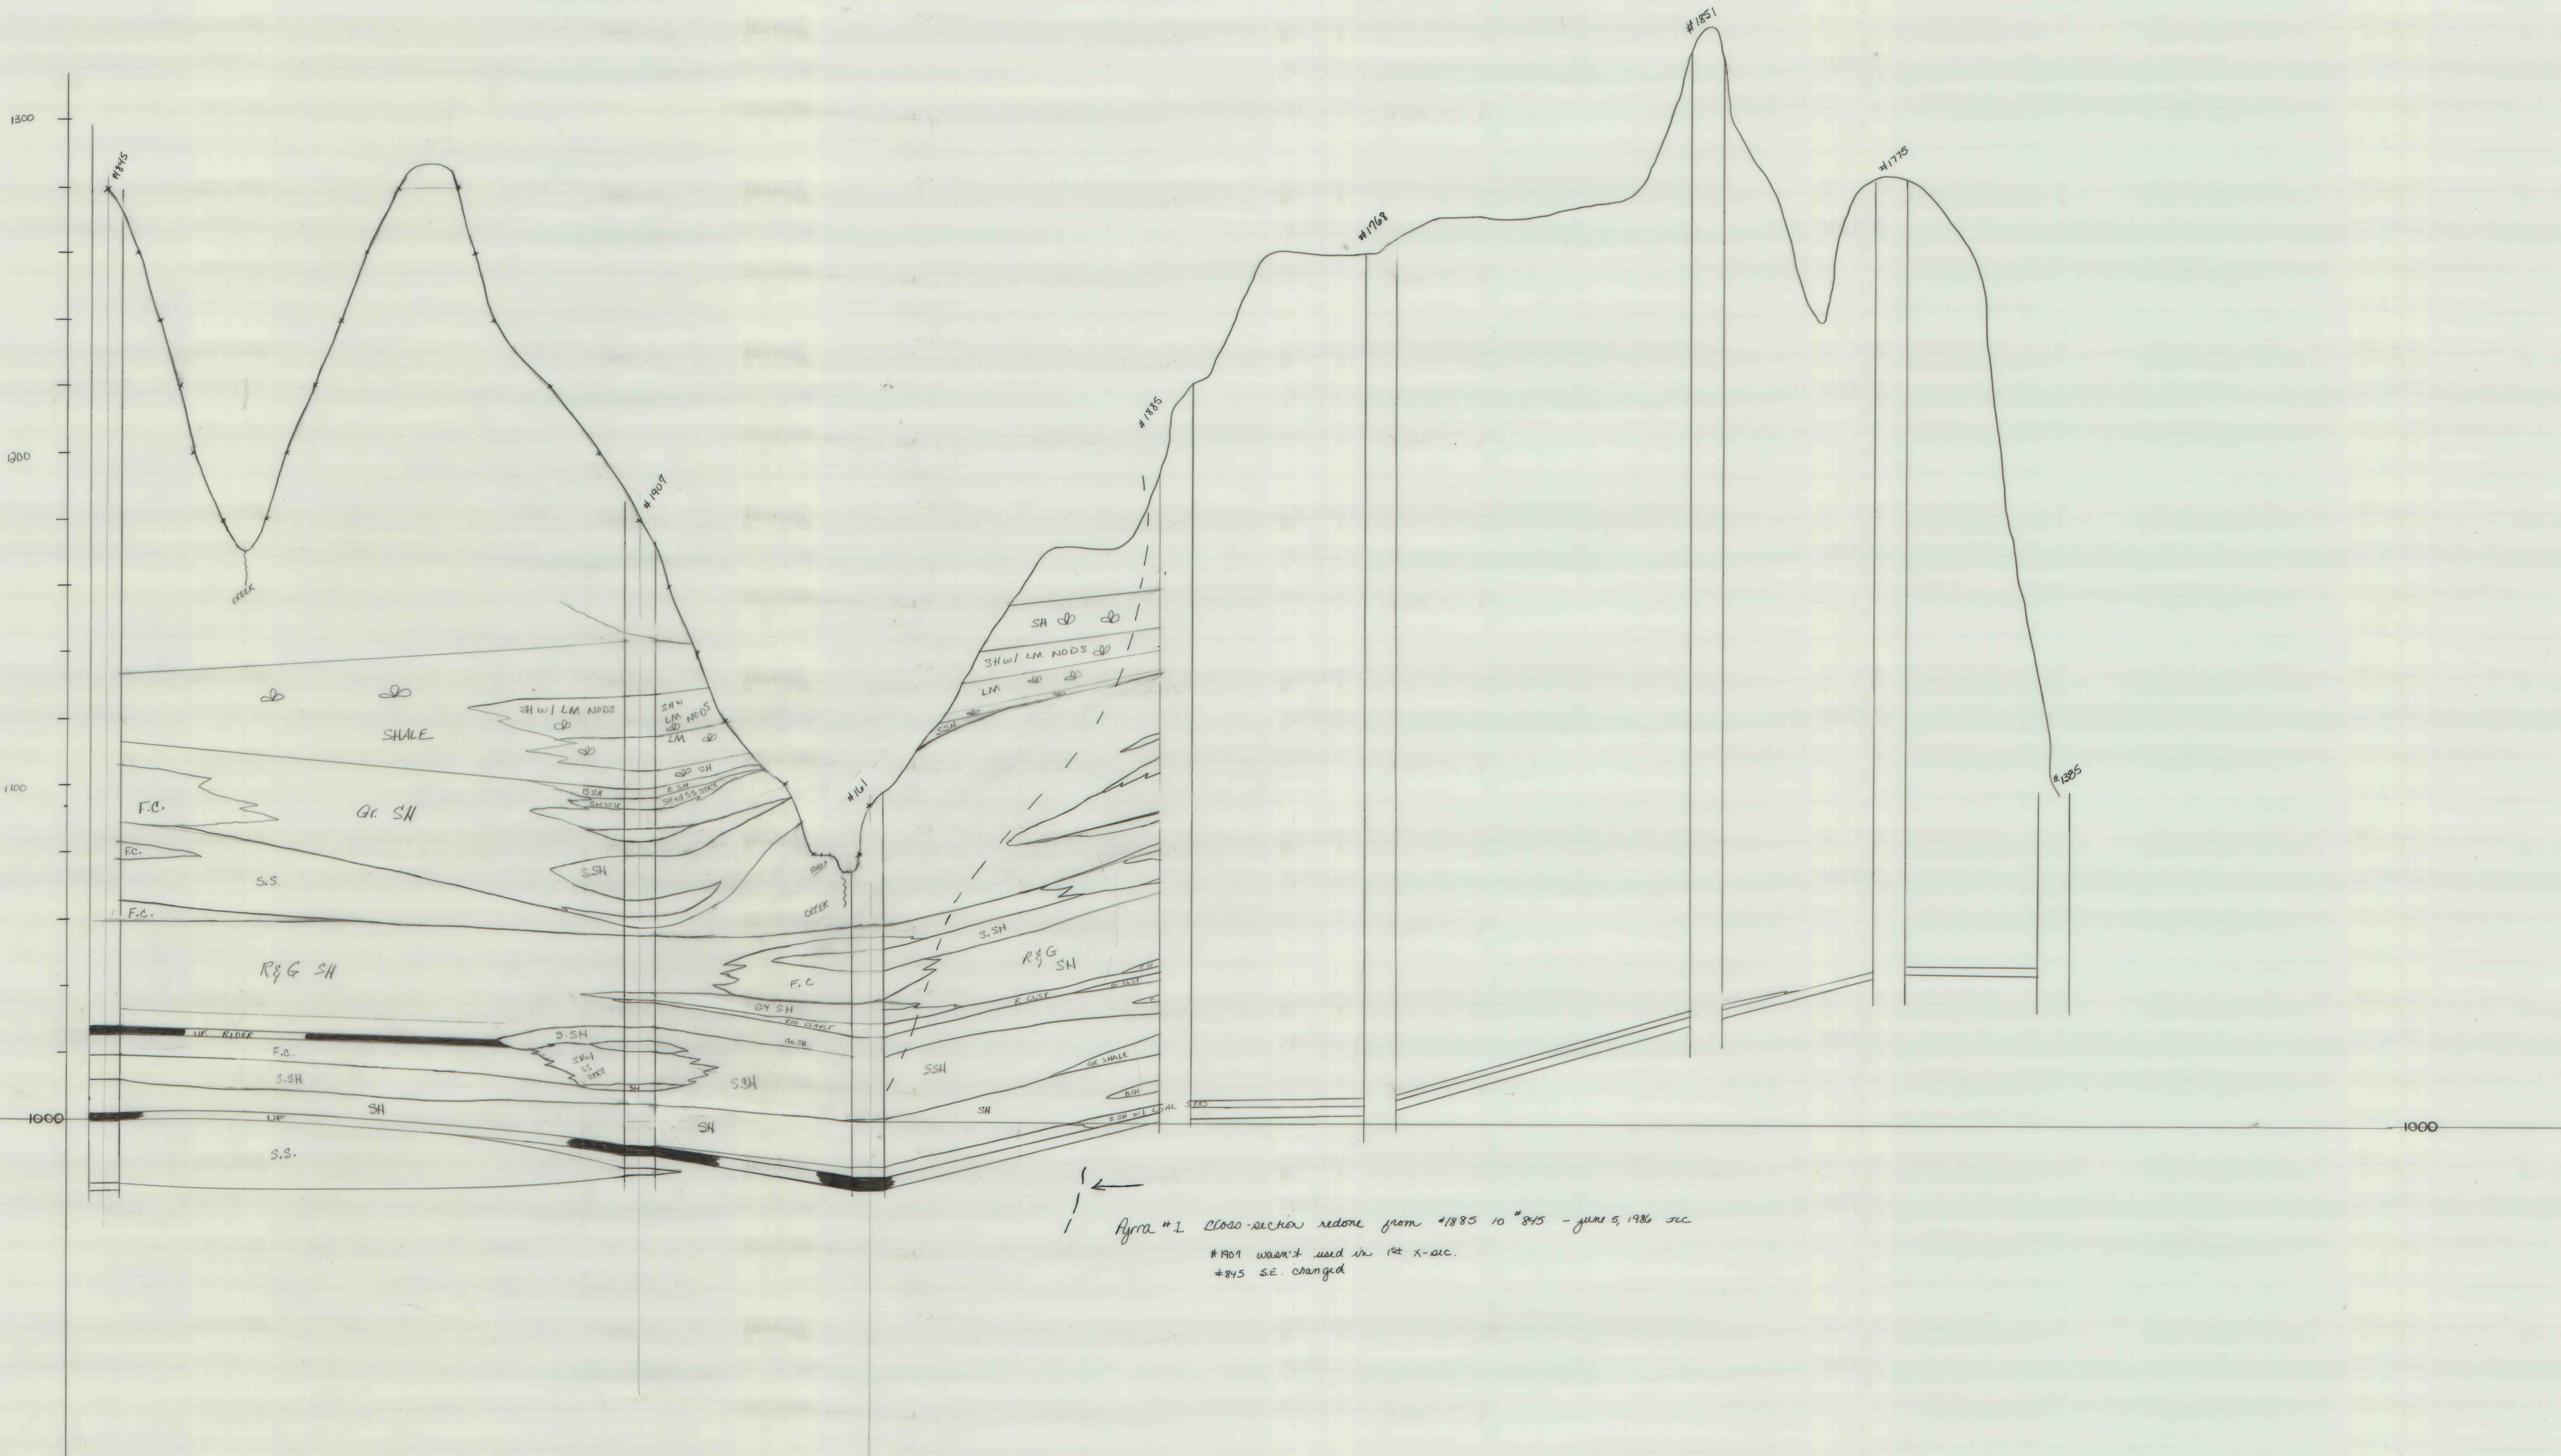

←
 Pyra #1 cross-section redone from #1885 to #845 - June 5, 1986 JCC
 #1901 wasn't used in 1st x-sec.
 #845 SE. changed