


Rochester & Pittsburgh Coal Co.
PYRRA # 1
UPPER FREEPORT (E) SEAM
SULFUR % (MINEABLE SEAM)

Legend

- DIAMOND DRILL HOLE
- AIR DRILL HOLE
- SE SURFACE ELEVATION
- CH CHanneled
- ISOPACH LINE

JLC/KKS SCALE 1"=400' 6/7/85

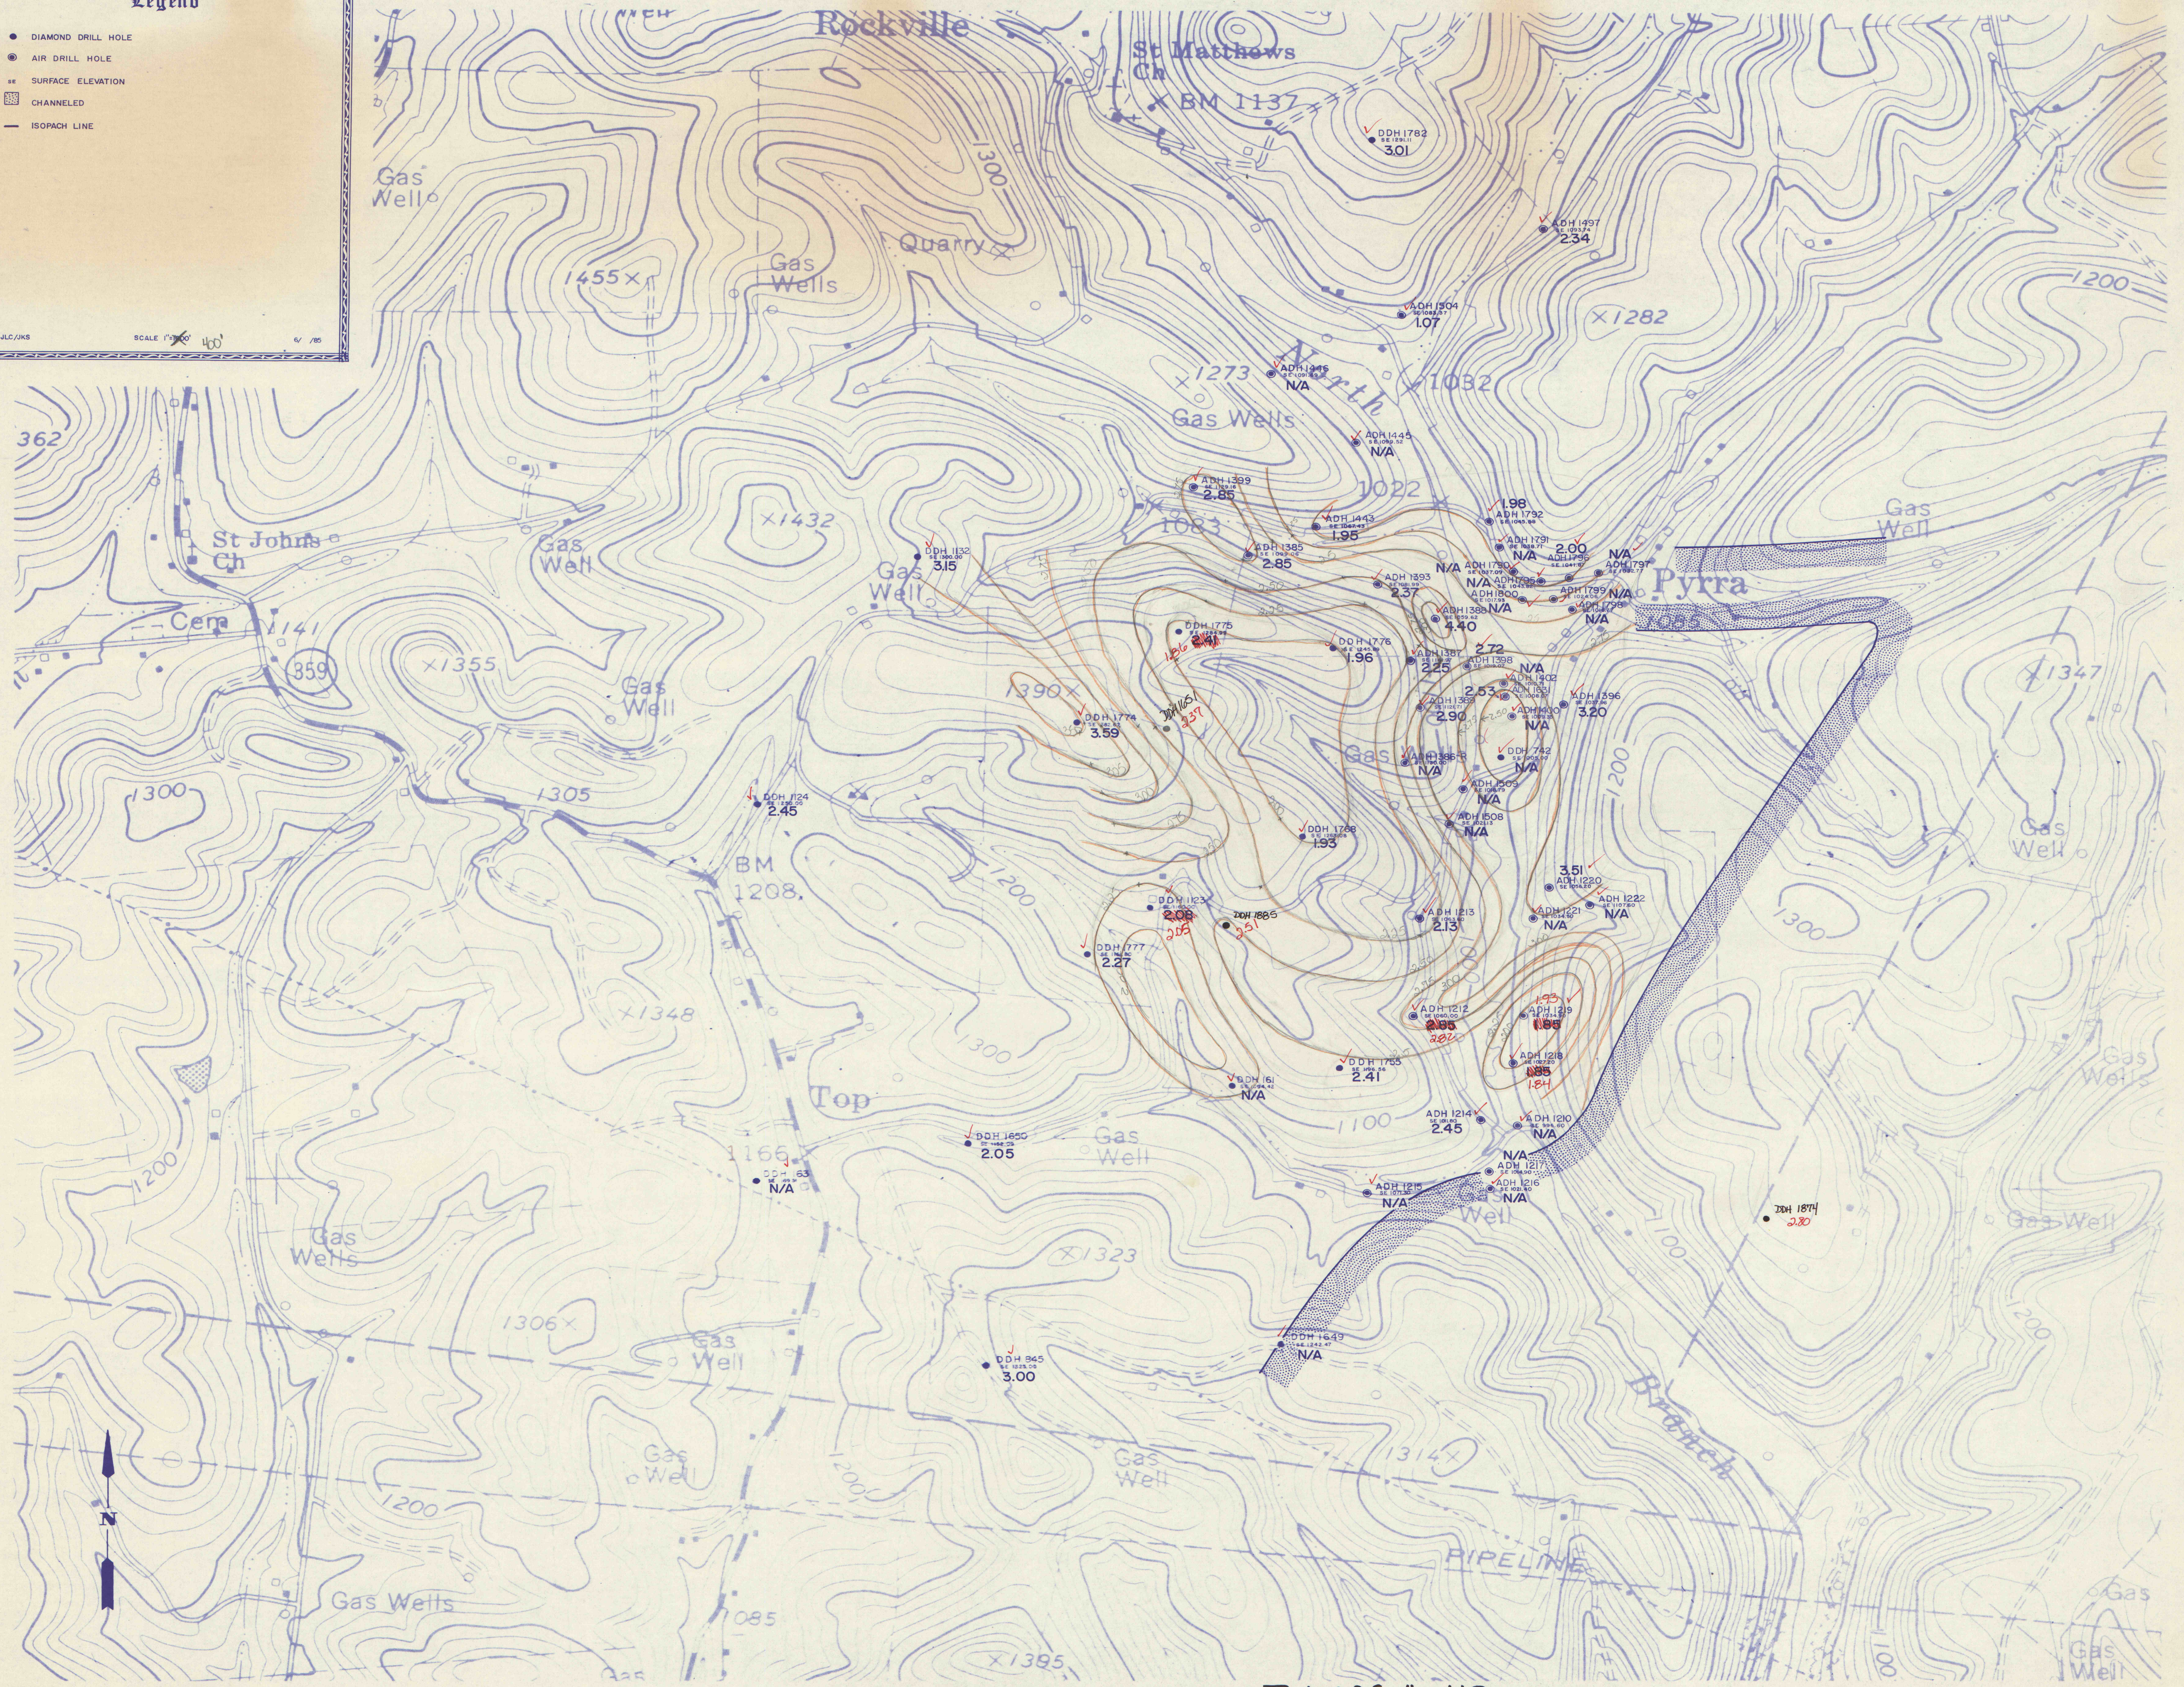

IMAPS # 11202