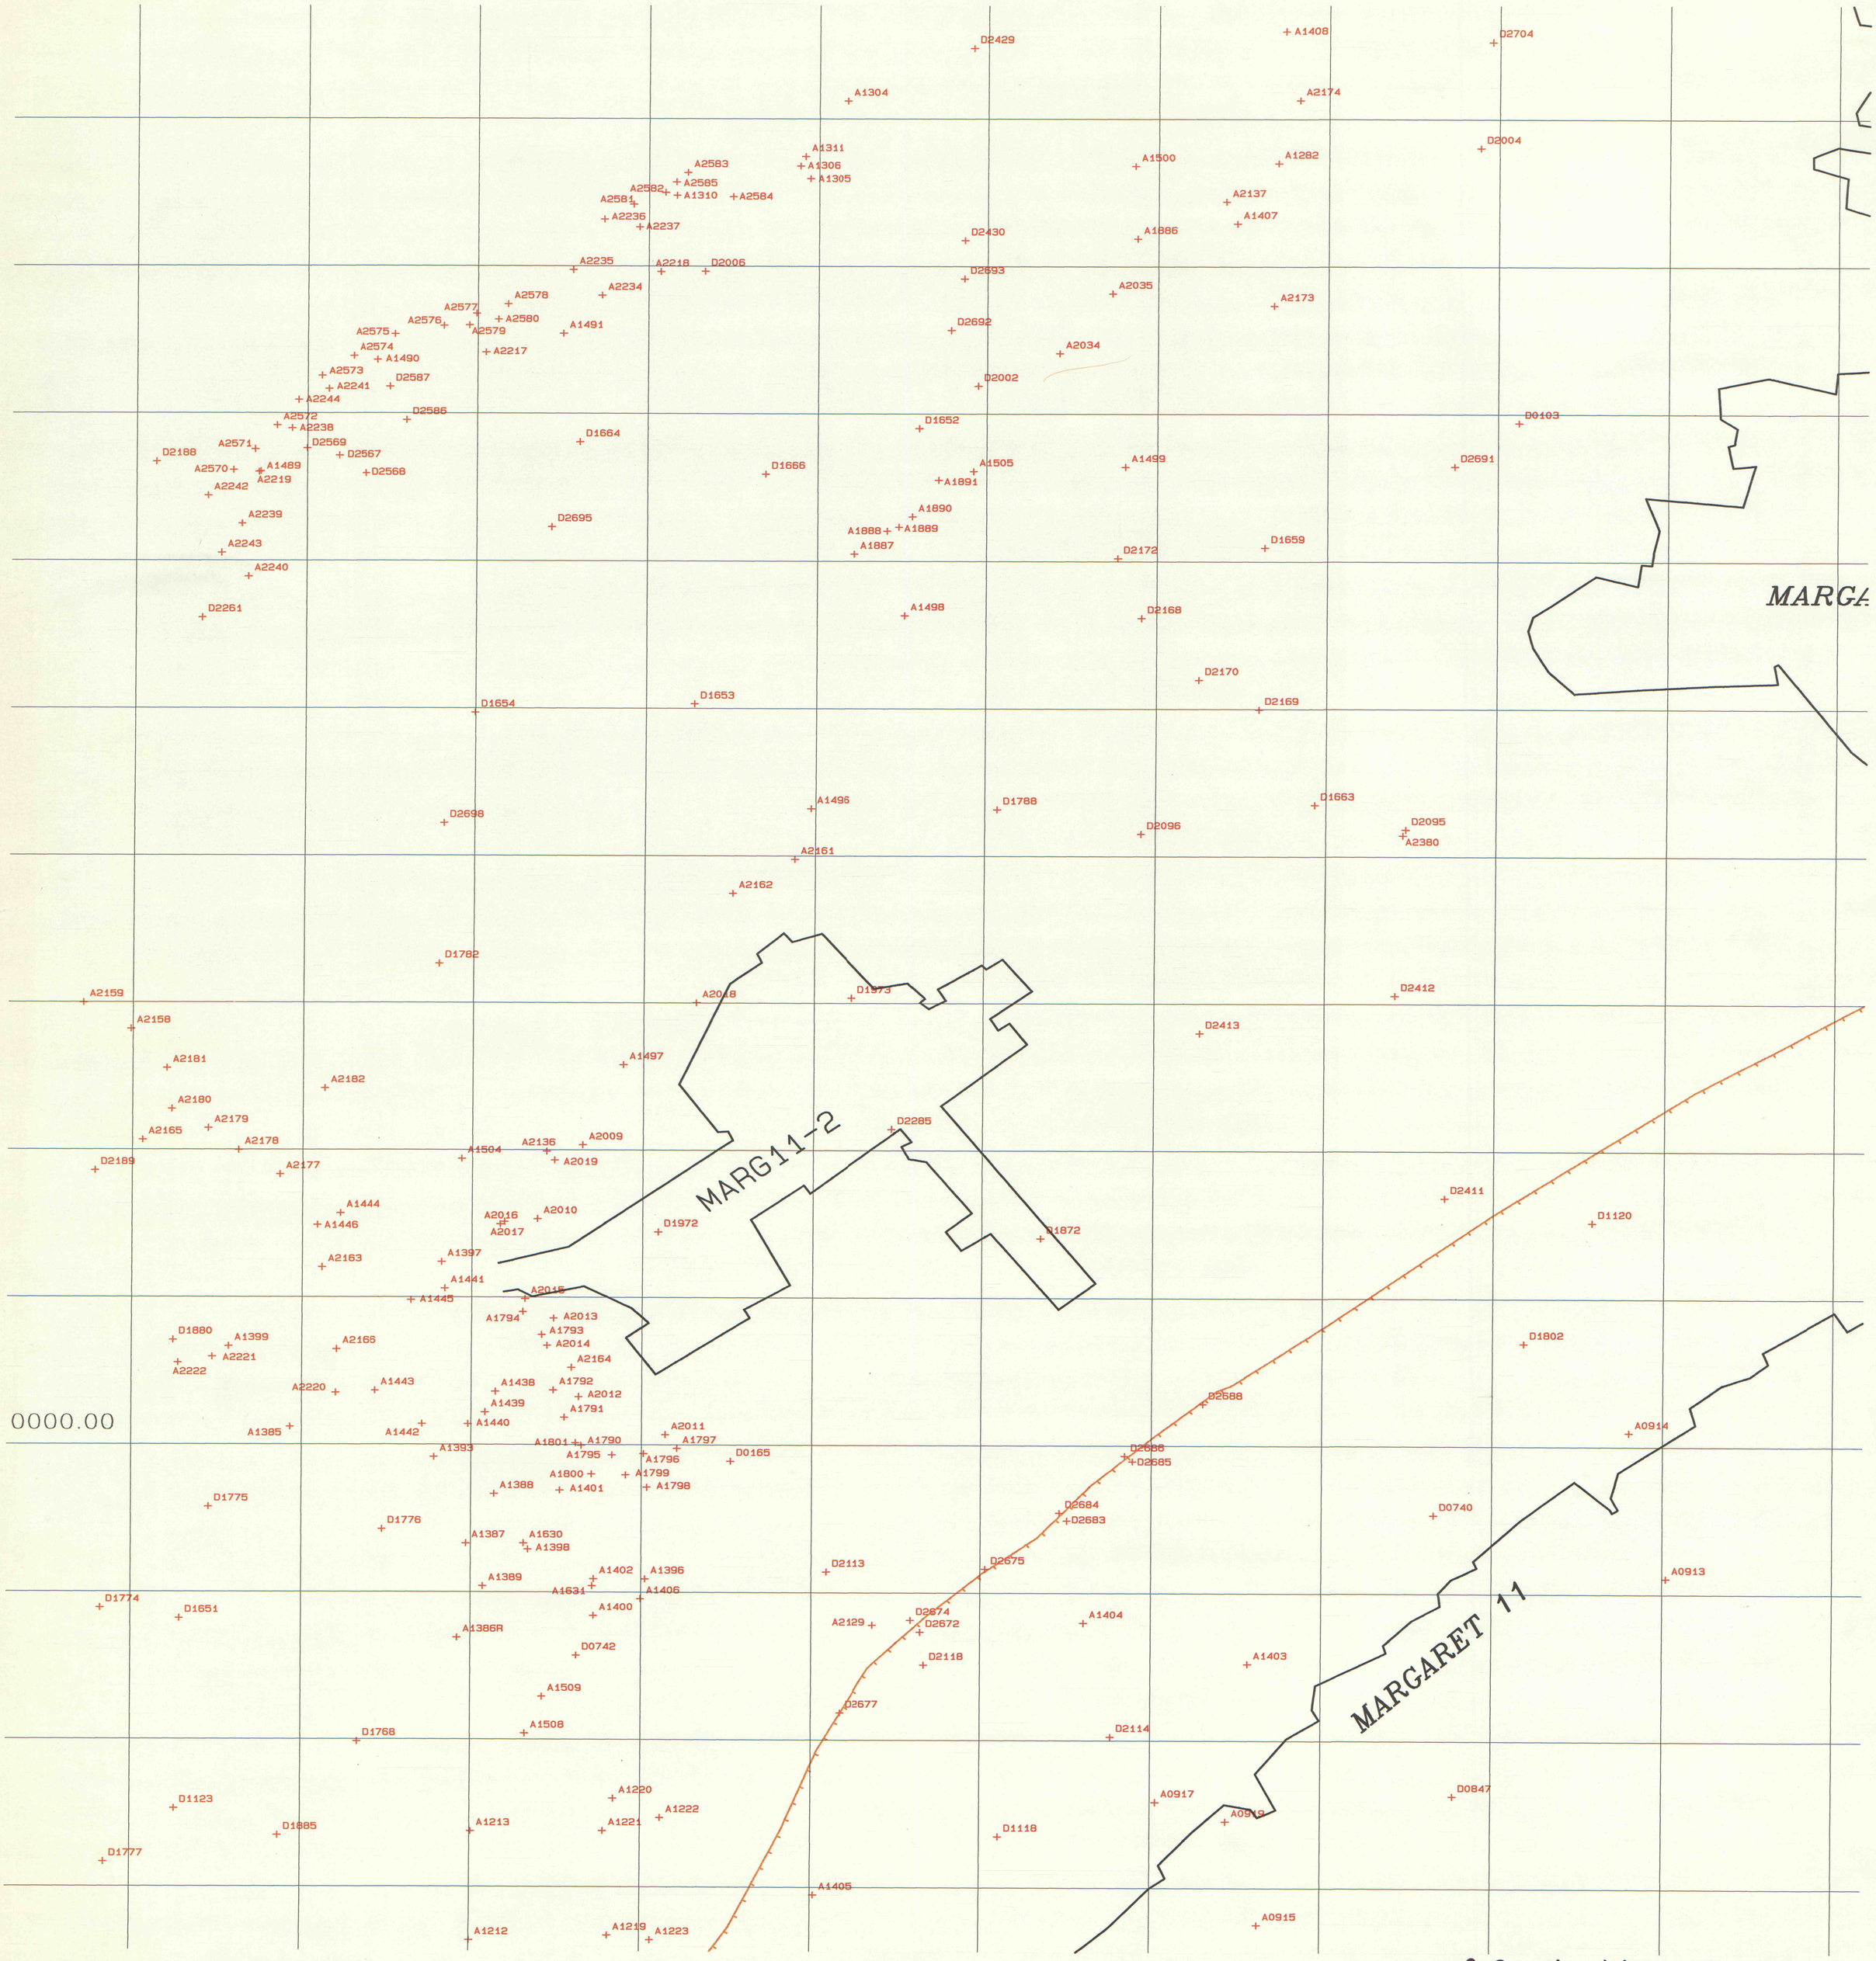
MARG11-2
MARGARET 11
D2429
A1408
D2704
A1304
A2174
A1311
A2583
A1306
A1305
A2585
A2582
A1310
A2584
A2581
A2236
A2237
A1500
A1282
D2004
A2137
A1407
D2430
A1886
A2235
A2218
D2006
D2693
A2234
A2578
A2035
A2173
A2577
A2576
A2580
A2579
A1491
D2692
A2575
A2574
A1490
A2034
A2217
A2573
A2241
D2587
D2002
A2244
A2572
A2238
D2586
D1652
D0103
D2188
A2571
D2569
D1664
A2570
A1489
A2219
D2567
D2568
D1666
A1505
A1499
D2691
A2242
A1891
A2239
D2695
A1890
A1888
A1889
A2243
A1887
D2172
D1659
A2240
D2261
A1498
D2168
D2170
D1654
D1653
D2169
A1496
D1788
D1663
D2698
D2096
D2095
A2380
A2161
A2162
D1782
A2159
A2158
A2018
D1973
D2412
D2413
A2181
A1497
A2182
A2180
A2179
A2165
A2178
D2285
A1504
A2136
A2009
D2189
A2177
A2019
A1444
A1446
A2016
A2017
A2010
D1972
D1872
A2163
A1397
A1441
A1445
A2015
D2411
D1120
A1794
A2013
A1793
A2014
D1880
A1399
A2165
A2164
A2221
A2222
A2220
A1443
A1438
A1792
A2012
A1439
A1791
A1385
A1442
A1440
A2011
A1801
A1790
A1797
A1795
A1796
D0165
A1393
A1800
A1799
A1388
A1401
A1798
D1775
D1776
A1387
A1630
A1398
A1389
A1402
A1396
A1631
A1406
D1774
D1651
A1400
A1386R
D0742
A1509
A1508
D1768
D1123
A1220
A1222
D1885
A1213
A1221
D1777
A1212
A1219
A1223
D2688
D2686
D2685
D2684
D2683
D2675
D2113
D2674
D2672
A2129
A1404
D2118
A1403
D2677
D2114
A0914
D0740
A0913
A0917
A0916
D0847
D1118
A1405
A0915
D1802
0000.00
IMAPS # 11213