


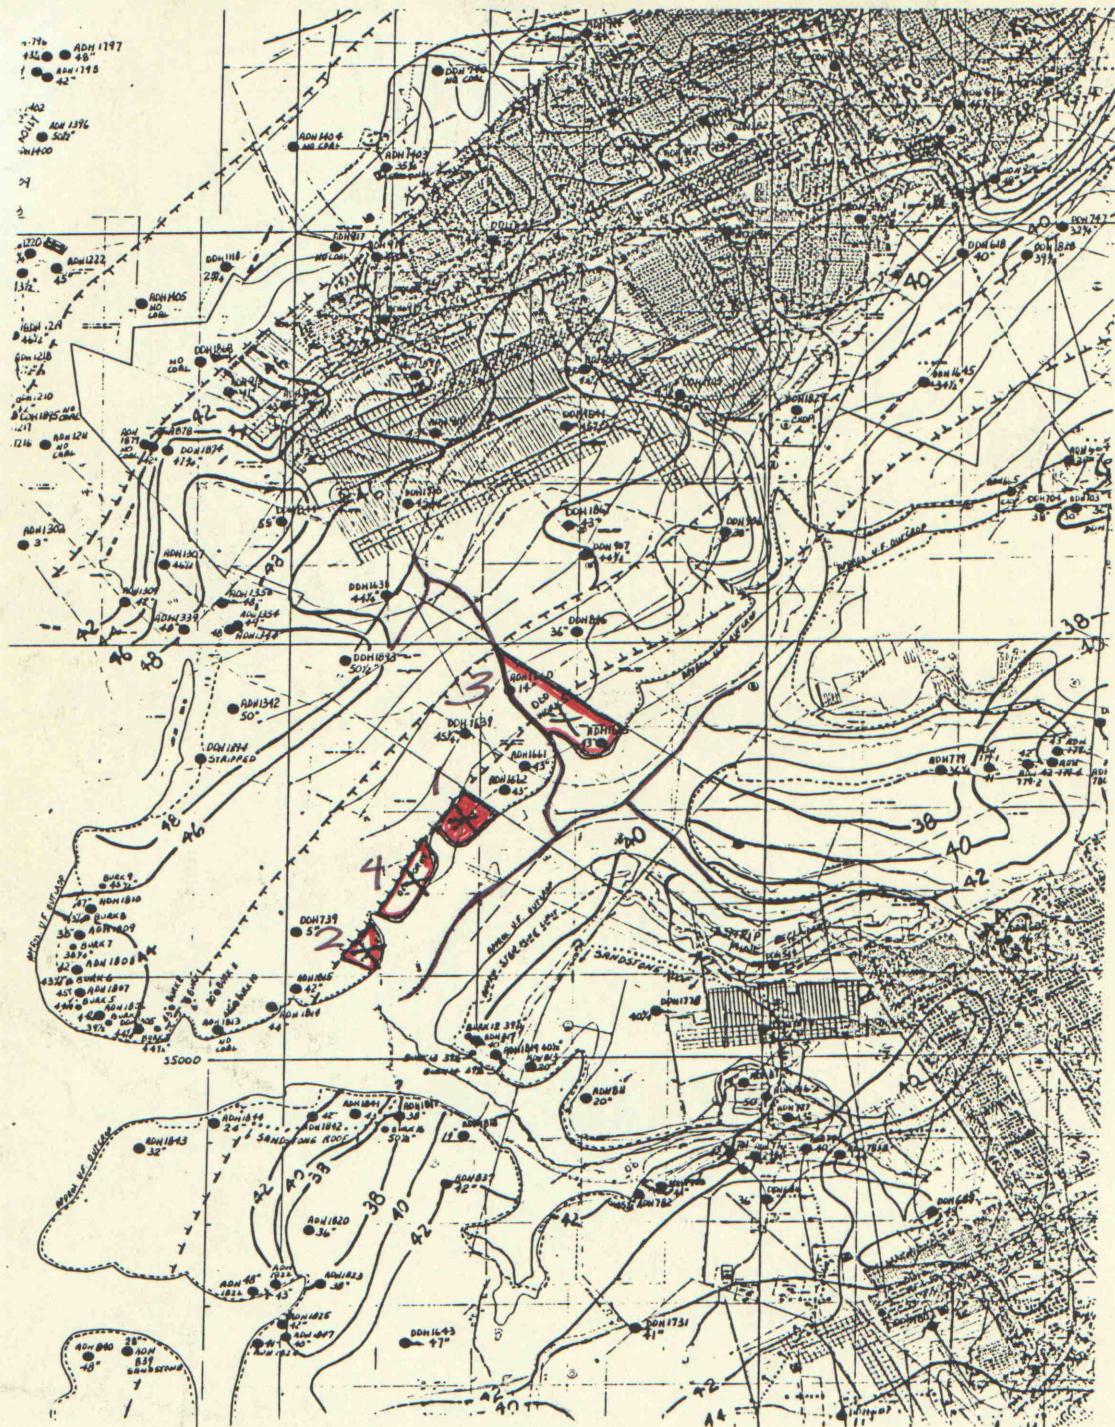

GF SMITH MINES

2000 scale

IMAPS # 11235