


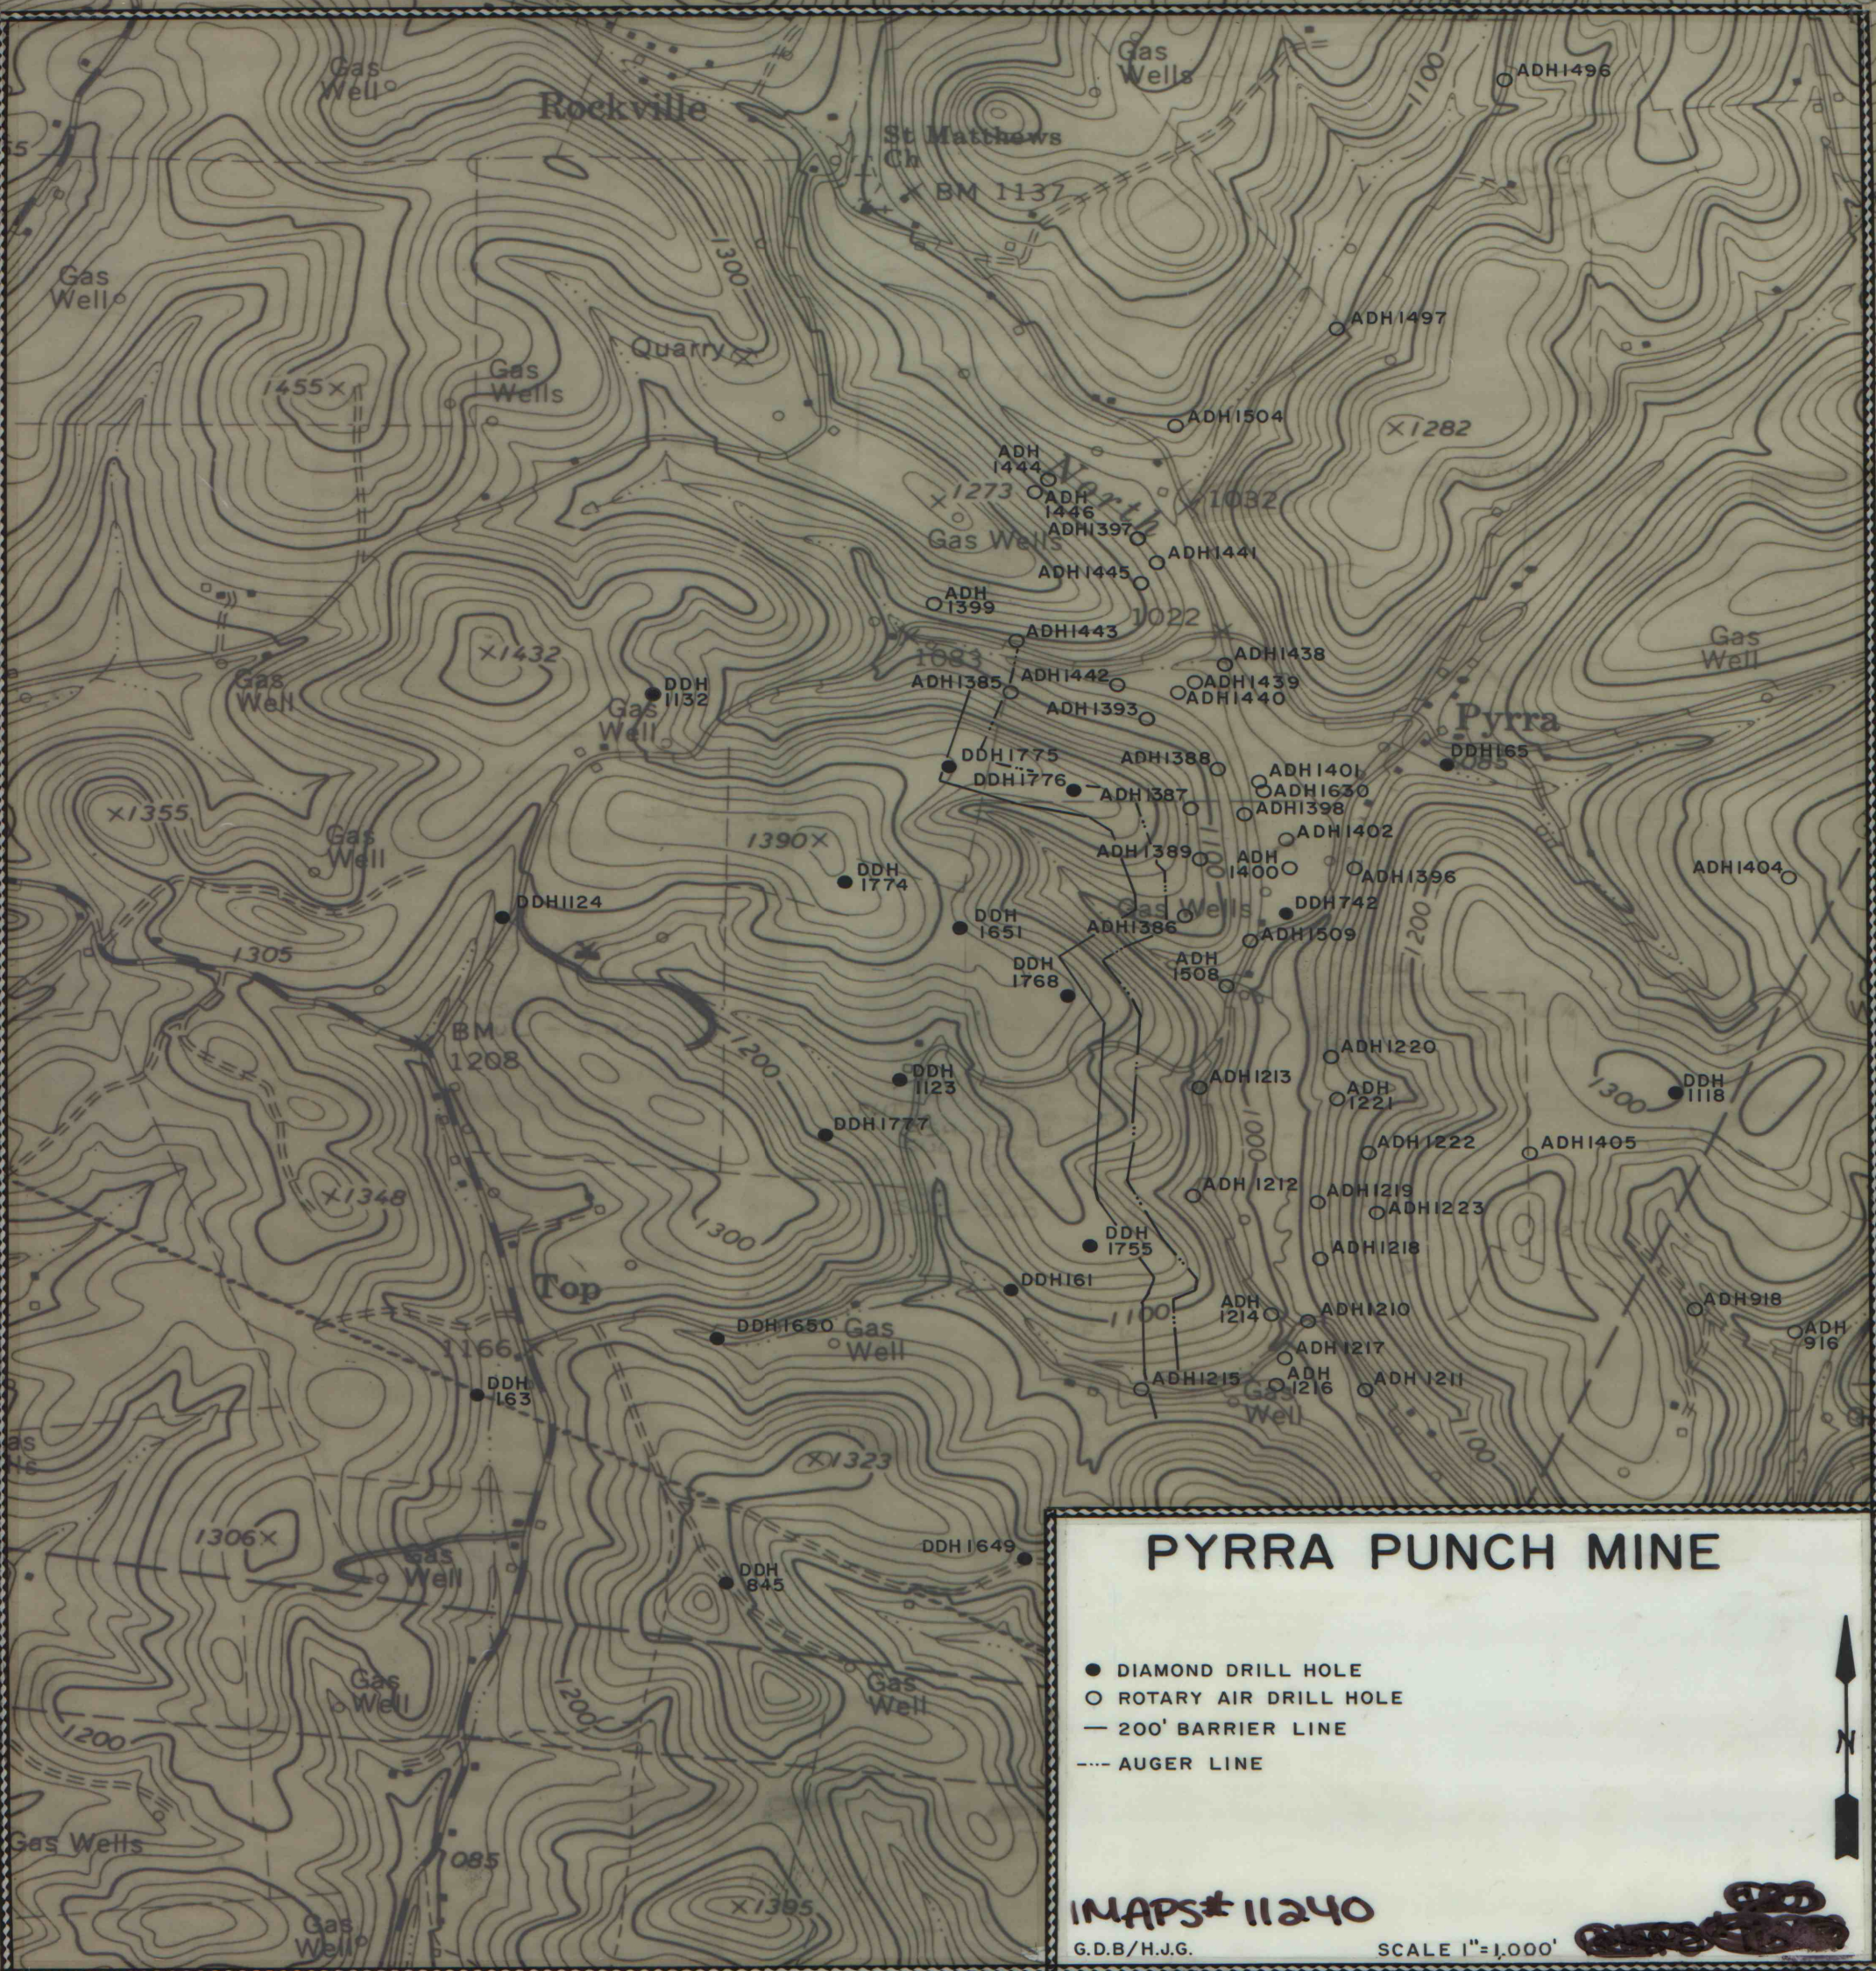

PYRRA PUNCH MINE

- DIAMOND DRILL HOLE
- ROTARY AIR DRILL HOLE
- 200' BARRIER LINE
- AUGER LINE

MAPS# 11240

G.D.B./H.J.G.

SCALE 1"=1,000'

