


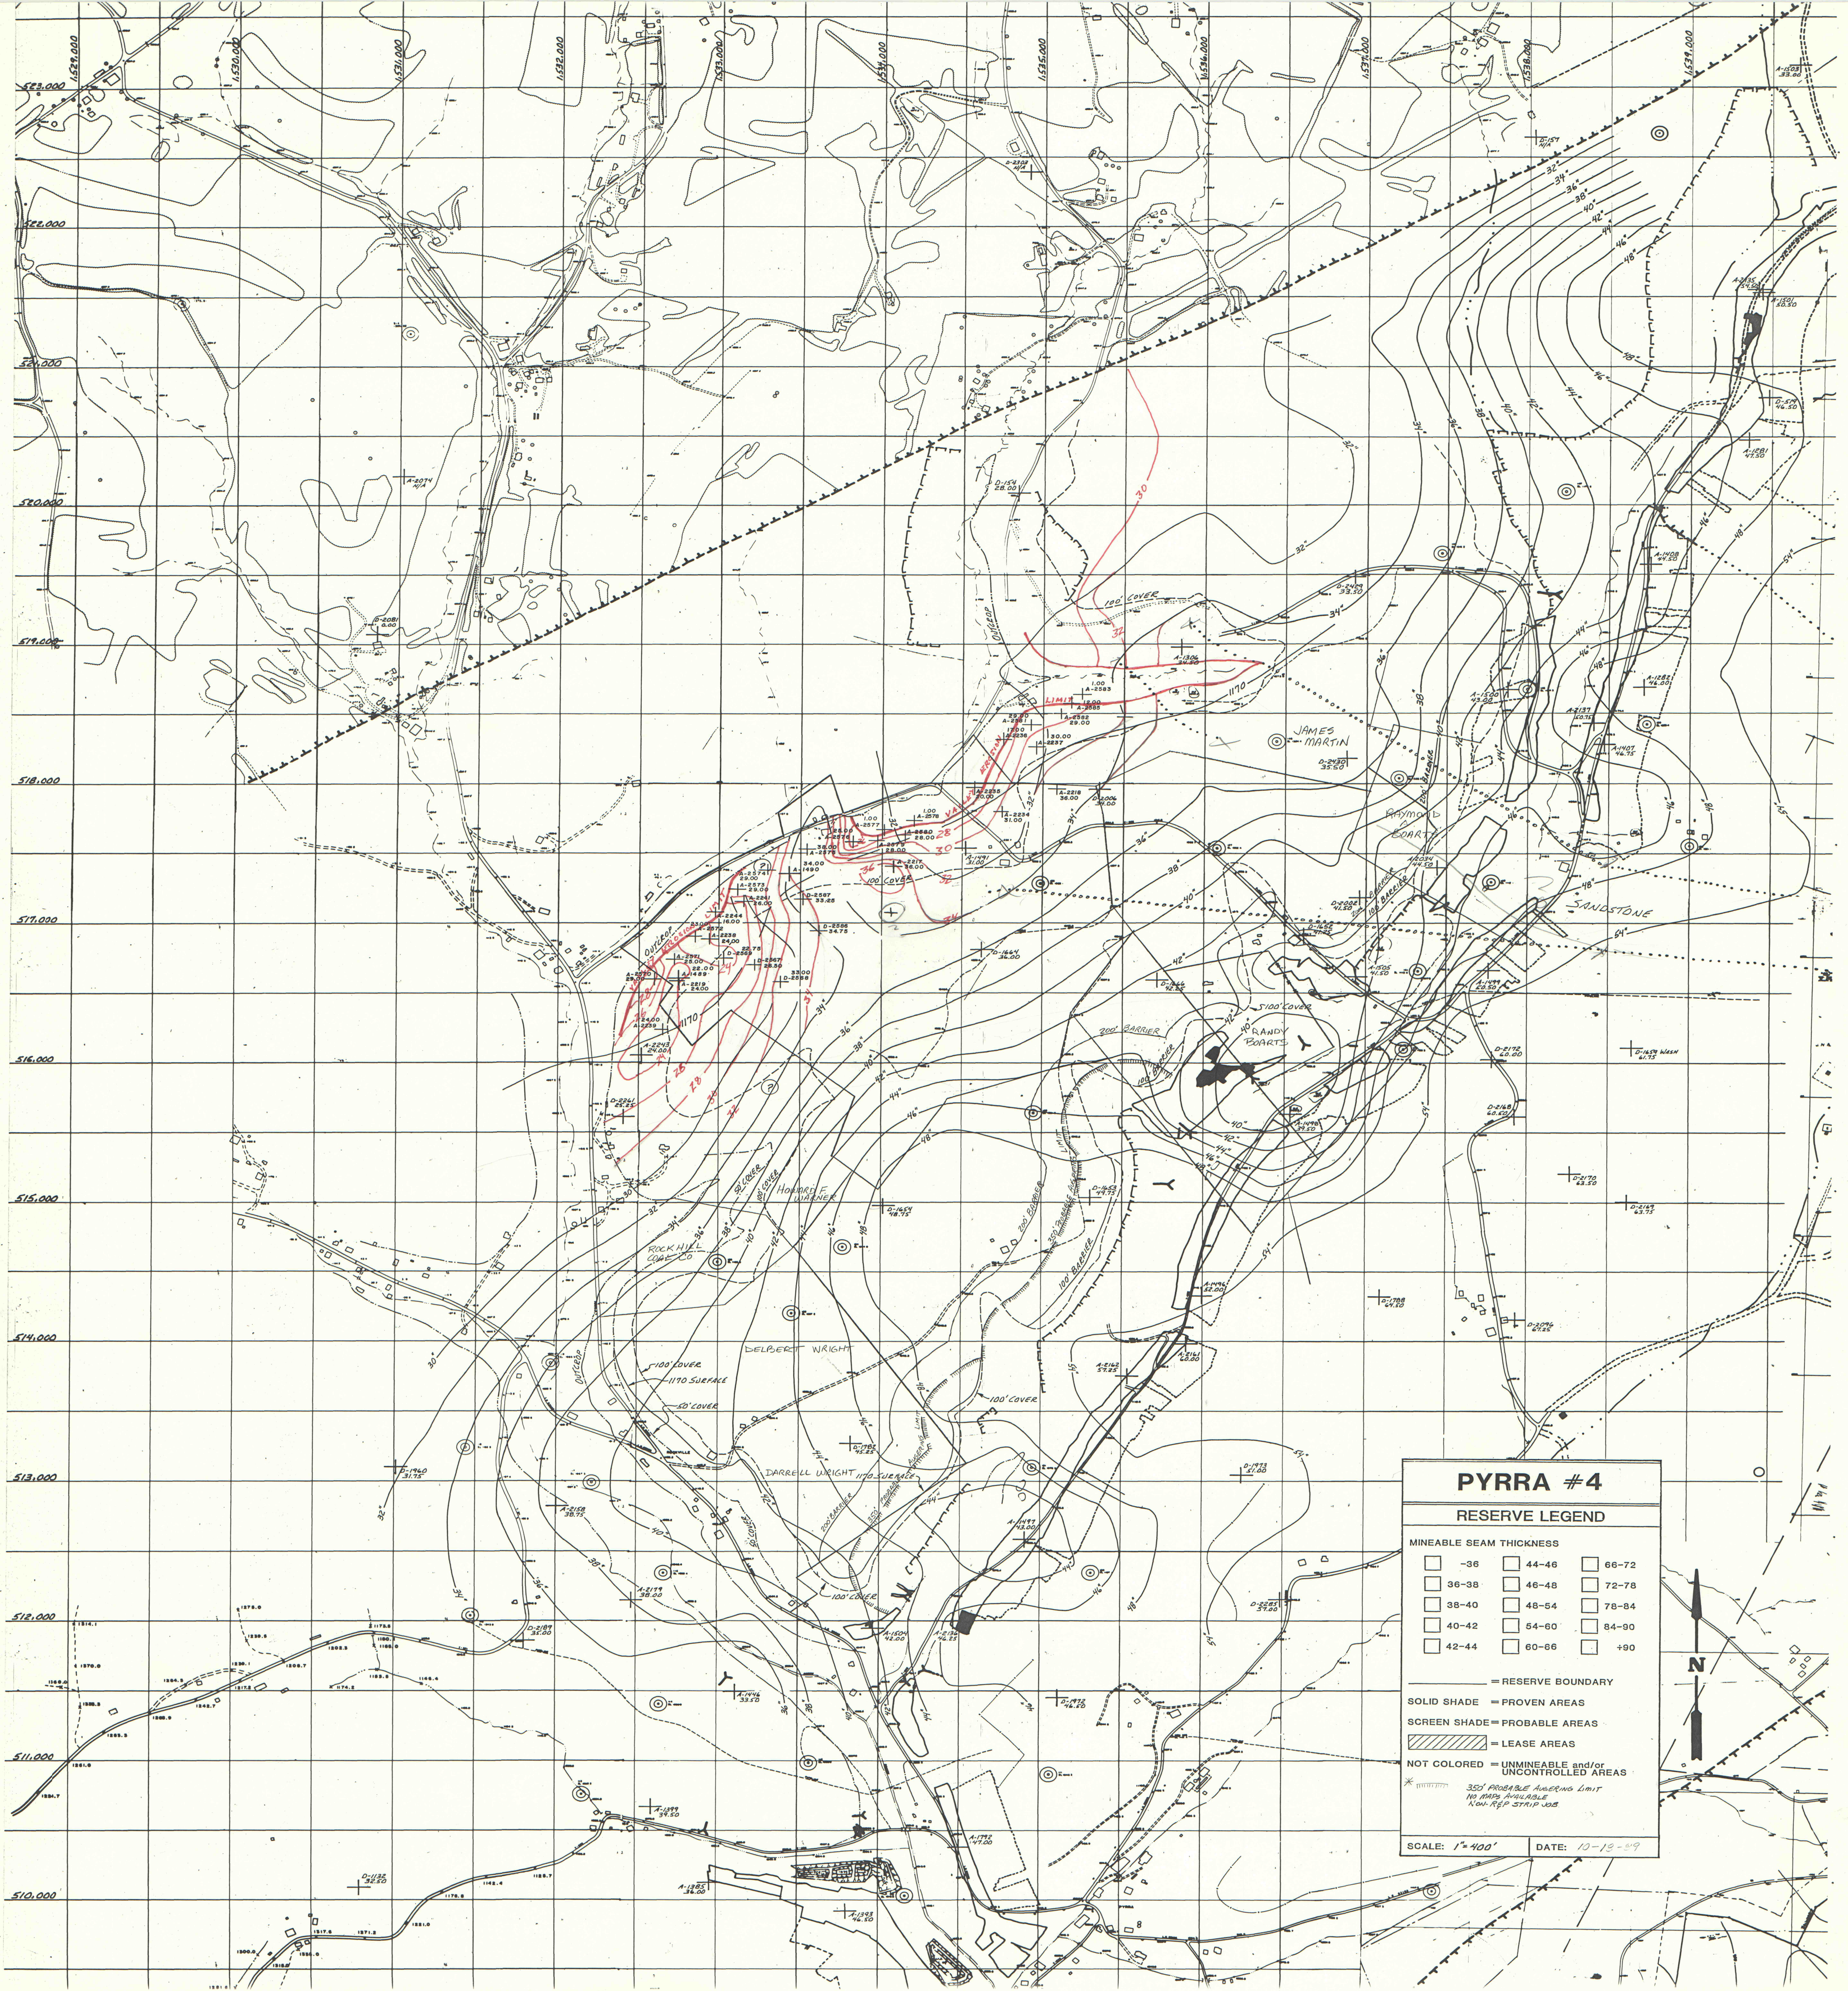

PYRRA #4

RESERVE LEGEND

MINEABLE SEAM THICKNESS

36-38	44-48	66-72
38-40	46-48	72-78
40-42	48-54	78-84
42-44	54-60	84-90
	60-66	+90

— = RESERVE BOUNDARY

SOLID SHADE = PROVEN AREAS

SCREEN SHADE = PROBABLE AREAS

▨ = LEASE AREAS

NOT COLORED = UNMINEABLE and/or UNCONTROLLED AREAS

350' PROBABLE AVERAGING LIMIT
NO MAPS AVAILABLE
NO REF STRIP JOB

SCALE: 1"=400' DATE: 10-12-69

MAP# 11245