


RURAL VALLEY

MUSGRUVE

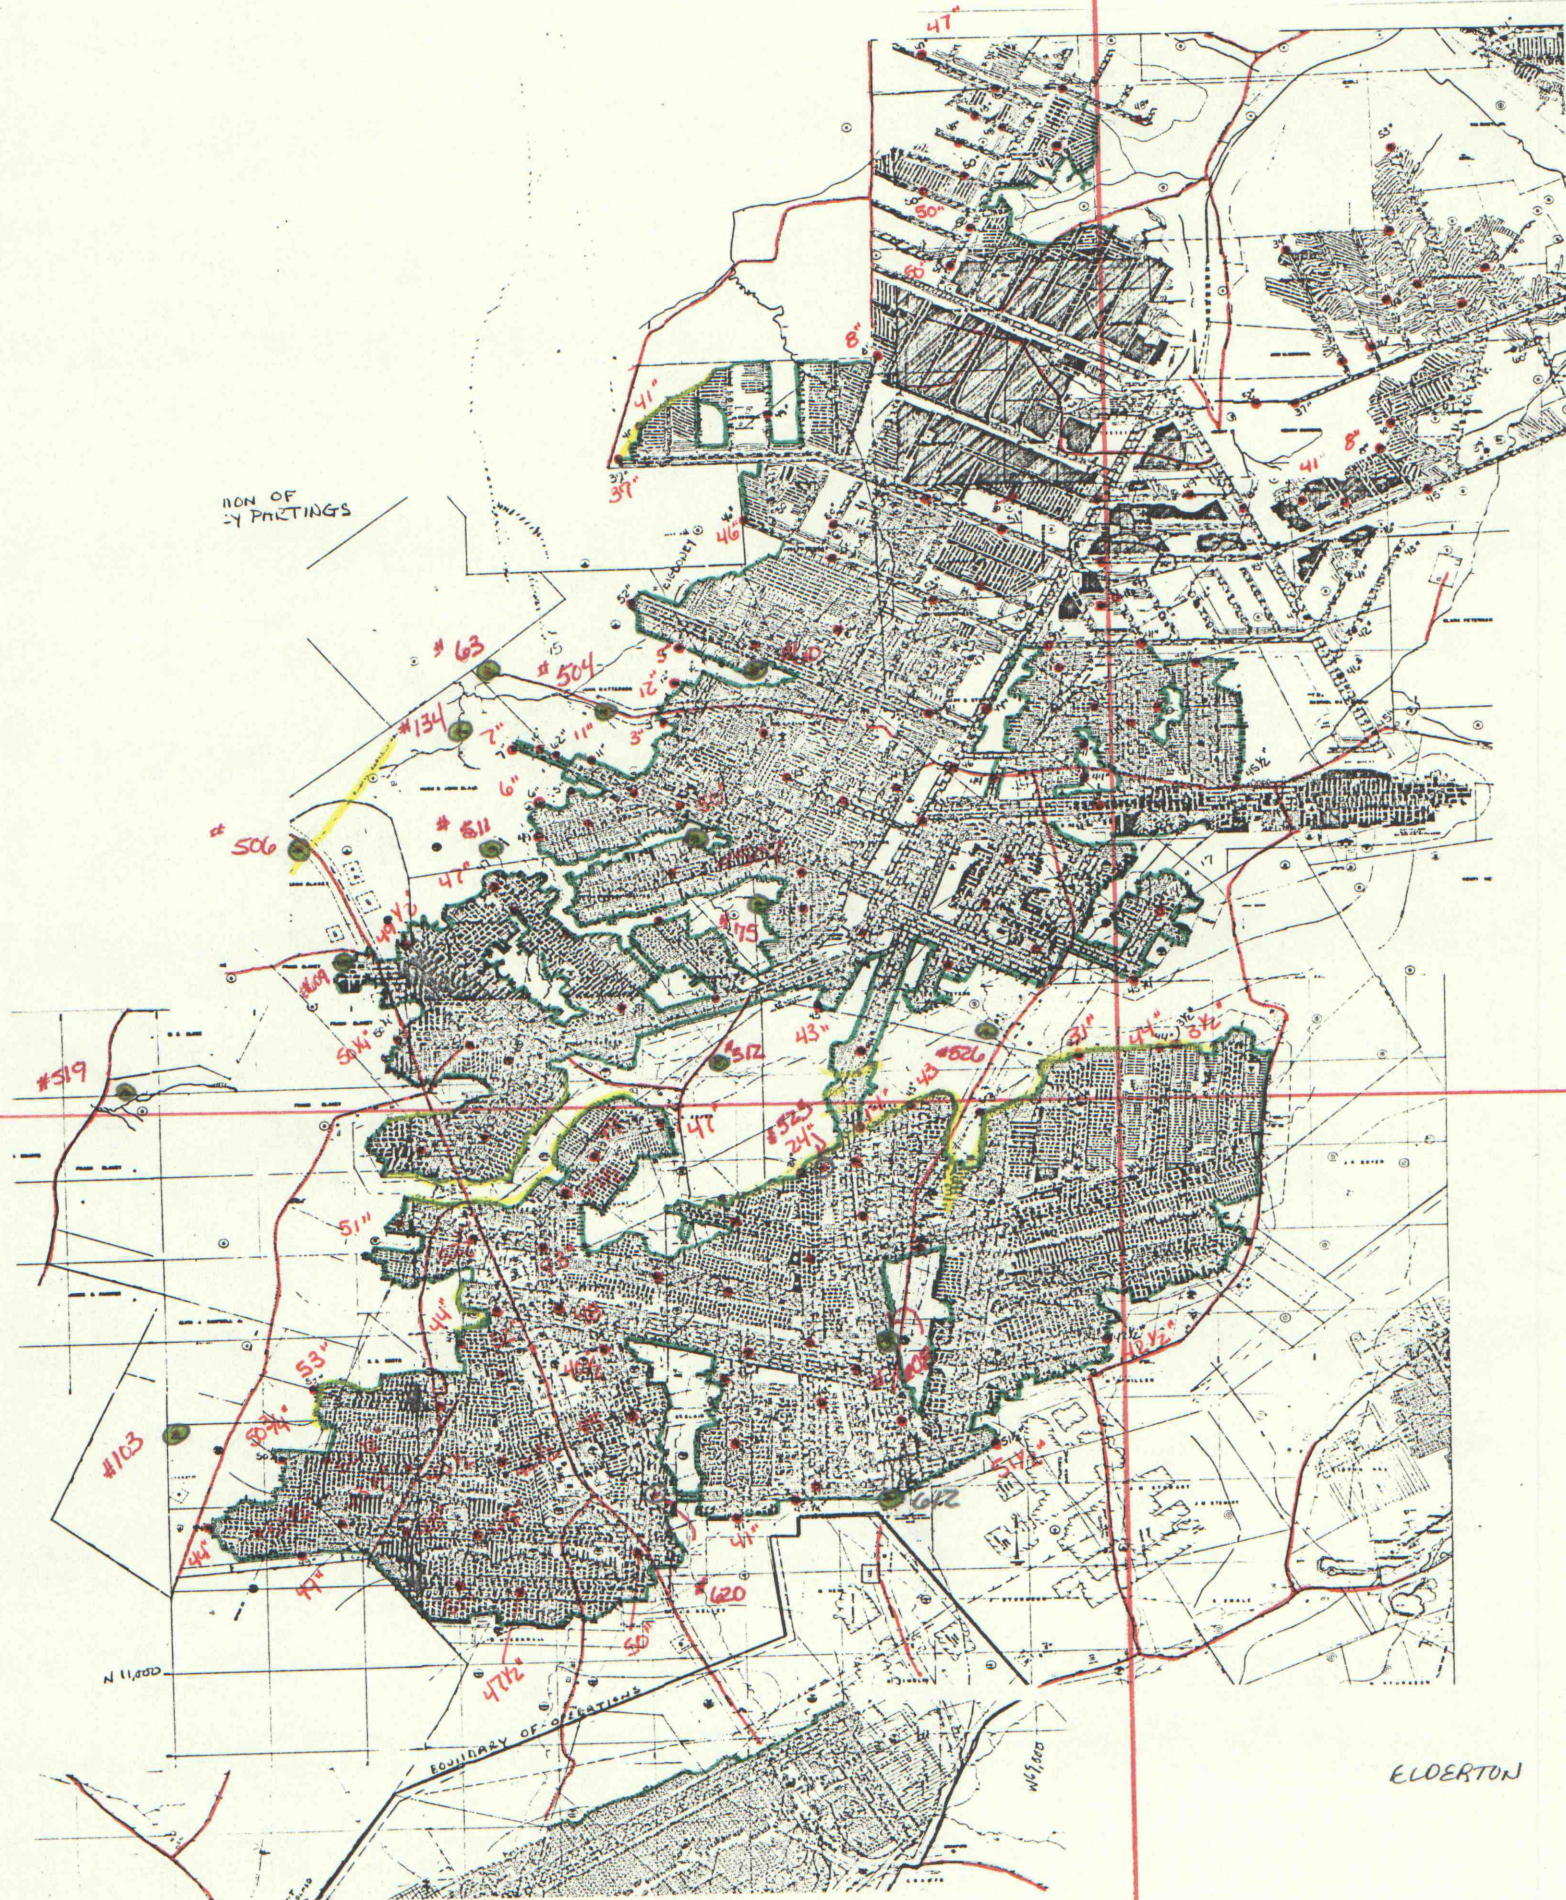

ELDERTON

WNITESBURG

#515
#518
#66
#59

IMAPS #11247