IMAPS #1125C

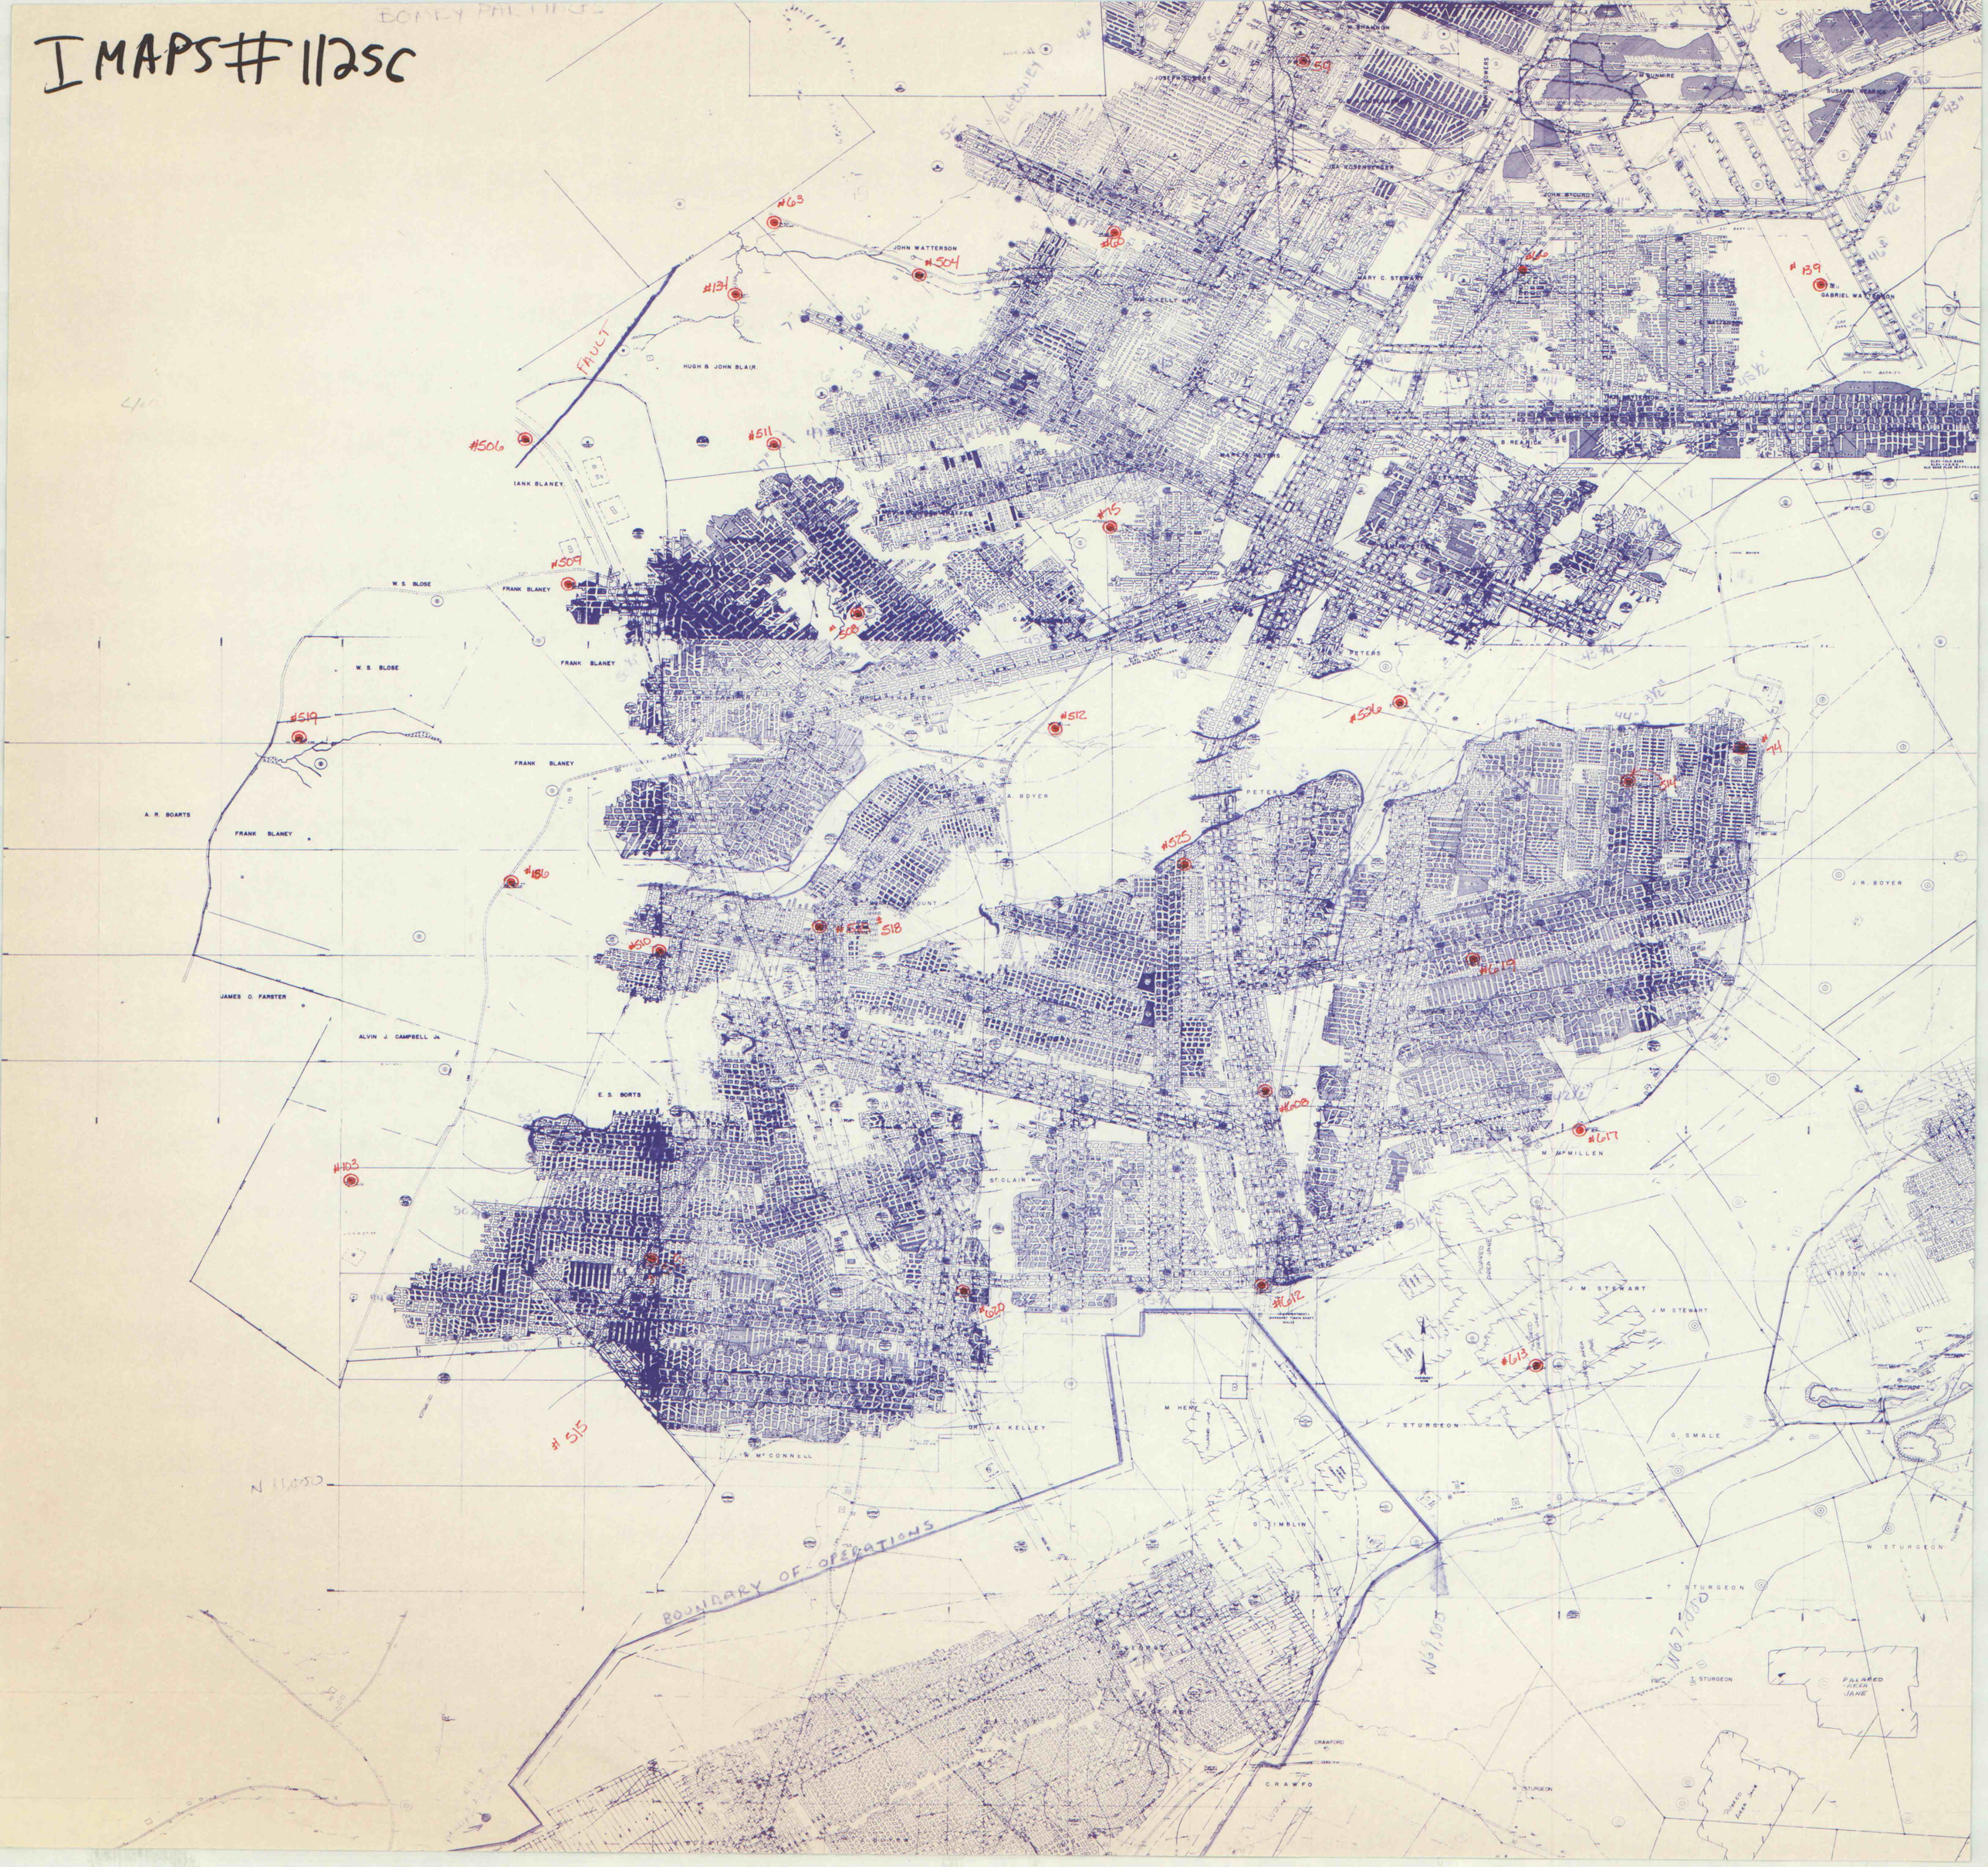
BOMEY PALINGS
FAULT
JOHN WATTERSON
HUGH & JOHN BLAIR
W. S. BLOSE
FRANK BLANEY
A. R. BOARTS
JAMES O. FARSTER
ALVIN J. CAMPBELL Jr.
E. S. BORTS
ST. CLAIR
M McMILLEN
J. M. STEWART
G. SMALE
J. STURGEON
W. STURGEON
T. STURGEON
R. STURGEON
G. TIMBLIN
M. HENY
W. McCONNELL
J. R. BOYER
A. BOYER
PETERS
GABRIEL WATTERSON
SUSANNA WARRICK
BOUNDARY OF OPERATIONS
N 11,050
W 6,000
W 7,000
#63
#131
#504
#506
#511
#509
#508
#75
#519
#512
#536
#74
#514
#186
#518
#510
#575
#619
#608
#617
#103
#612
#610
#613
#515