


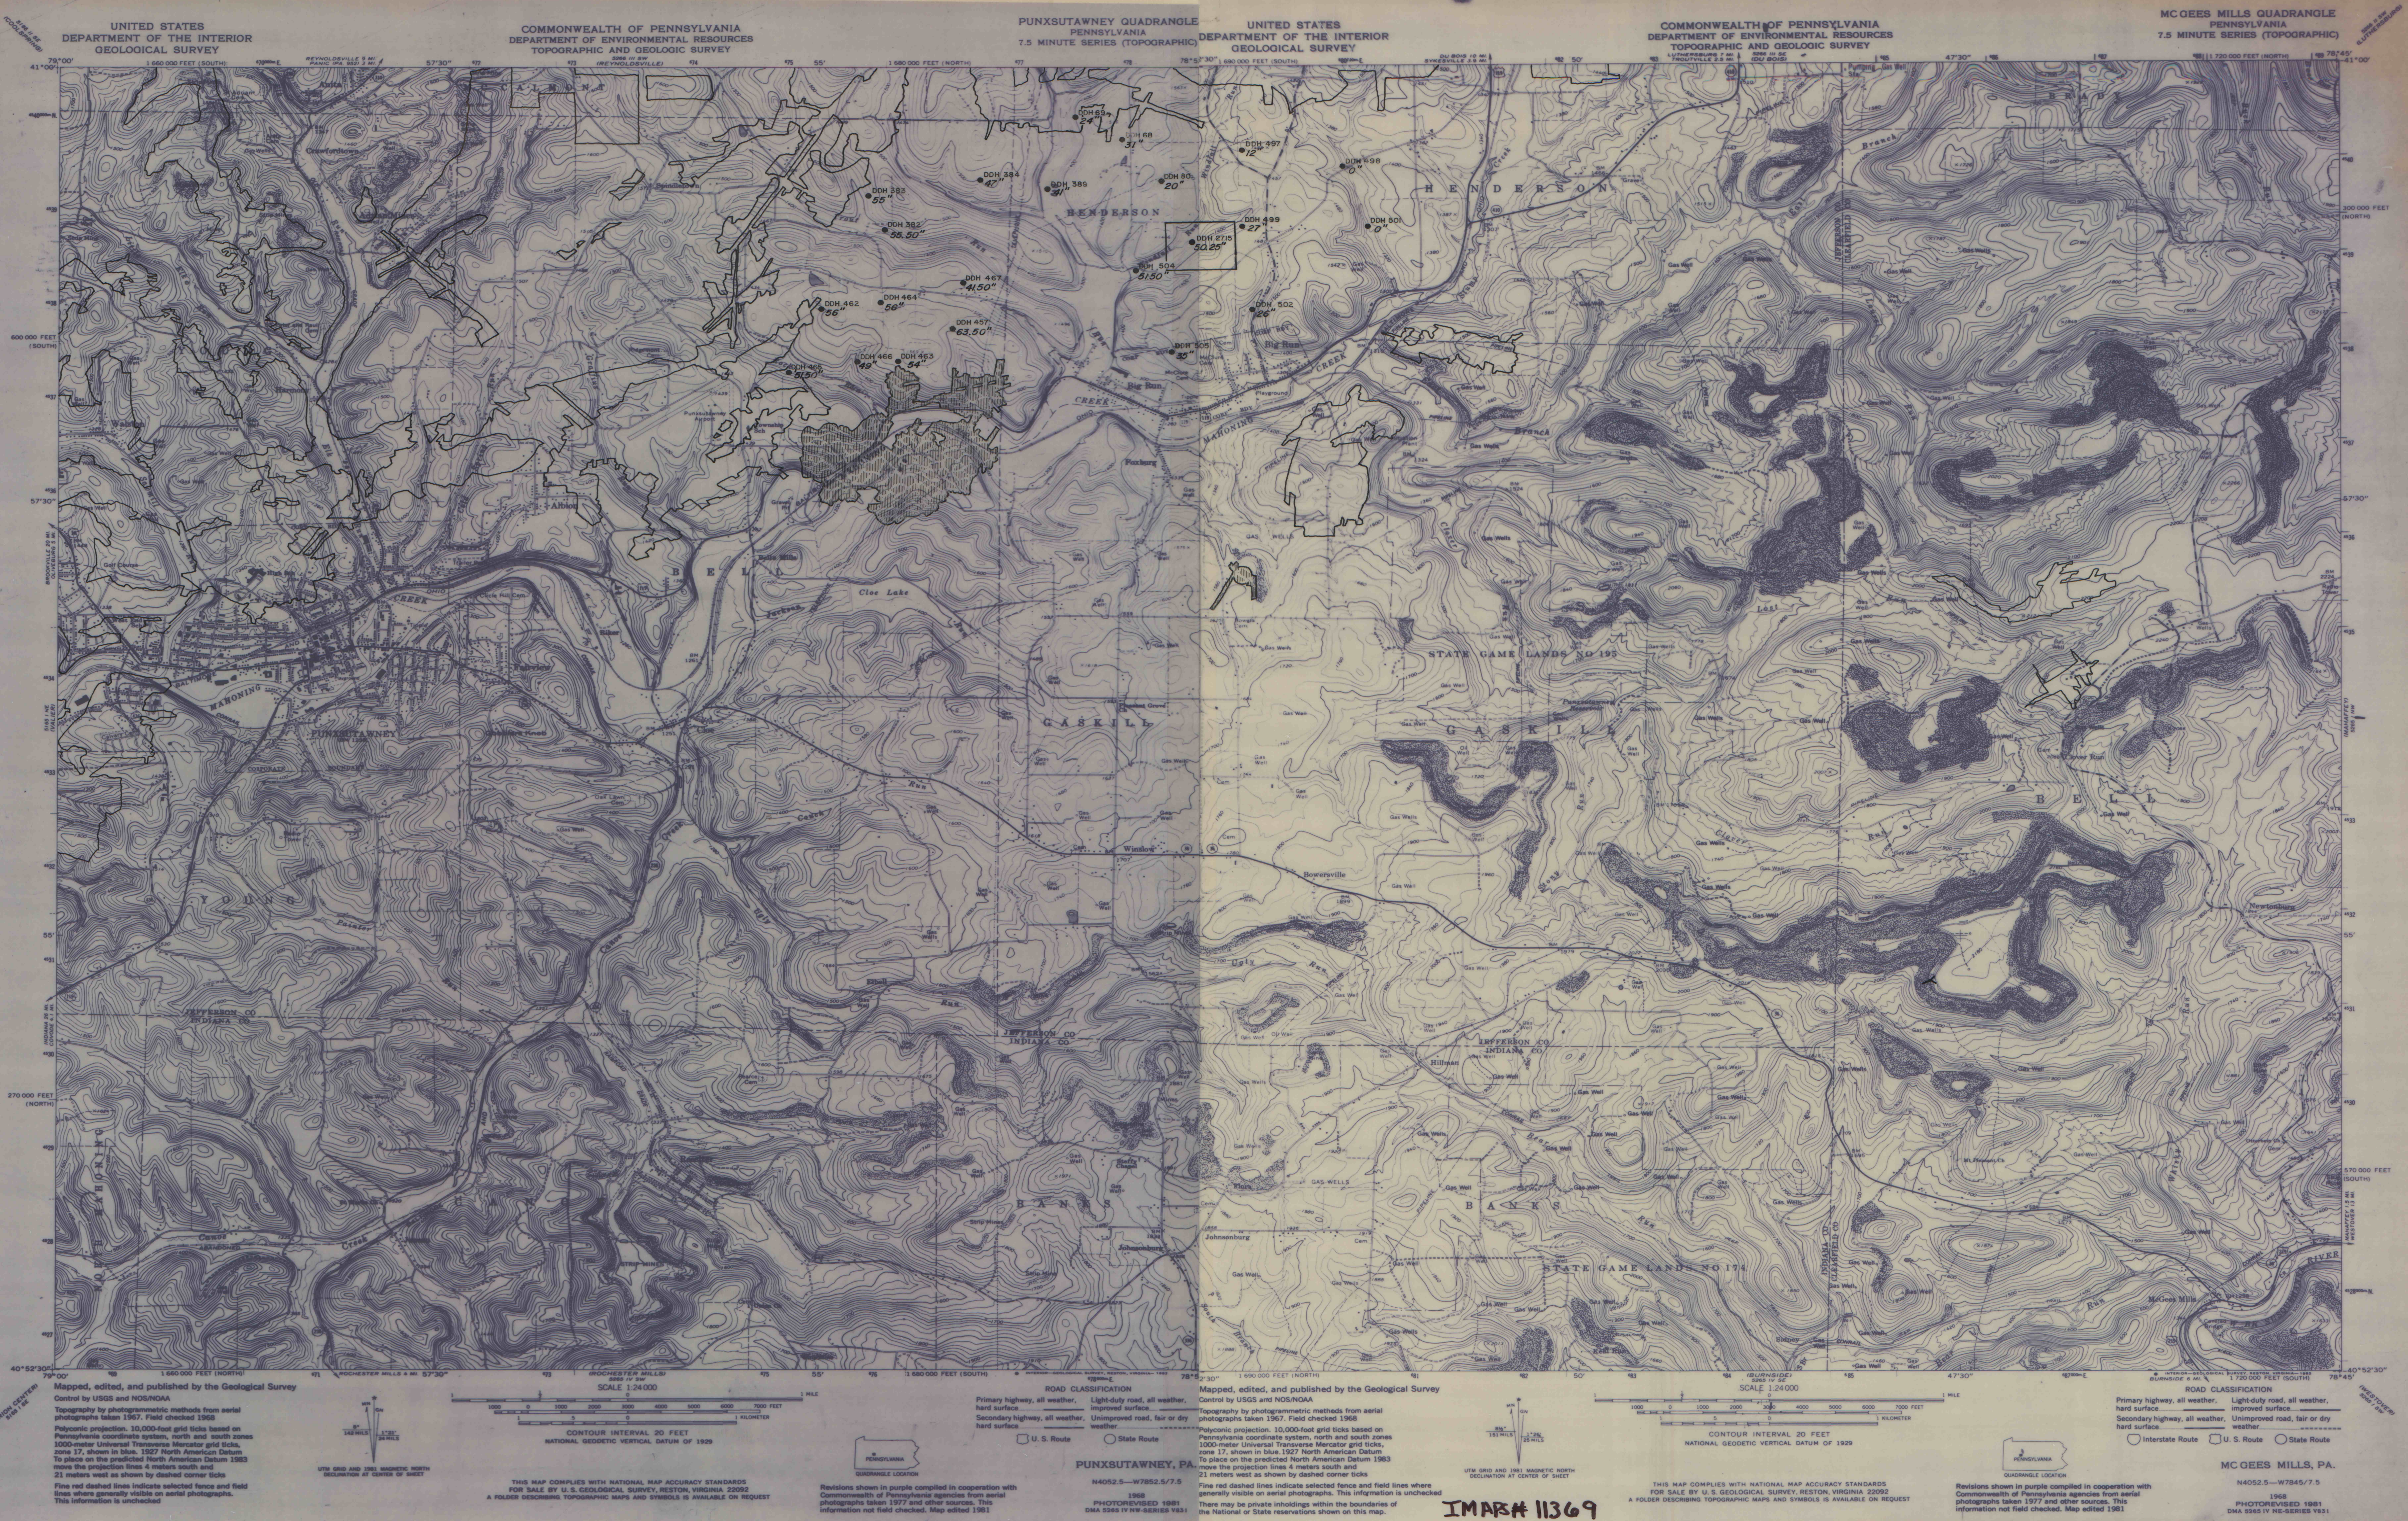

UNITED STATES DEPARTMENT OF THE INTERIOR GEOLOGICAL SURVEY  
COMMONWEALTH OF PENNSYLVANIA DEPARTMENT OF ENVIRONMENTAL RESOURCES TOPOGRAPHIC AND GEOLOGIC SURVEY  
PUNXSUTAWNEY QUADRANGLE PENNSYLVANIA 7.5 MINUTE SERIES (TOPOGRAPHIC)  
UNITED STATES DEPARTMENT OF THE INTERIOR GEOLOGICAL SURVEY  
COMMONWEALTH OF PENNSYLVANIA DEPARTMENT OF ENVIRONMENTAL RESOURCES TOPOGRAPHIC AND GEOLOGIC SURVEY  
MCGEES MILLS QUADRANGLE PENNSYLVANIA 7.5 MINUTE SERIES (TOPOGRAPHIC)

Maped, edited, and published by the Geological Survey  
Control by USGS and NOS/NOAA  
Topography by photogrammetric methods from aerial photographs taken 1967. Field checked 1968  
Polyconic projection, 10,000-foot grid ticks based on Pennsylvania coordinate system, north and south zones 1000-meter Universal Transverse Mercator grid ticks, zone 17, shown in blue. 1927 North American Datum. To place on the predicted North American Datum 1983 move the projection lines 4 meters south and 21 meters west as shown by dashed corner ticks. Fine red dashed lines indicate selected fence and field lines where generally visible on aerial photographs. This information is unchecked.

Maped, edited, and published by the Geological Survey  
Control by USGS and NOS/NOAA  
Topography by photogrammetric methods from aerial photographs taken 1967. Field checked 1968  
Polyconic projection, 10,000-foot grid ticks based on Pennsylvania coordinate system, north and south zones 1000-meter Universal Transverse Mercator grid ticks, zone 17, shown in blue. 1927 North American Datum. To place on the predicted North American Datum 1983 move the projection lines 4 meters south and 21 meters west as shown by dashed corner ticks. Fine red dashed lines indicate selected fence and field lines where generally visible on aerial photographs. This information is unchecked.

Revisions shown in purple compiled in cooperation with Commonwealth of Pennsylvania agencies from aerial photographs taken 1977 and other sources. This information not field checked. Map edited 1981.

Revisions shown in purple compiled in cooperation with Commonwealth of Pennsylvania agencies from aerial photographs taken 1977 and other sources. This information not field checked. Map edited 1981.

IMAR# 11369