


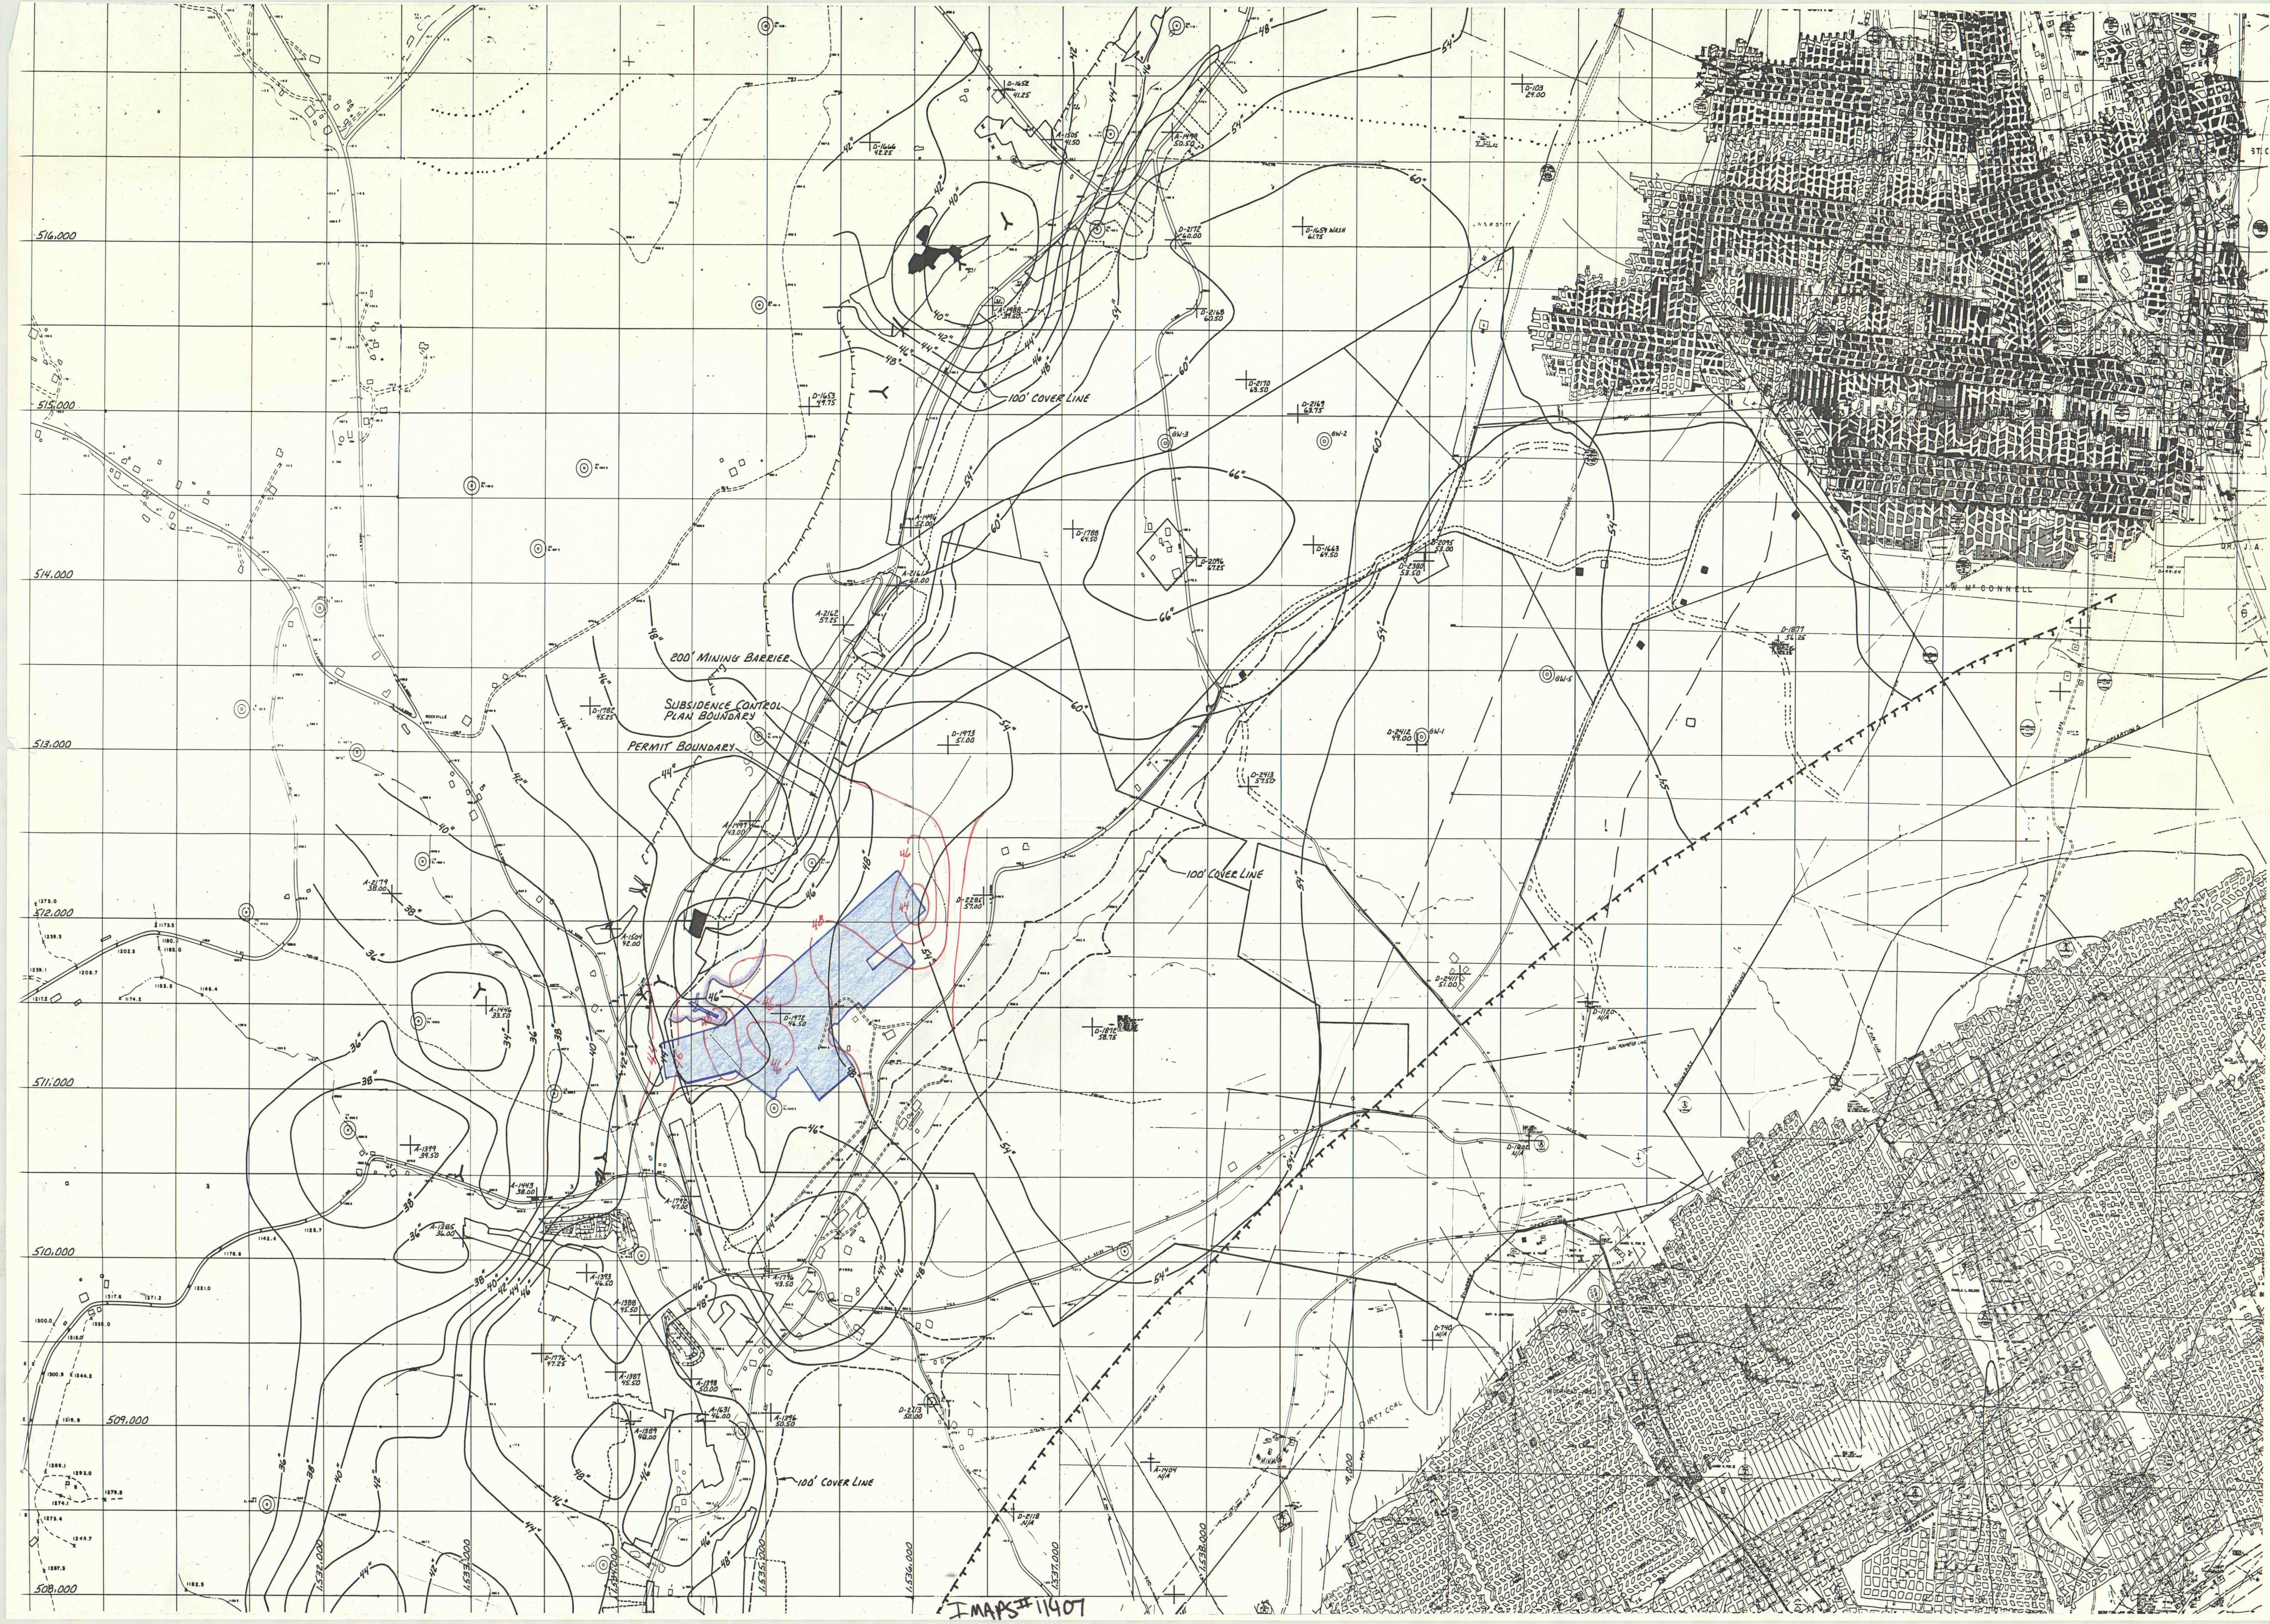

MAPS# 11907