


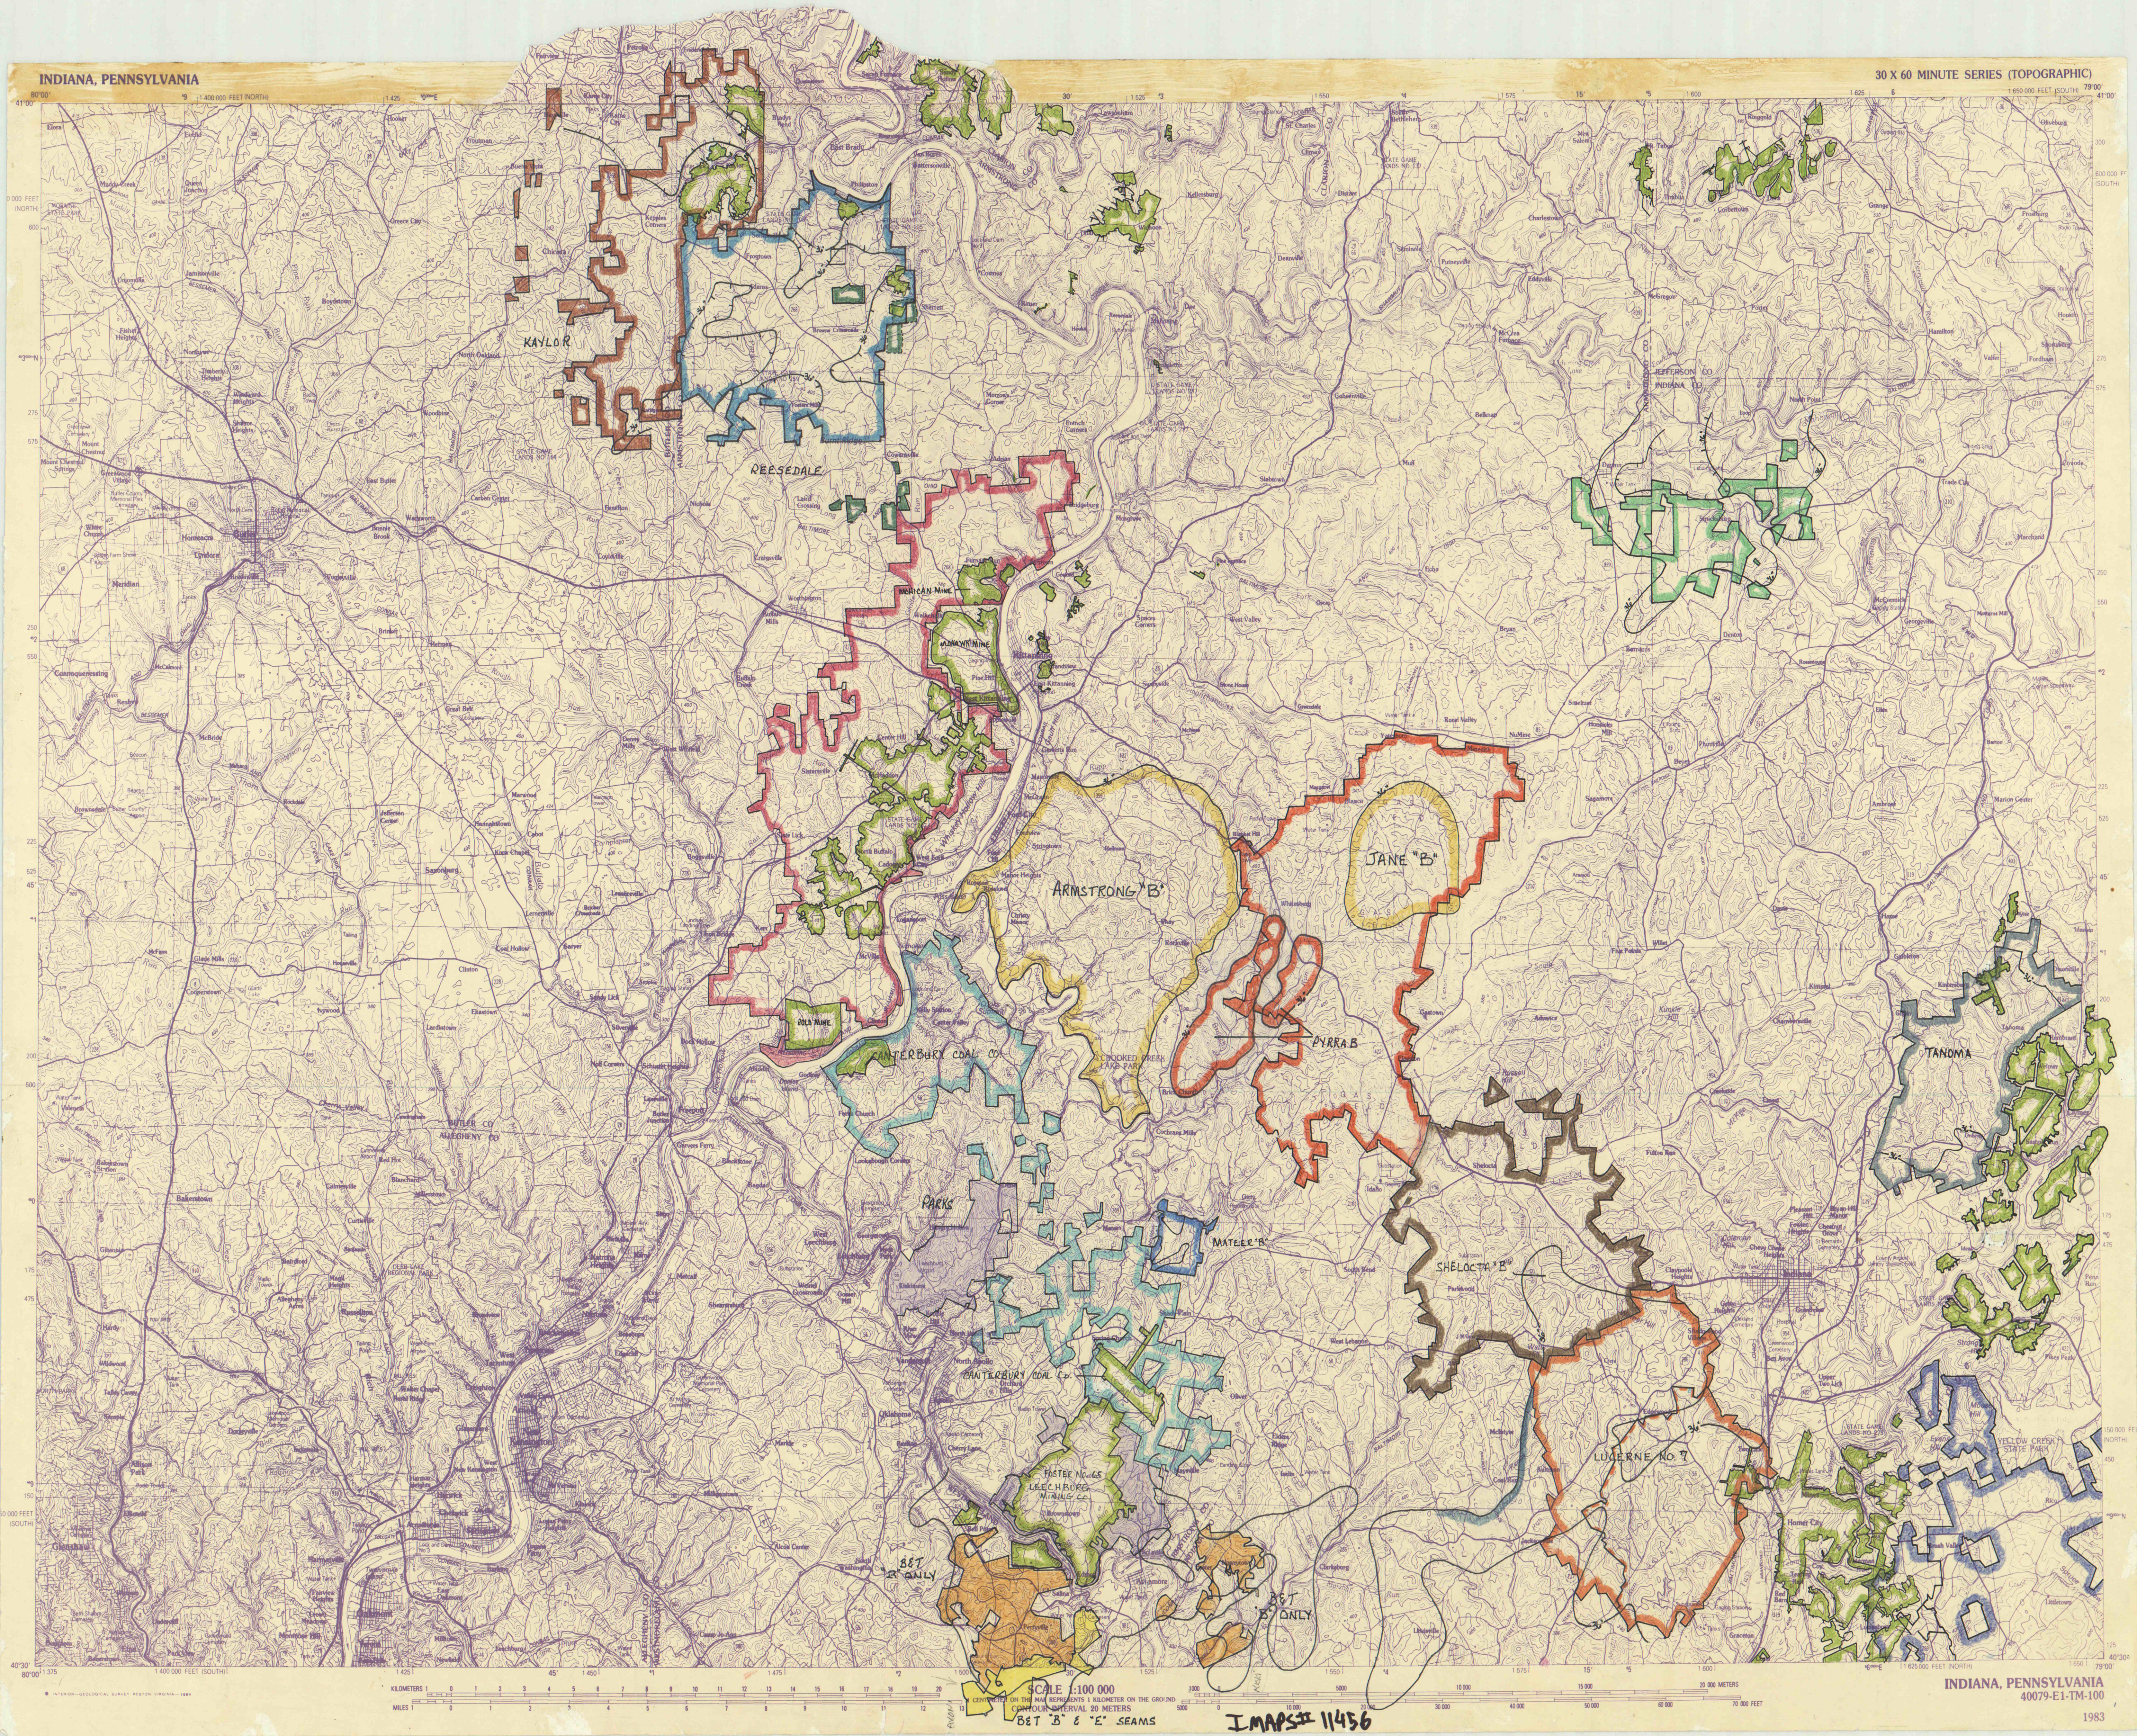

SCALE 1:100,000
CONTAINING INTERVAL 20 METERS
BET "B" & "E" SEAMS

I MAPS# 11456