


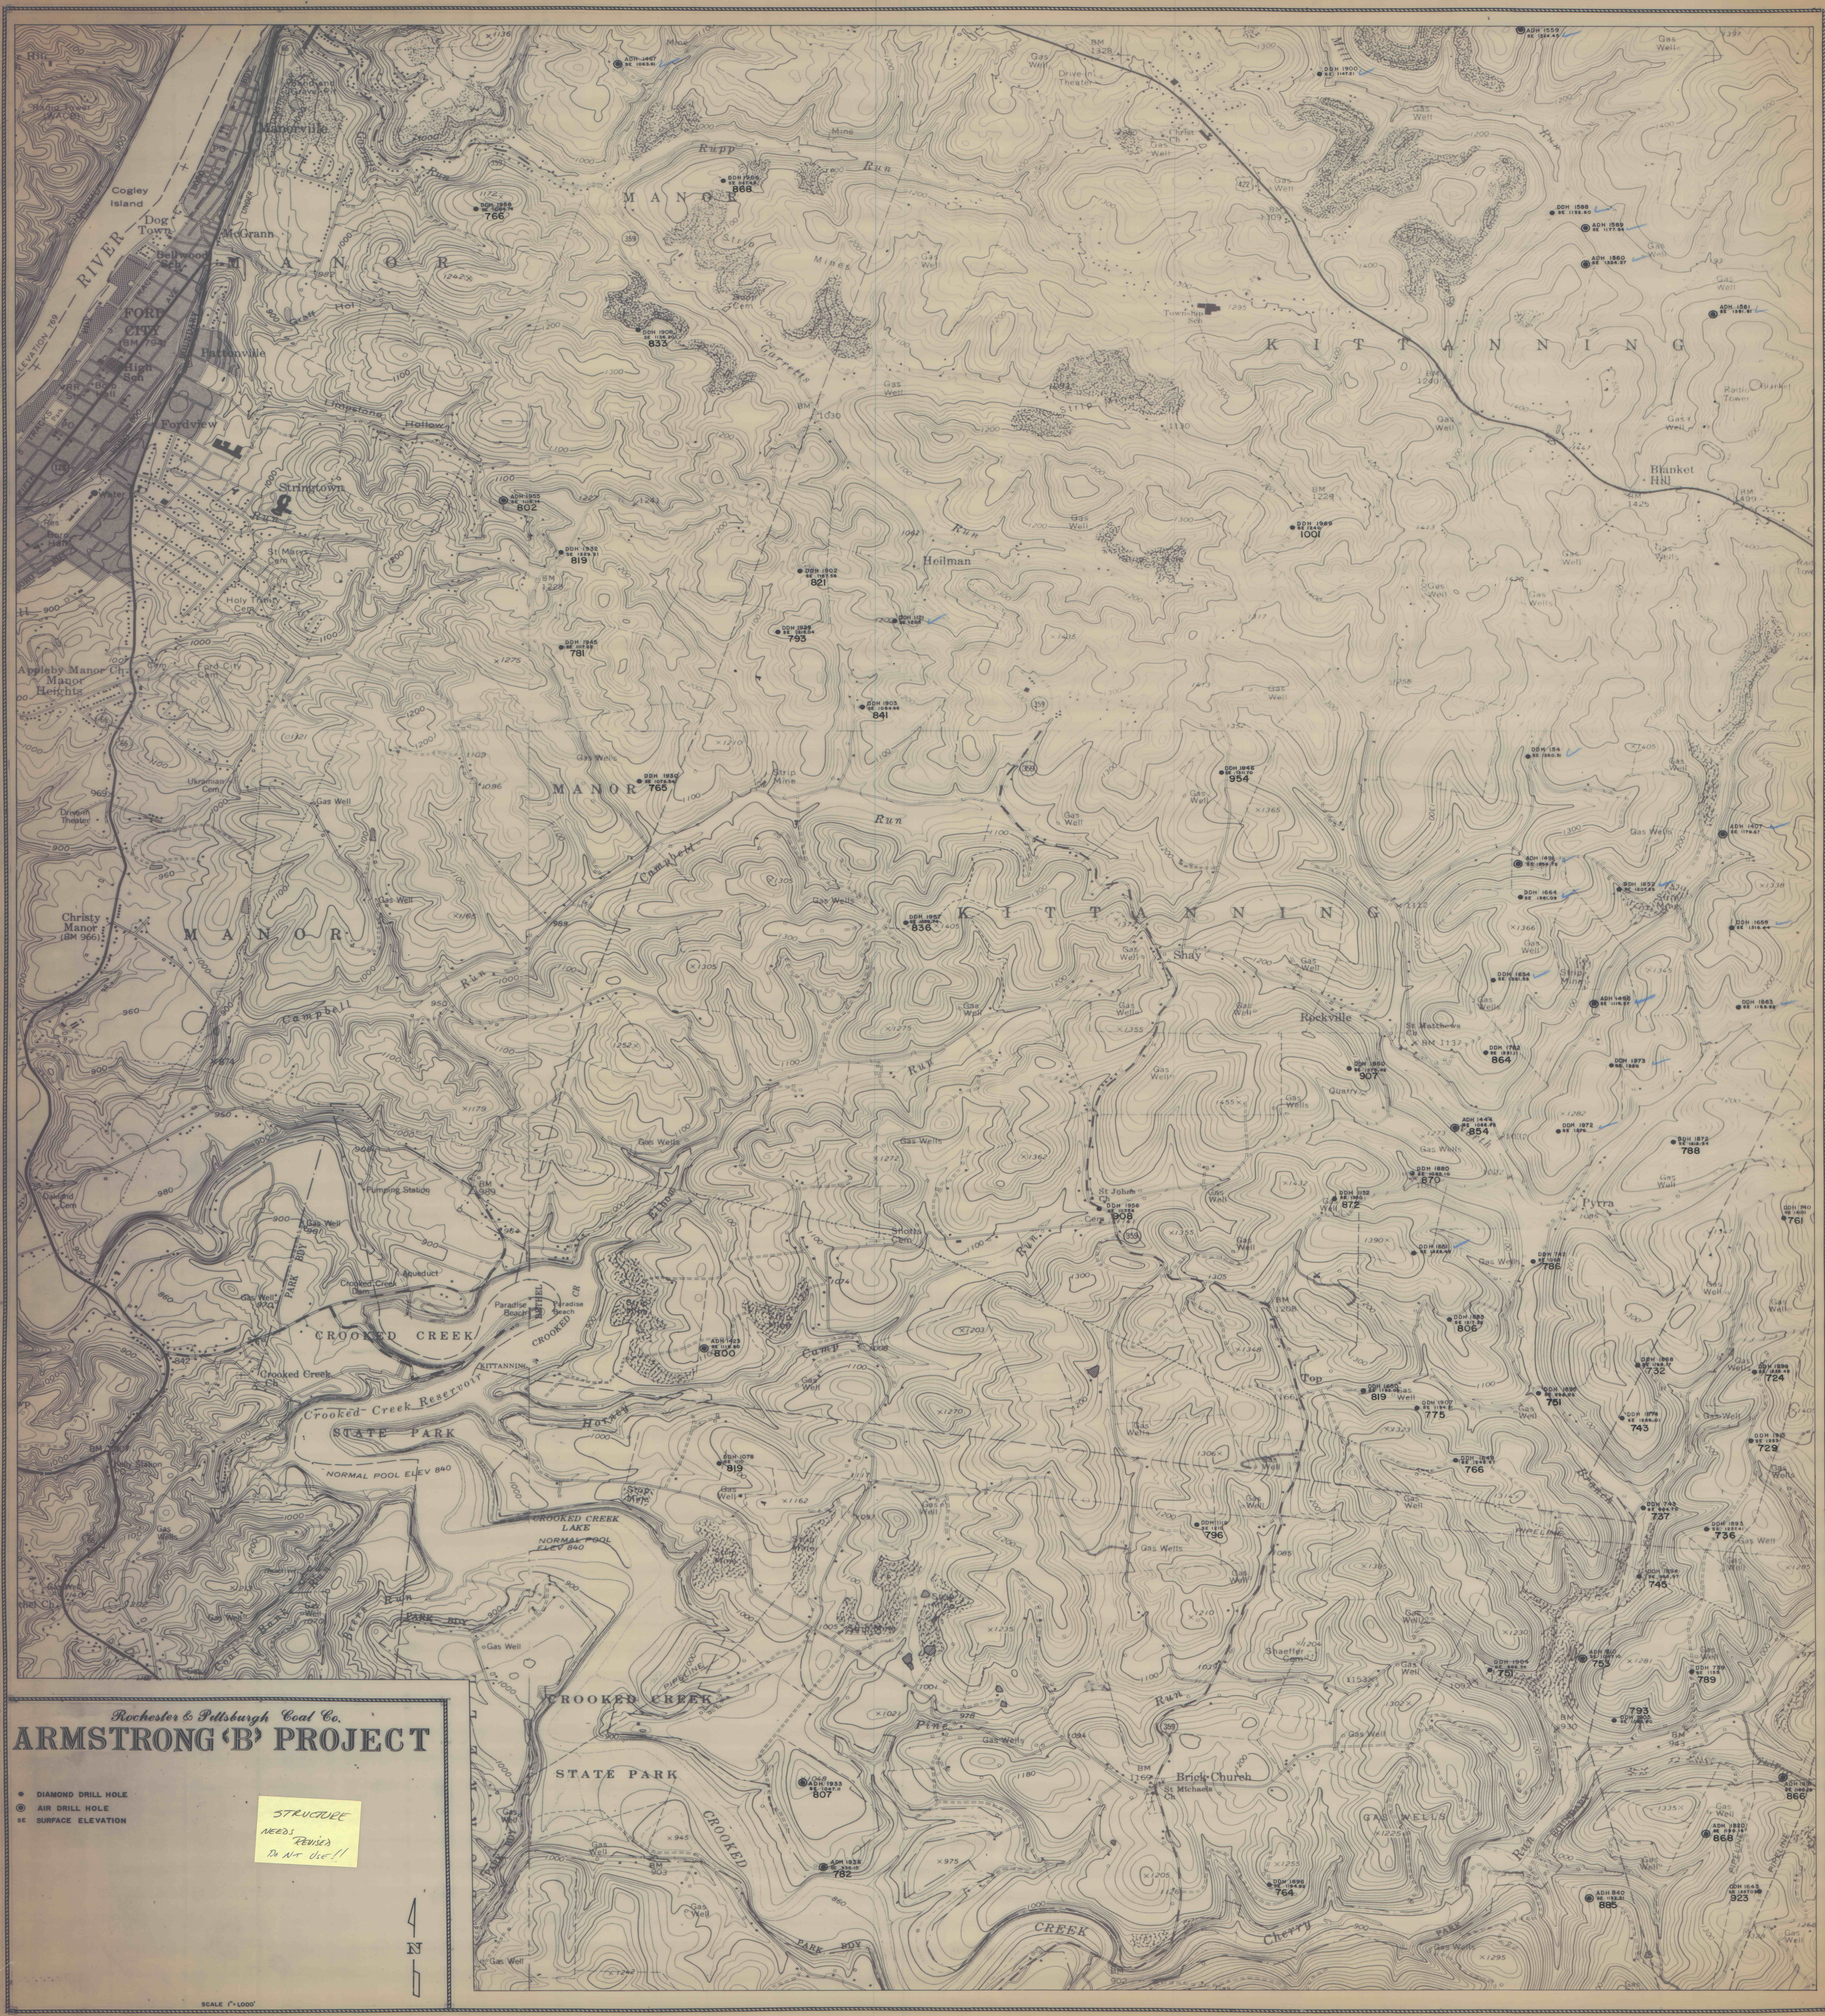

Rochester & Pittsburgh Coal Co.
ARMSTRONG 'B' PROJECT

● DIAMOND DRILL HOLE
○ AIR DRILL HOLE
SE SURFACE ELEVATION

STRUCTURE
NEEDS
REVISION
DO NOT USE!!

SCALE 1"=1000'

N