

51651 SW
(PLUMVILLE)

659000m.F

PLUMVILLE 5 MI.

660


661

54

PUNXSUTAWNEY 19 MI.
MARION CENTER 28 MI.

600

5165 I SE
(MARION CENTE

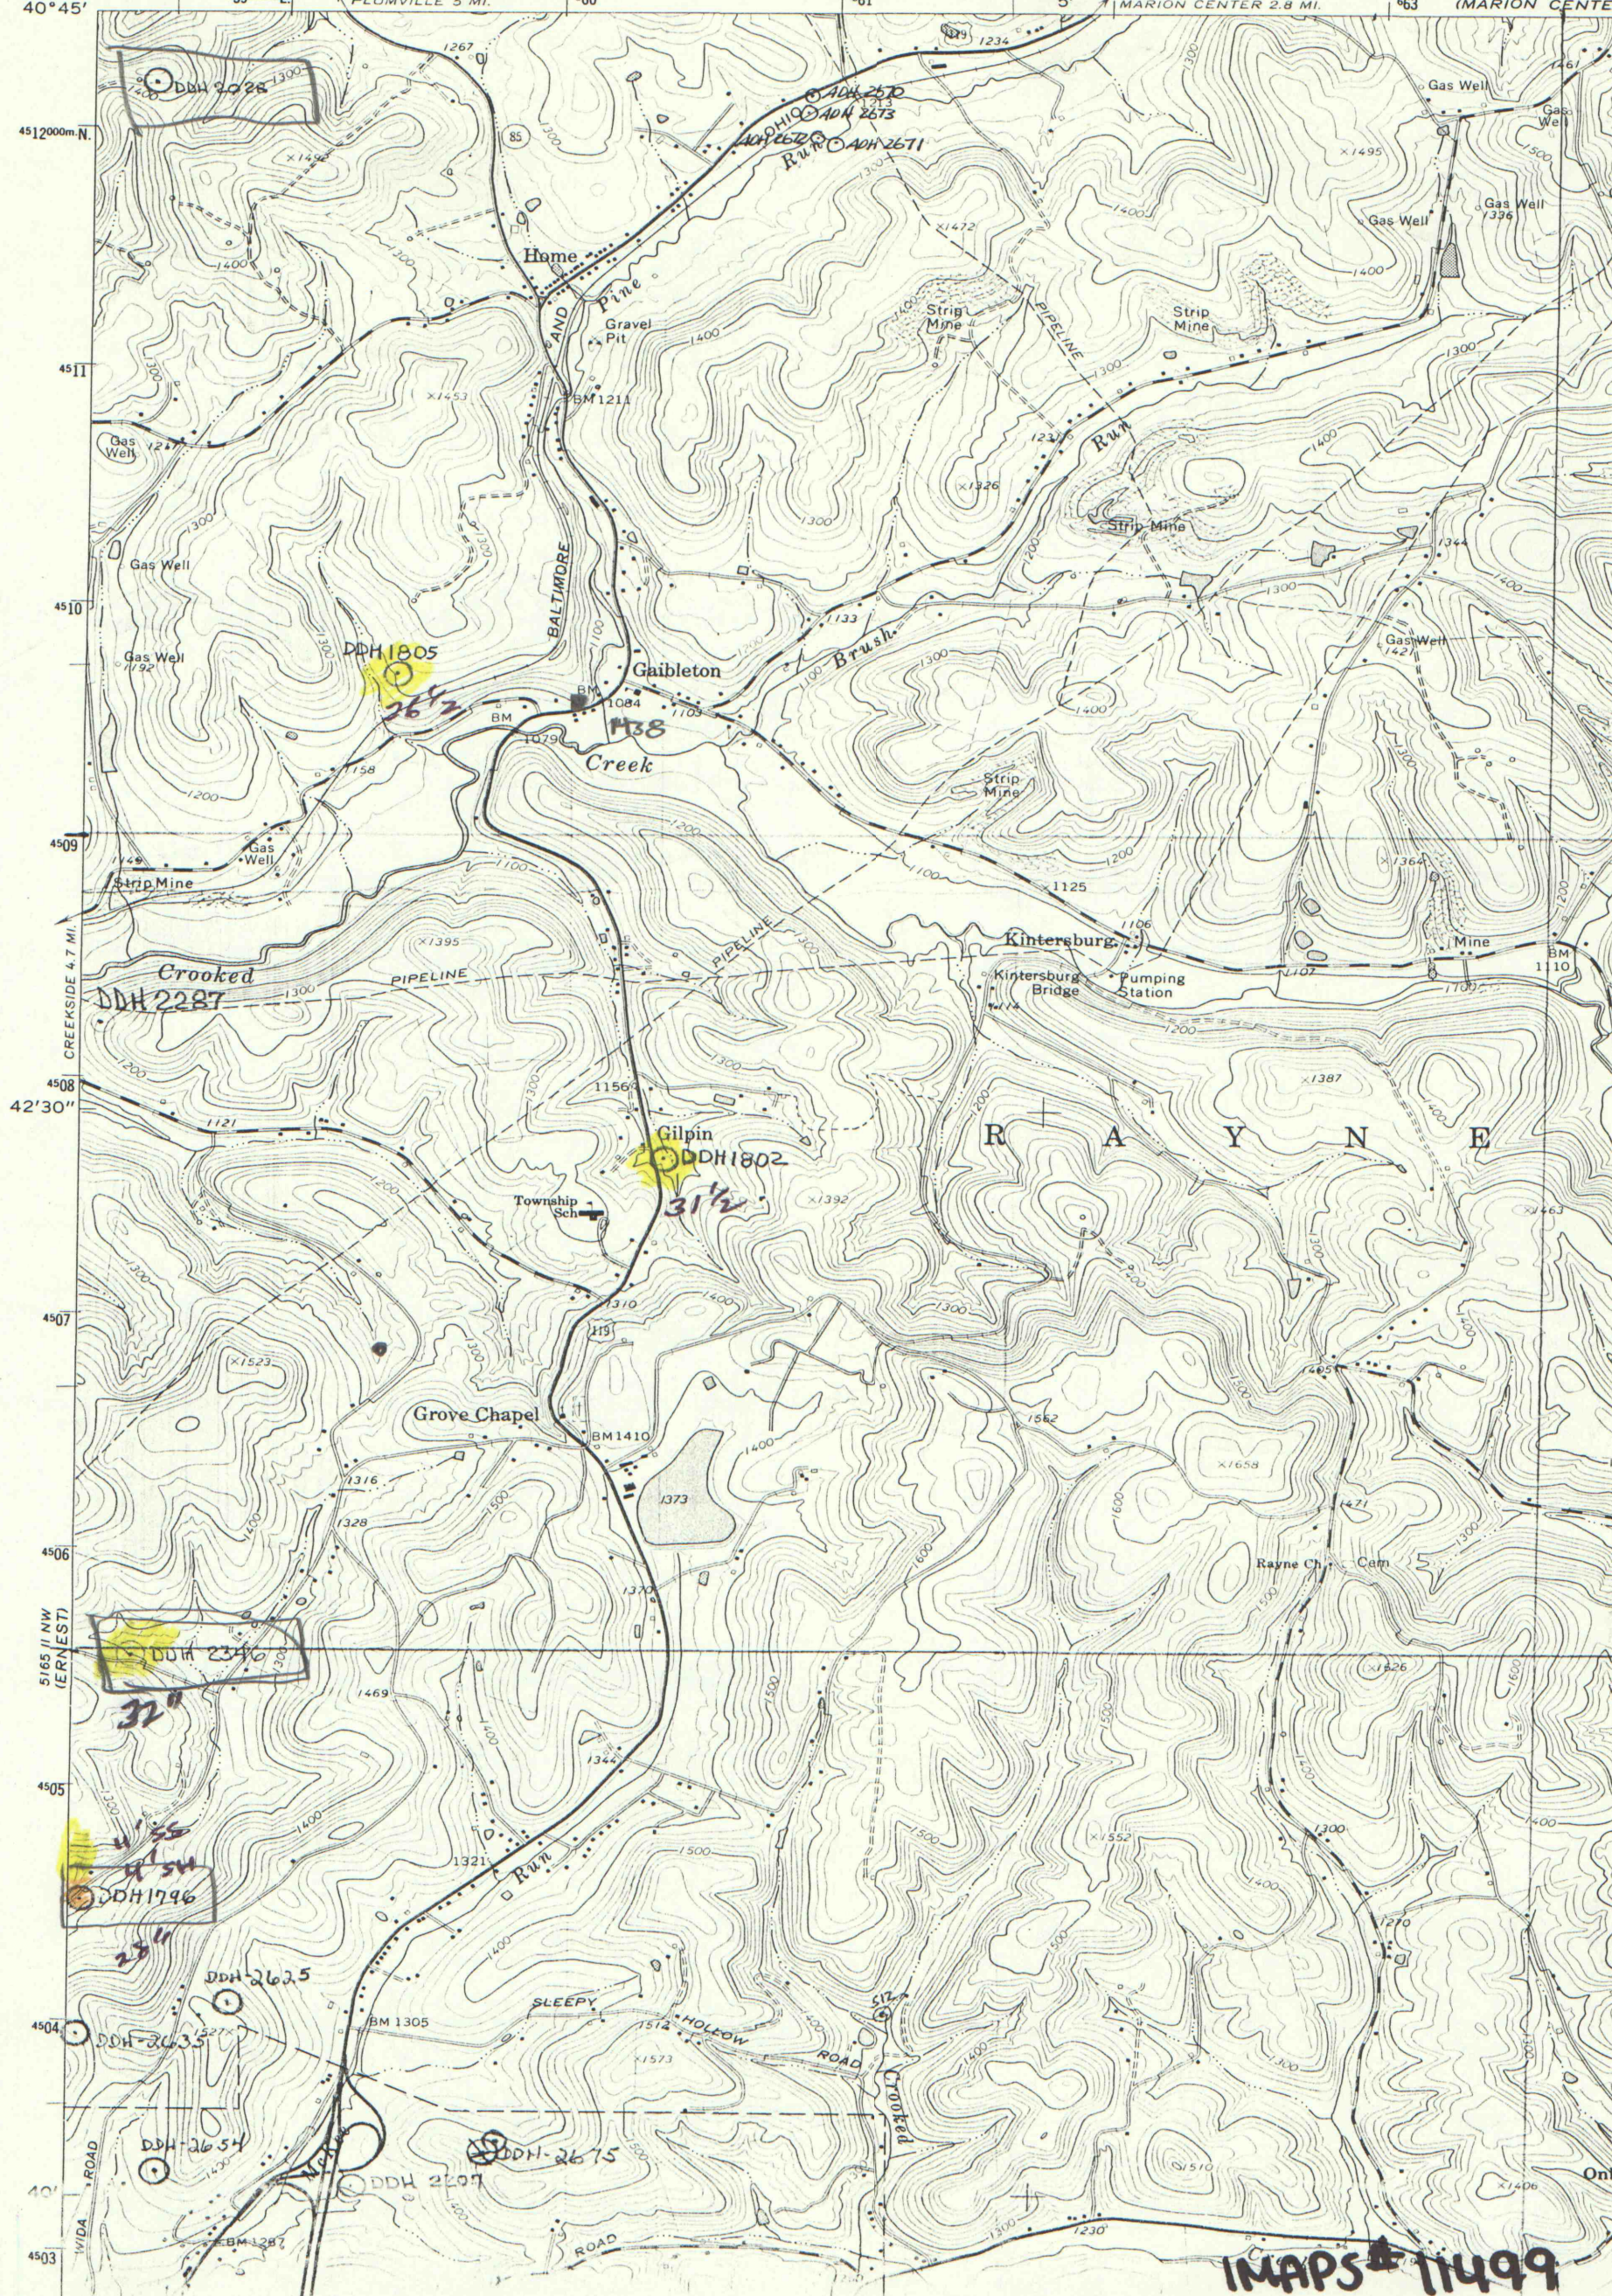

MAPS # 11499