


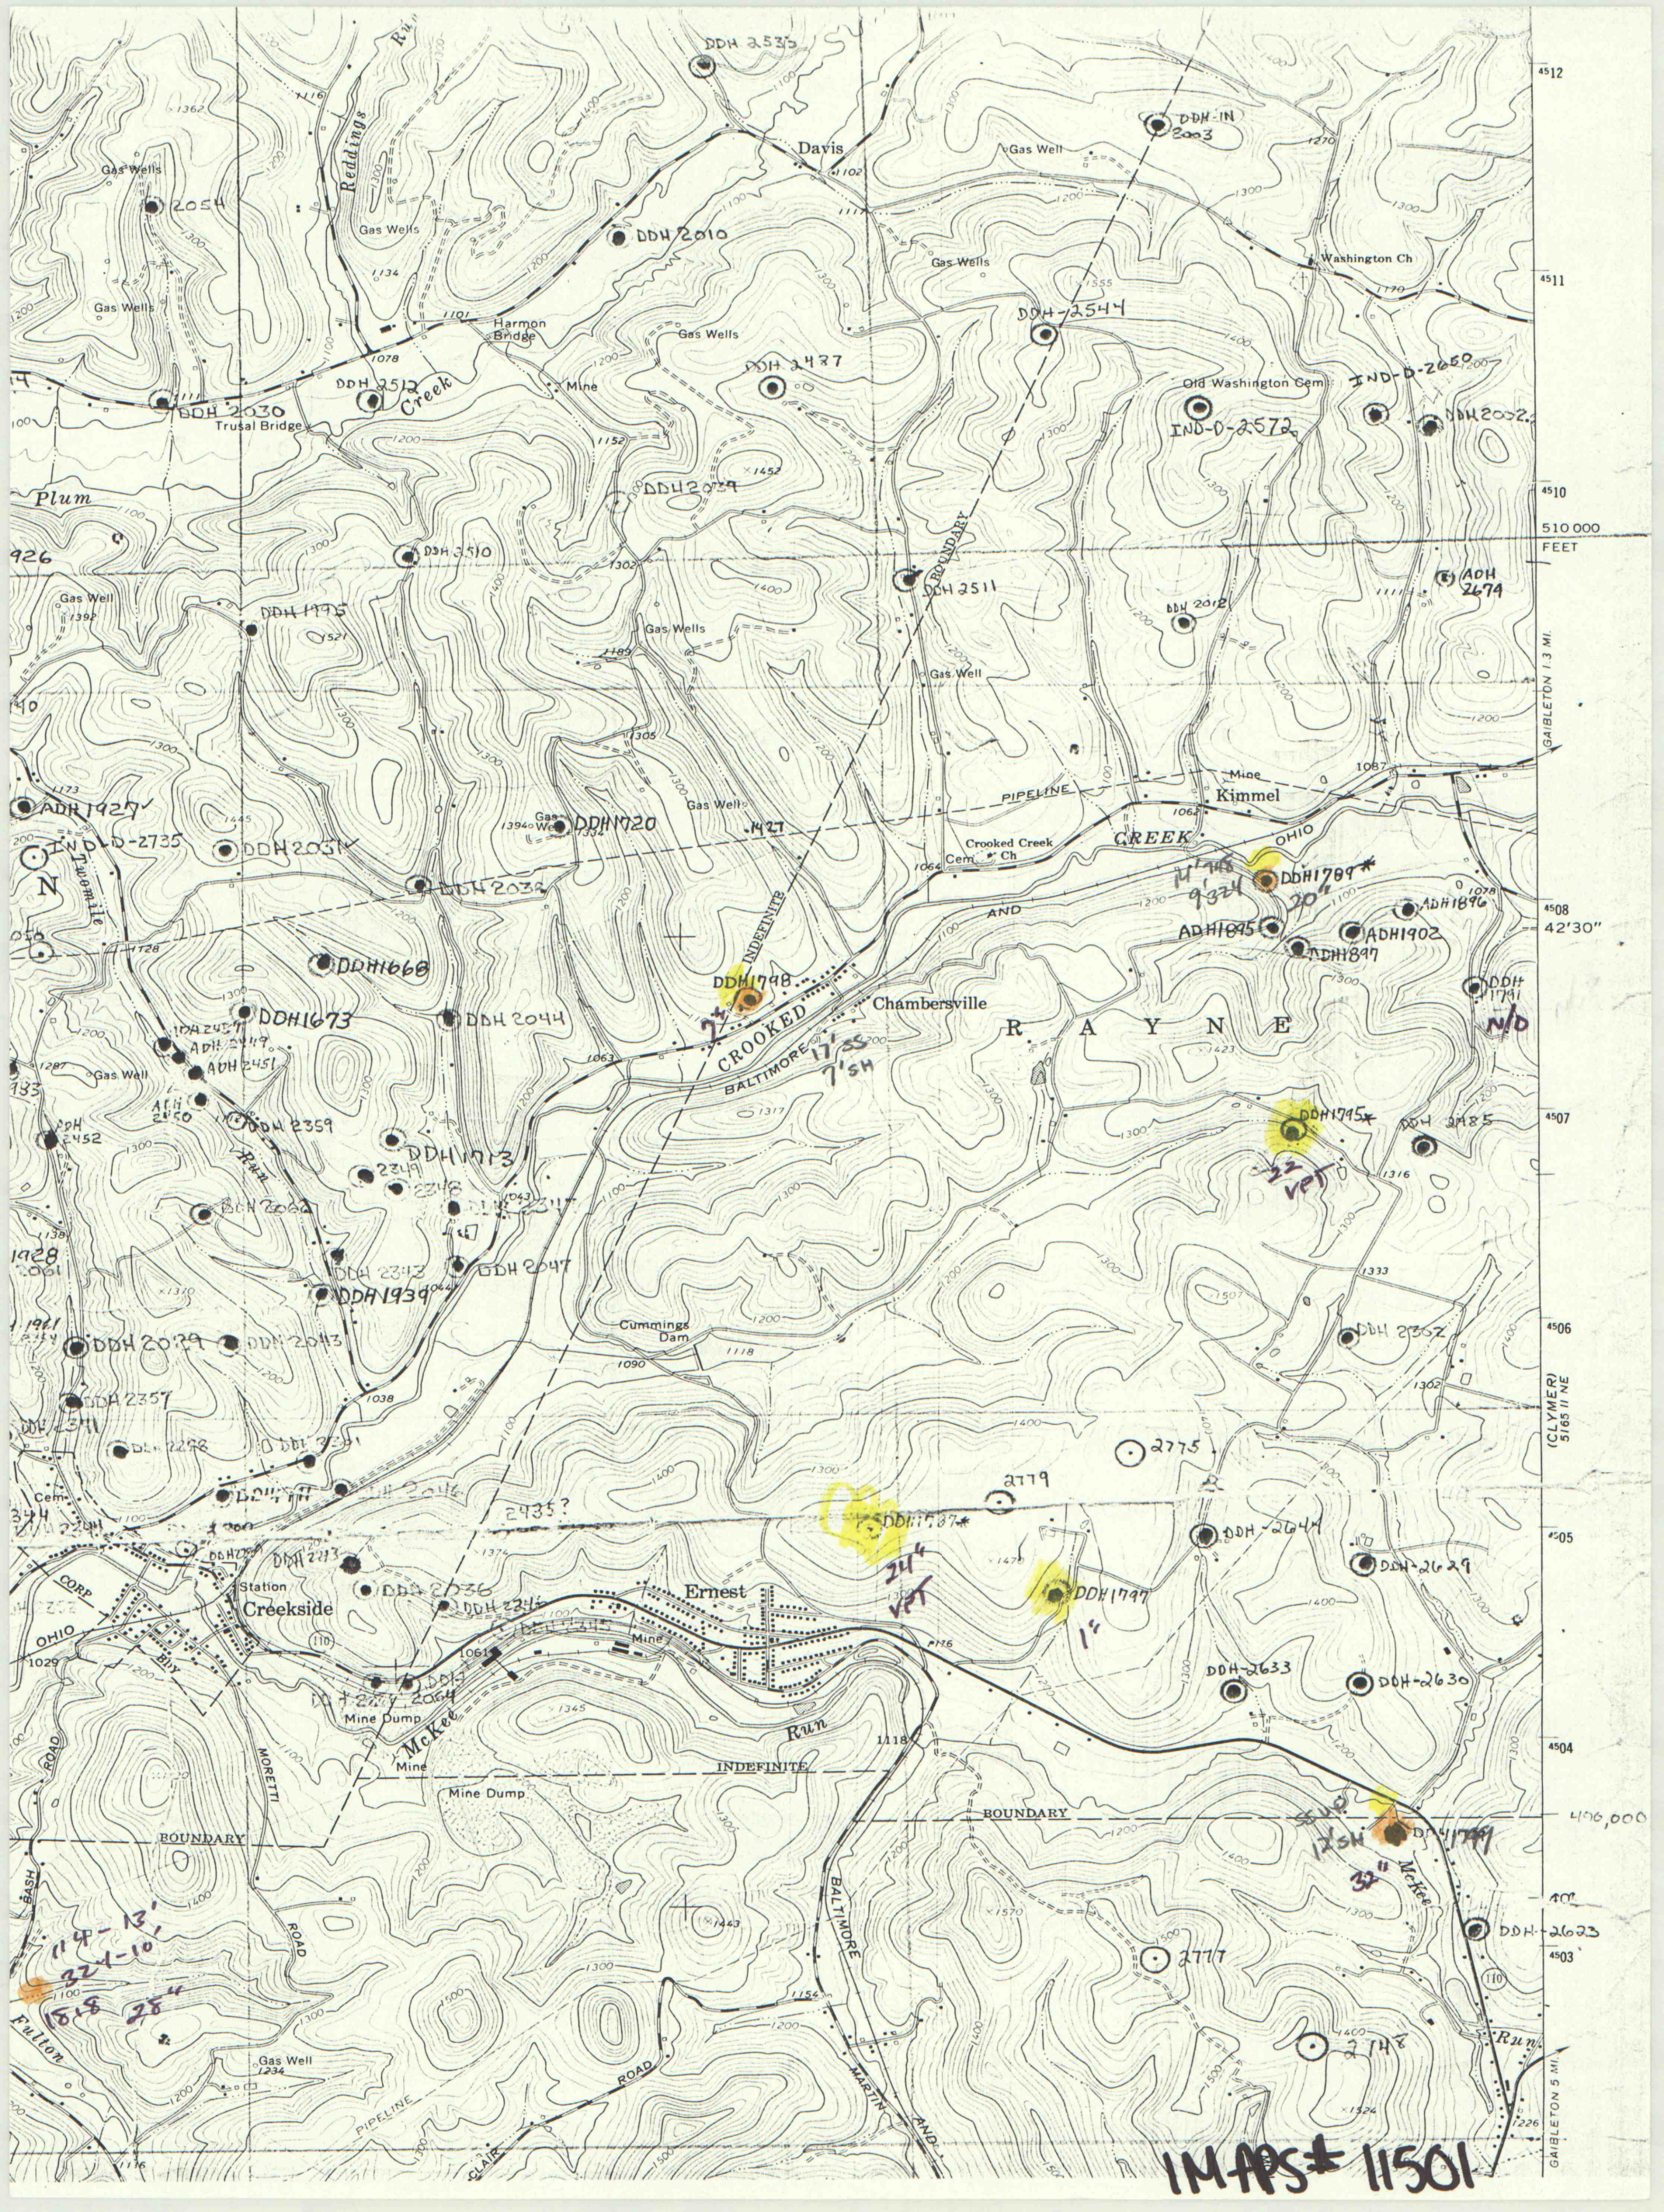

INARS# 11501