


(KITTANNING 1:62 500)

32'30"

1 510 000 FEET

79°30' 40°52'30"

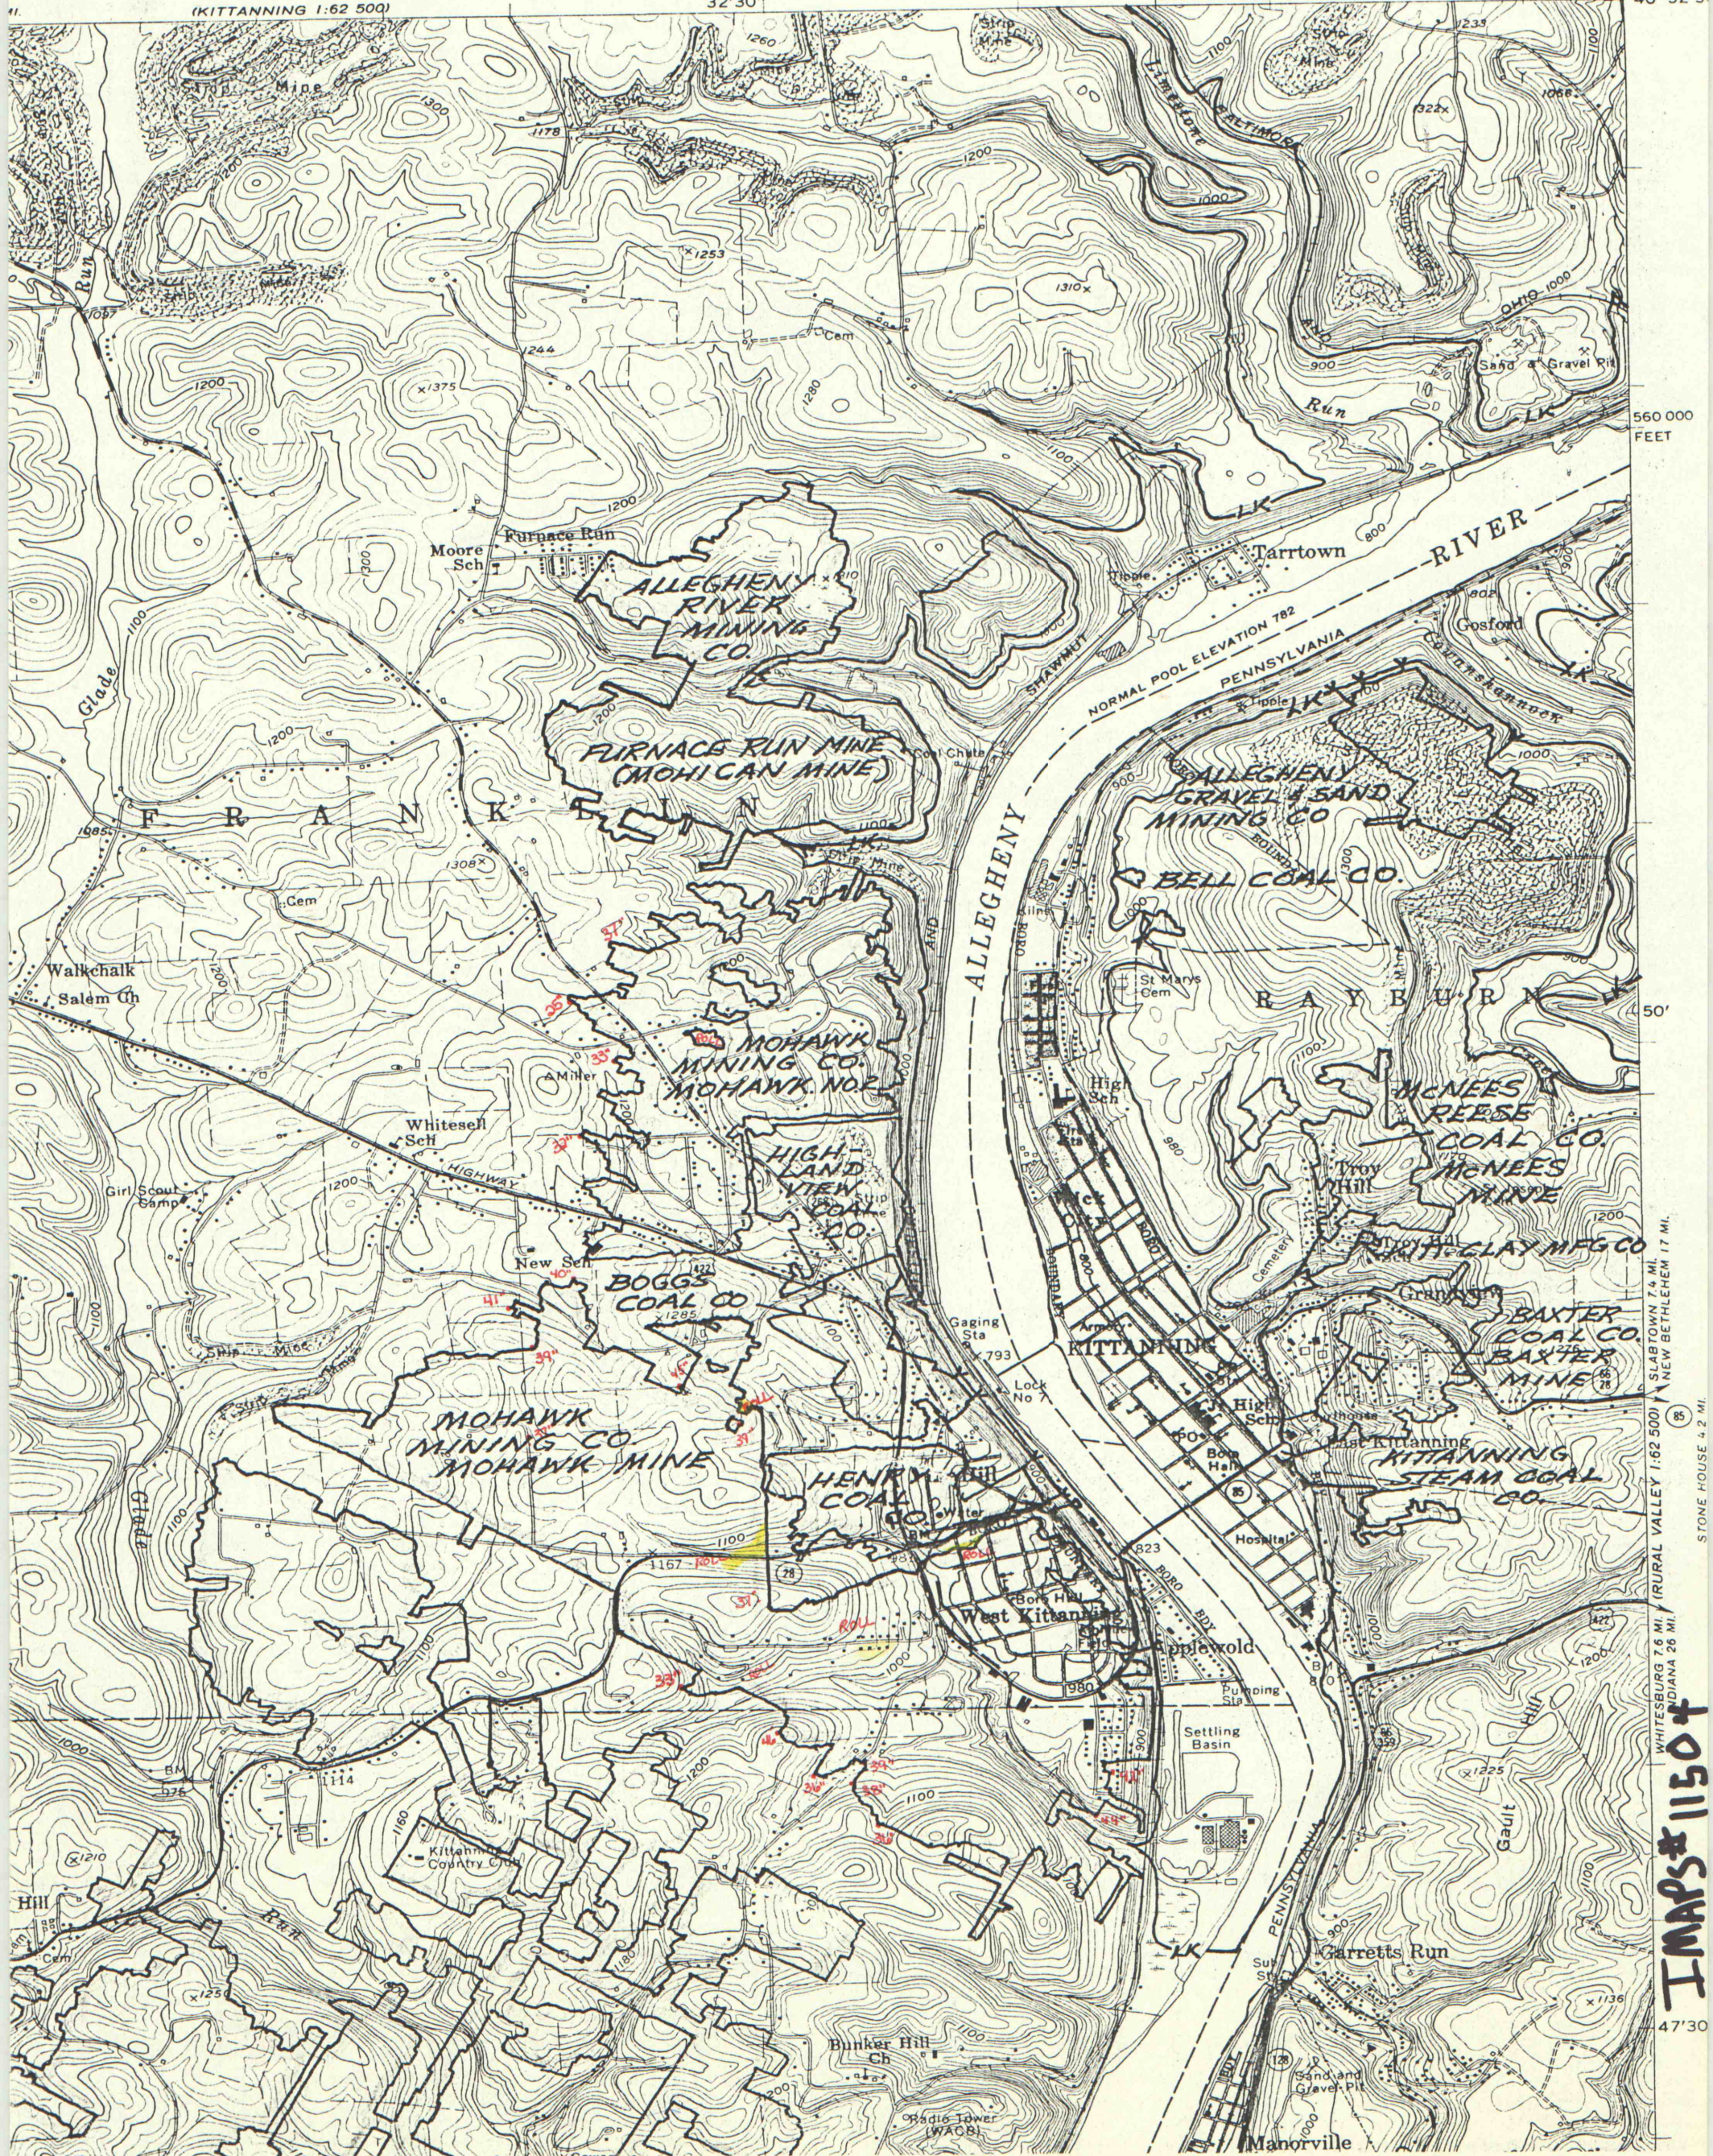

SLABTOWN 7.4 MI.
NEW BETHLEHEM 17 MI.
STONE HOUSE 4.2 MI.

IMAPS#11504

47°30'