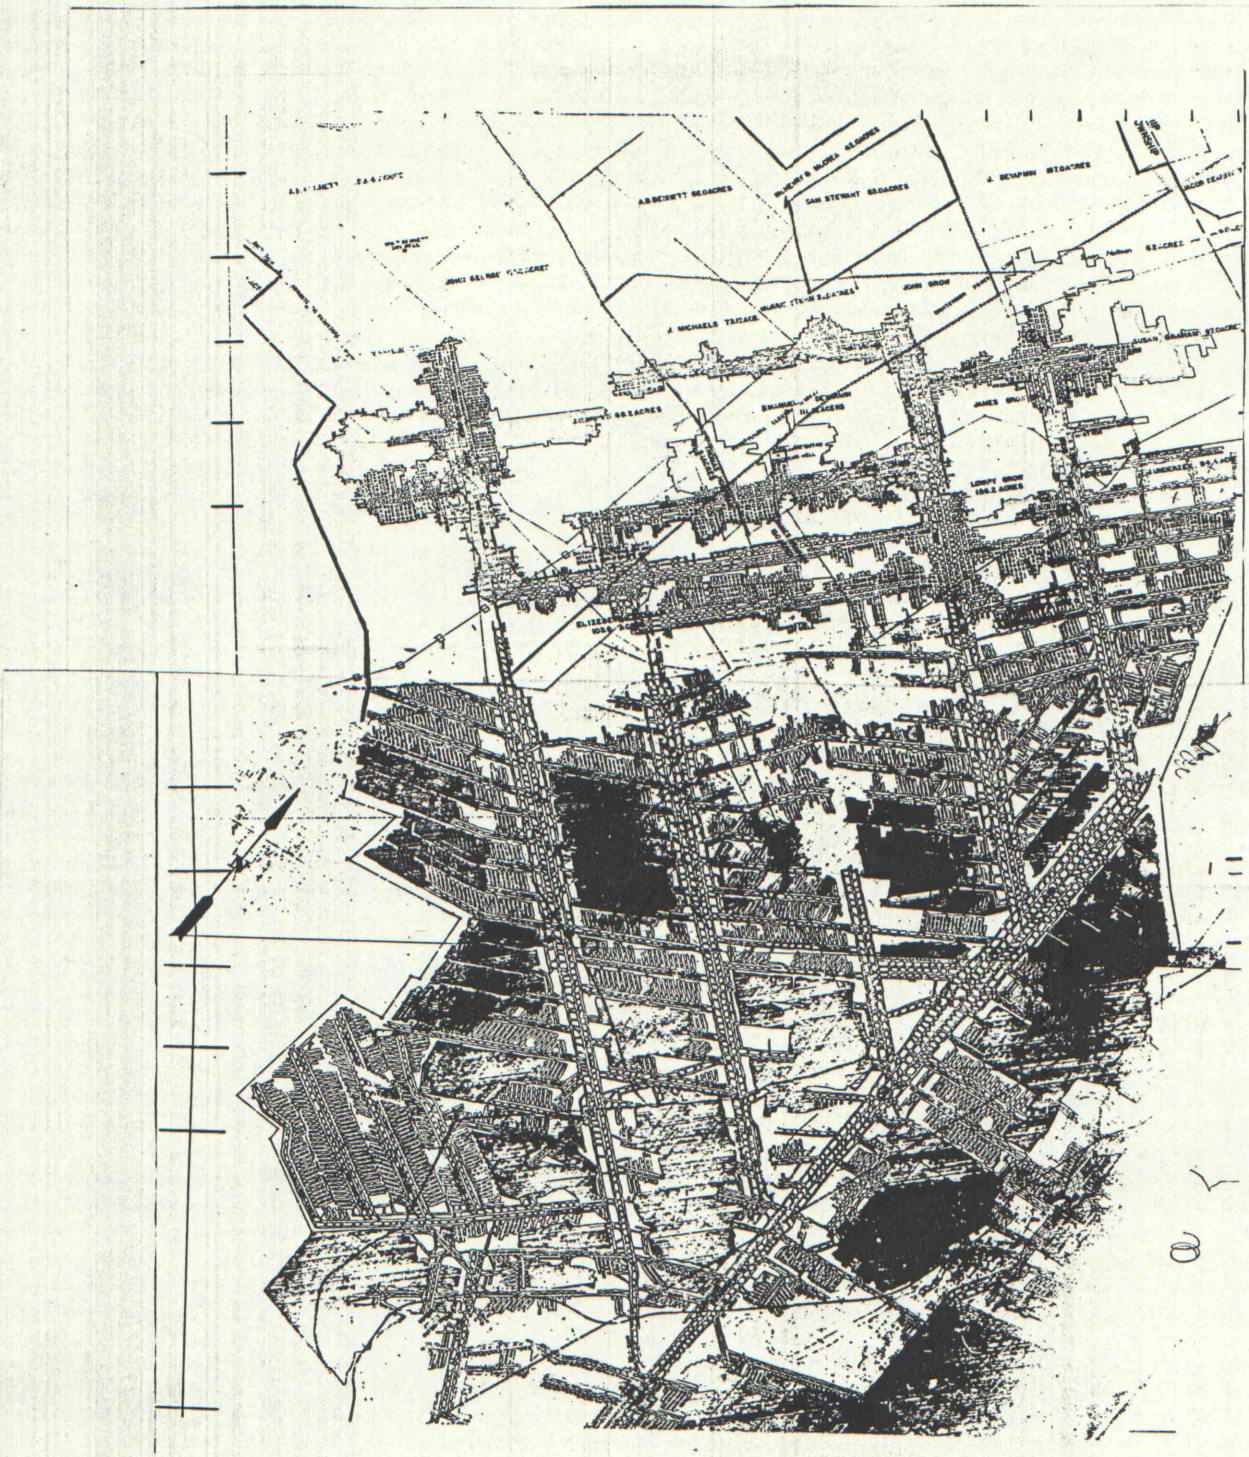
A.R.BENNETT 60.0ACRES
SAM STEWART 60.0ACRES
J. BENJAMIN 60.0ACRES
JOHN GROW
J. MICHAELS TRUSTEE
LIBERTY GROVE 100.0ACRES

IMAPS # 11514