



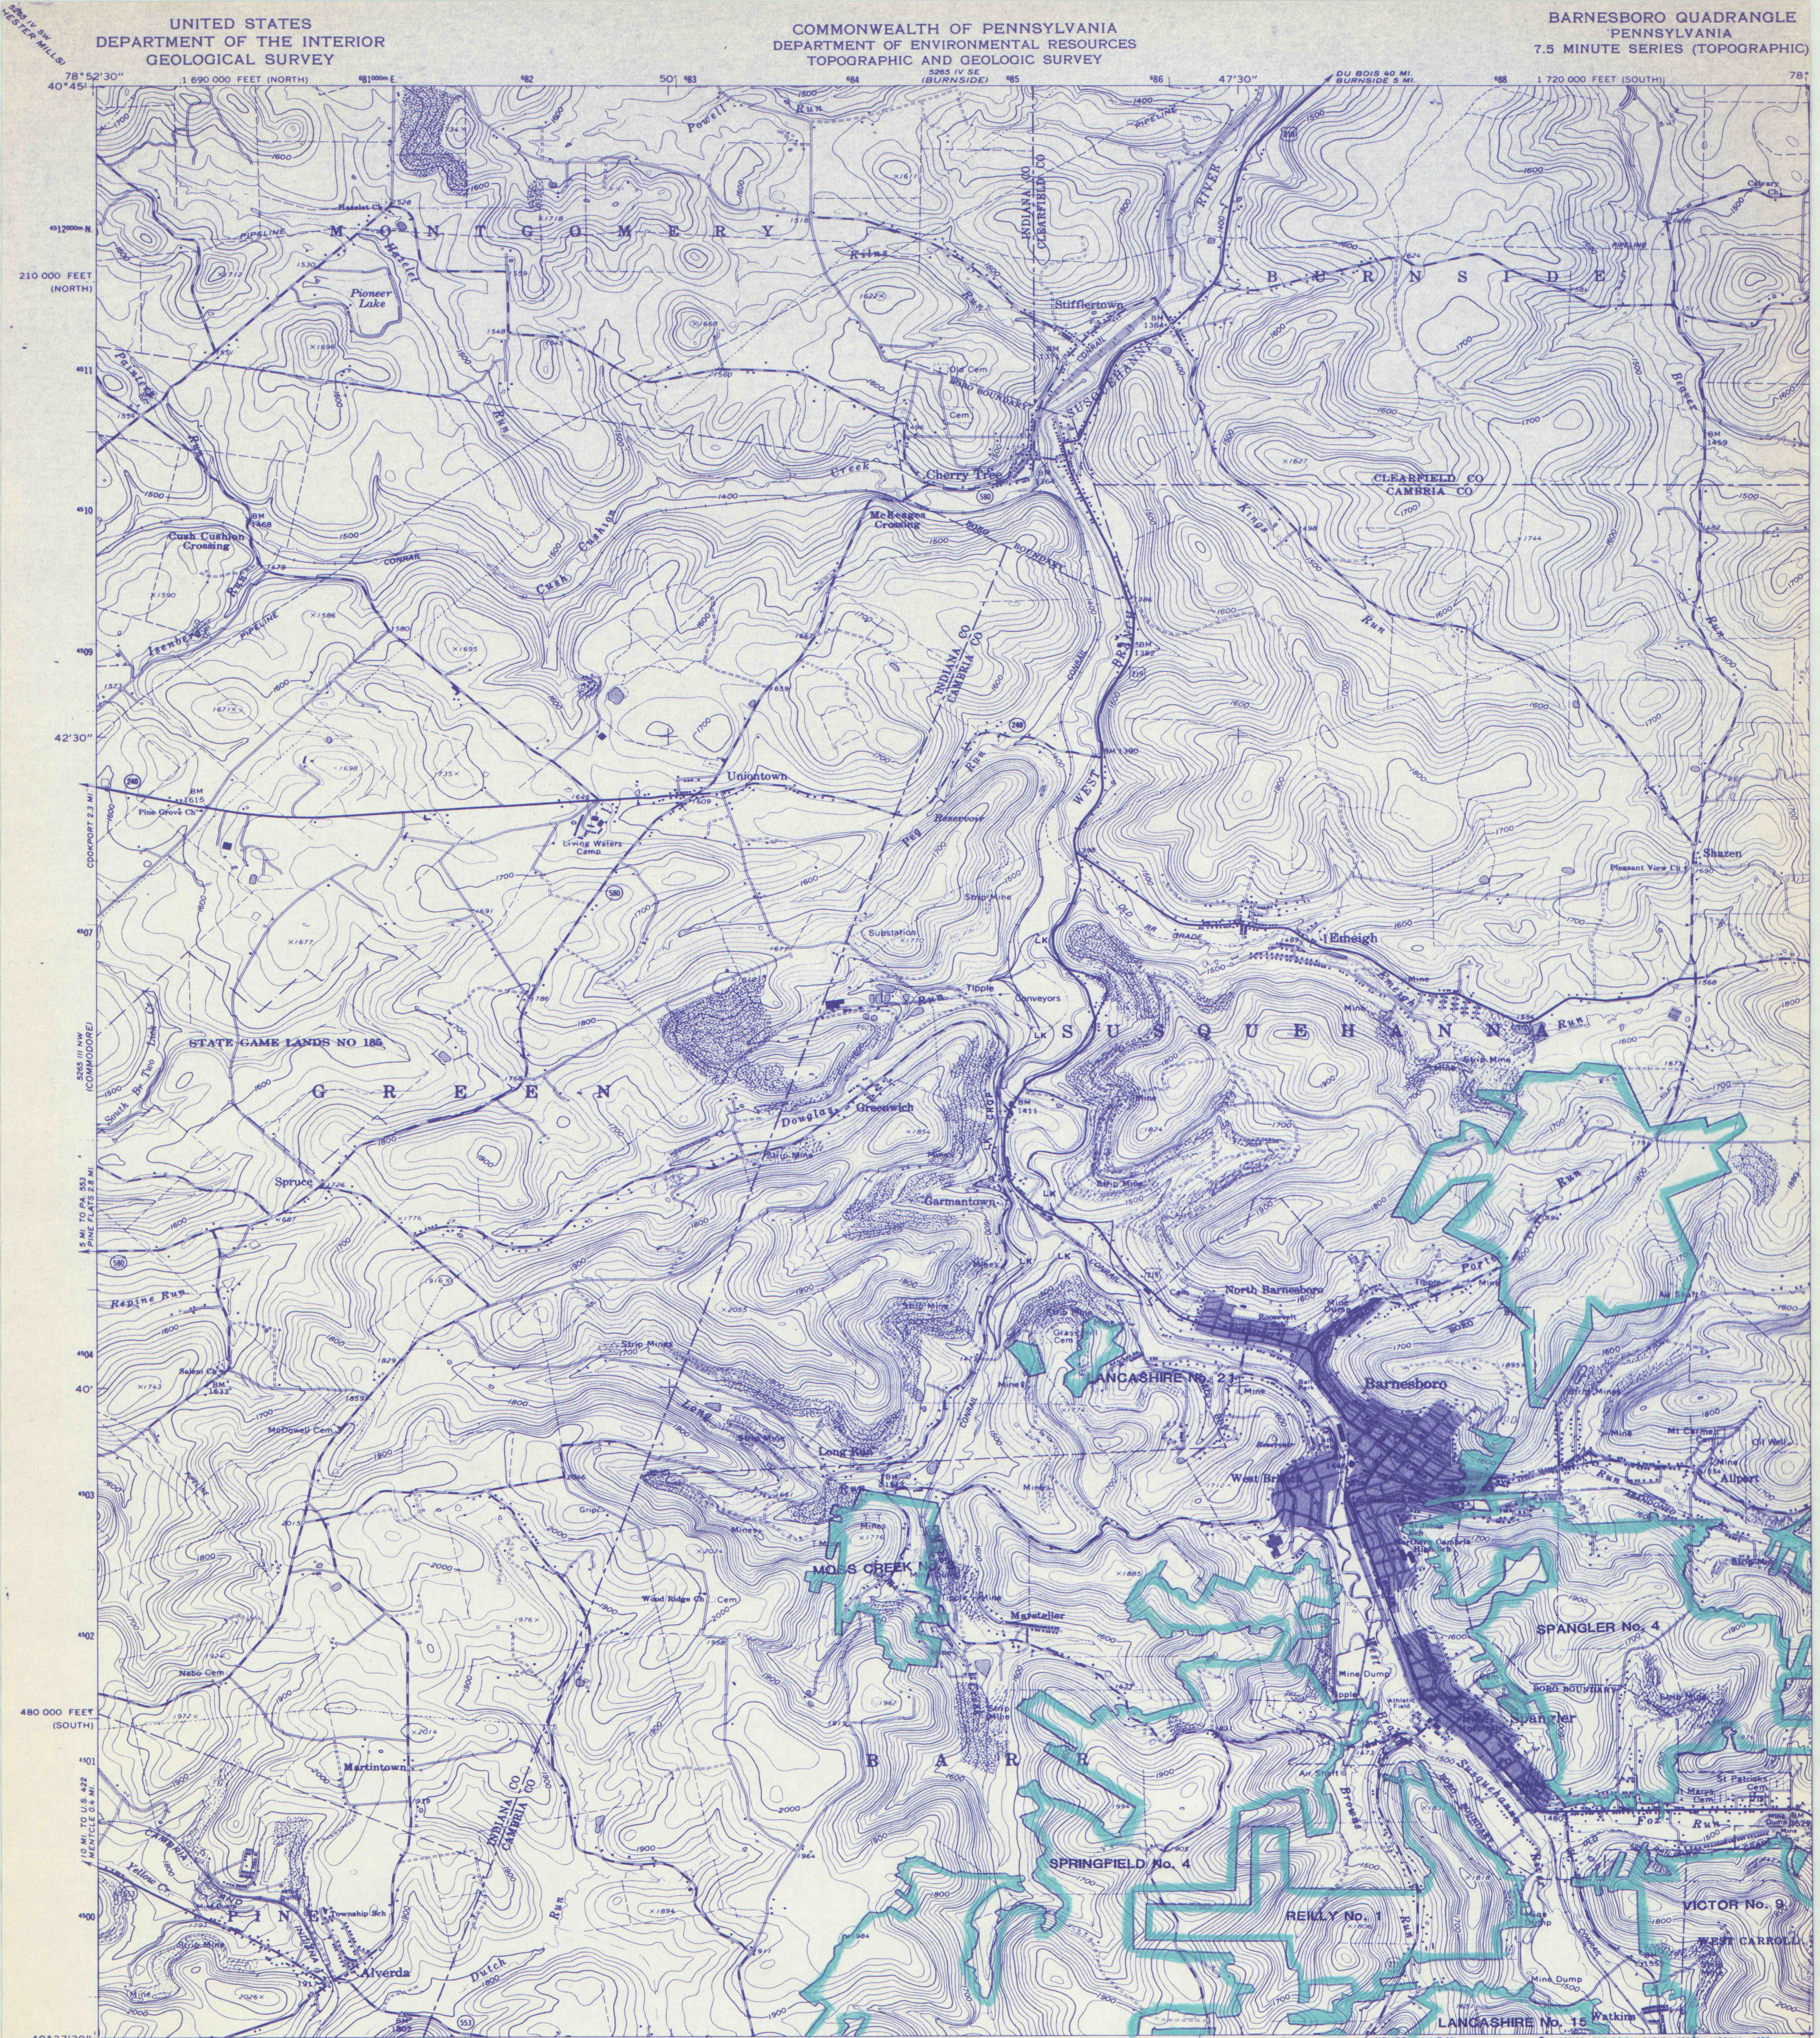

UNITED STATES
DEPARTMENT OF THE INTERIOR
GEOLOGICAL SURVEY

COMMONWEALTH OF PENNSYLVANIA
DEPARTMENT OF ENVIRONMENTAL RESOURCES
TOPOGRAPHIC AND GEOLOGIC SURVEY

BARNESBORO QUADRANGLE
PENNSYLVANIA
7.5 MINUTE SERIES (TOPOGRAPHIC)

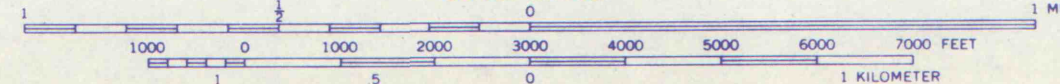

LOWER KITTINGING SEAM
IMAPS 11527

ROAD CLASSIFICATION
Heavy-duty
Medium-duty
Light-duty
Unimproved dirt