



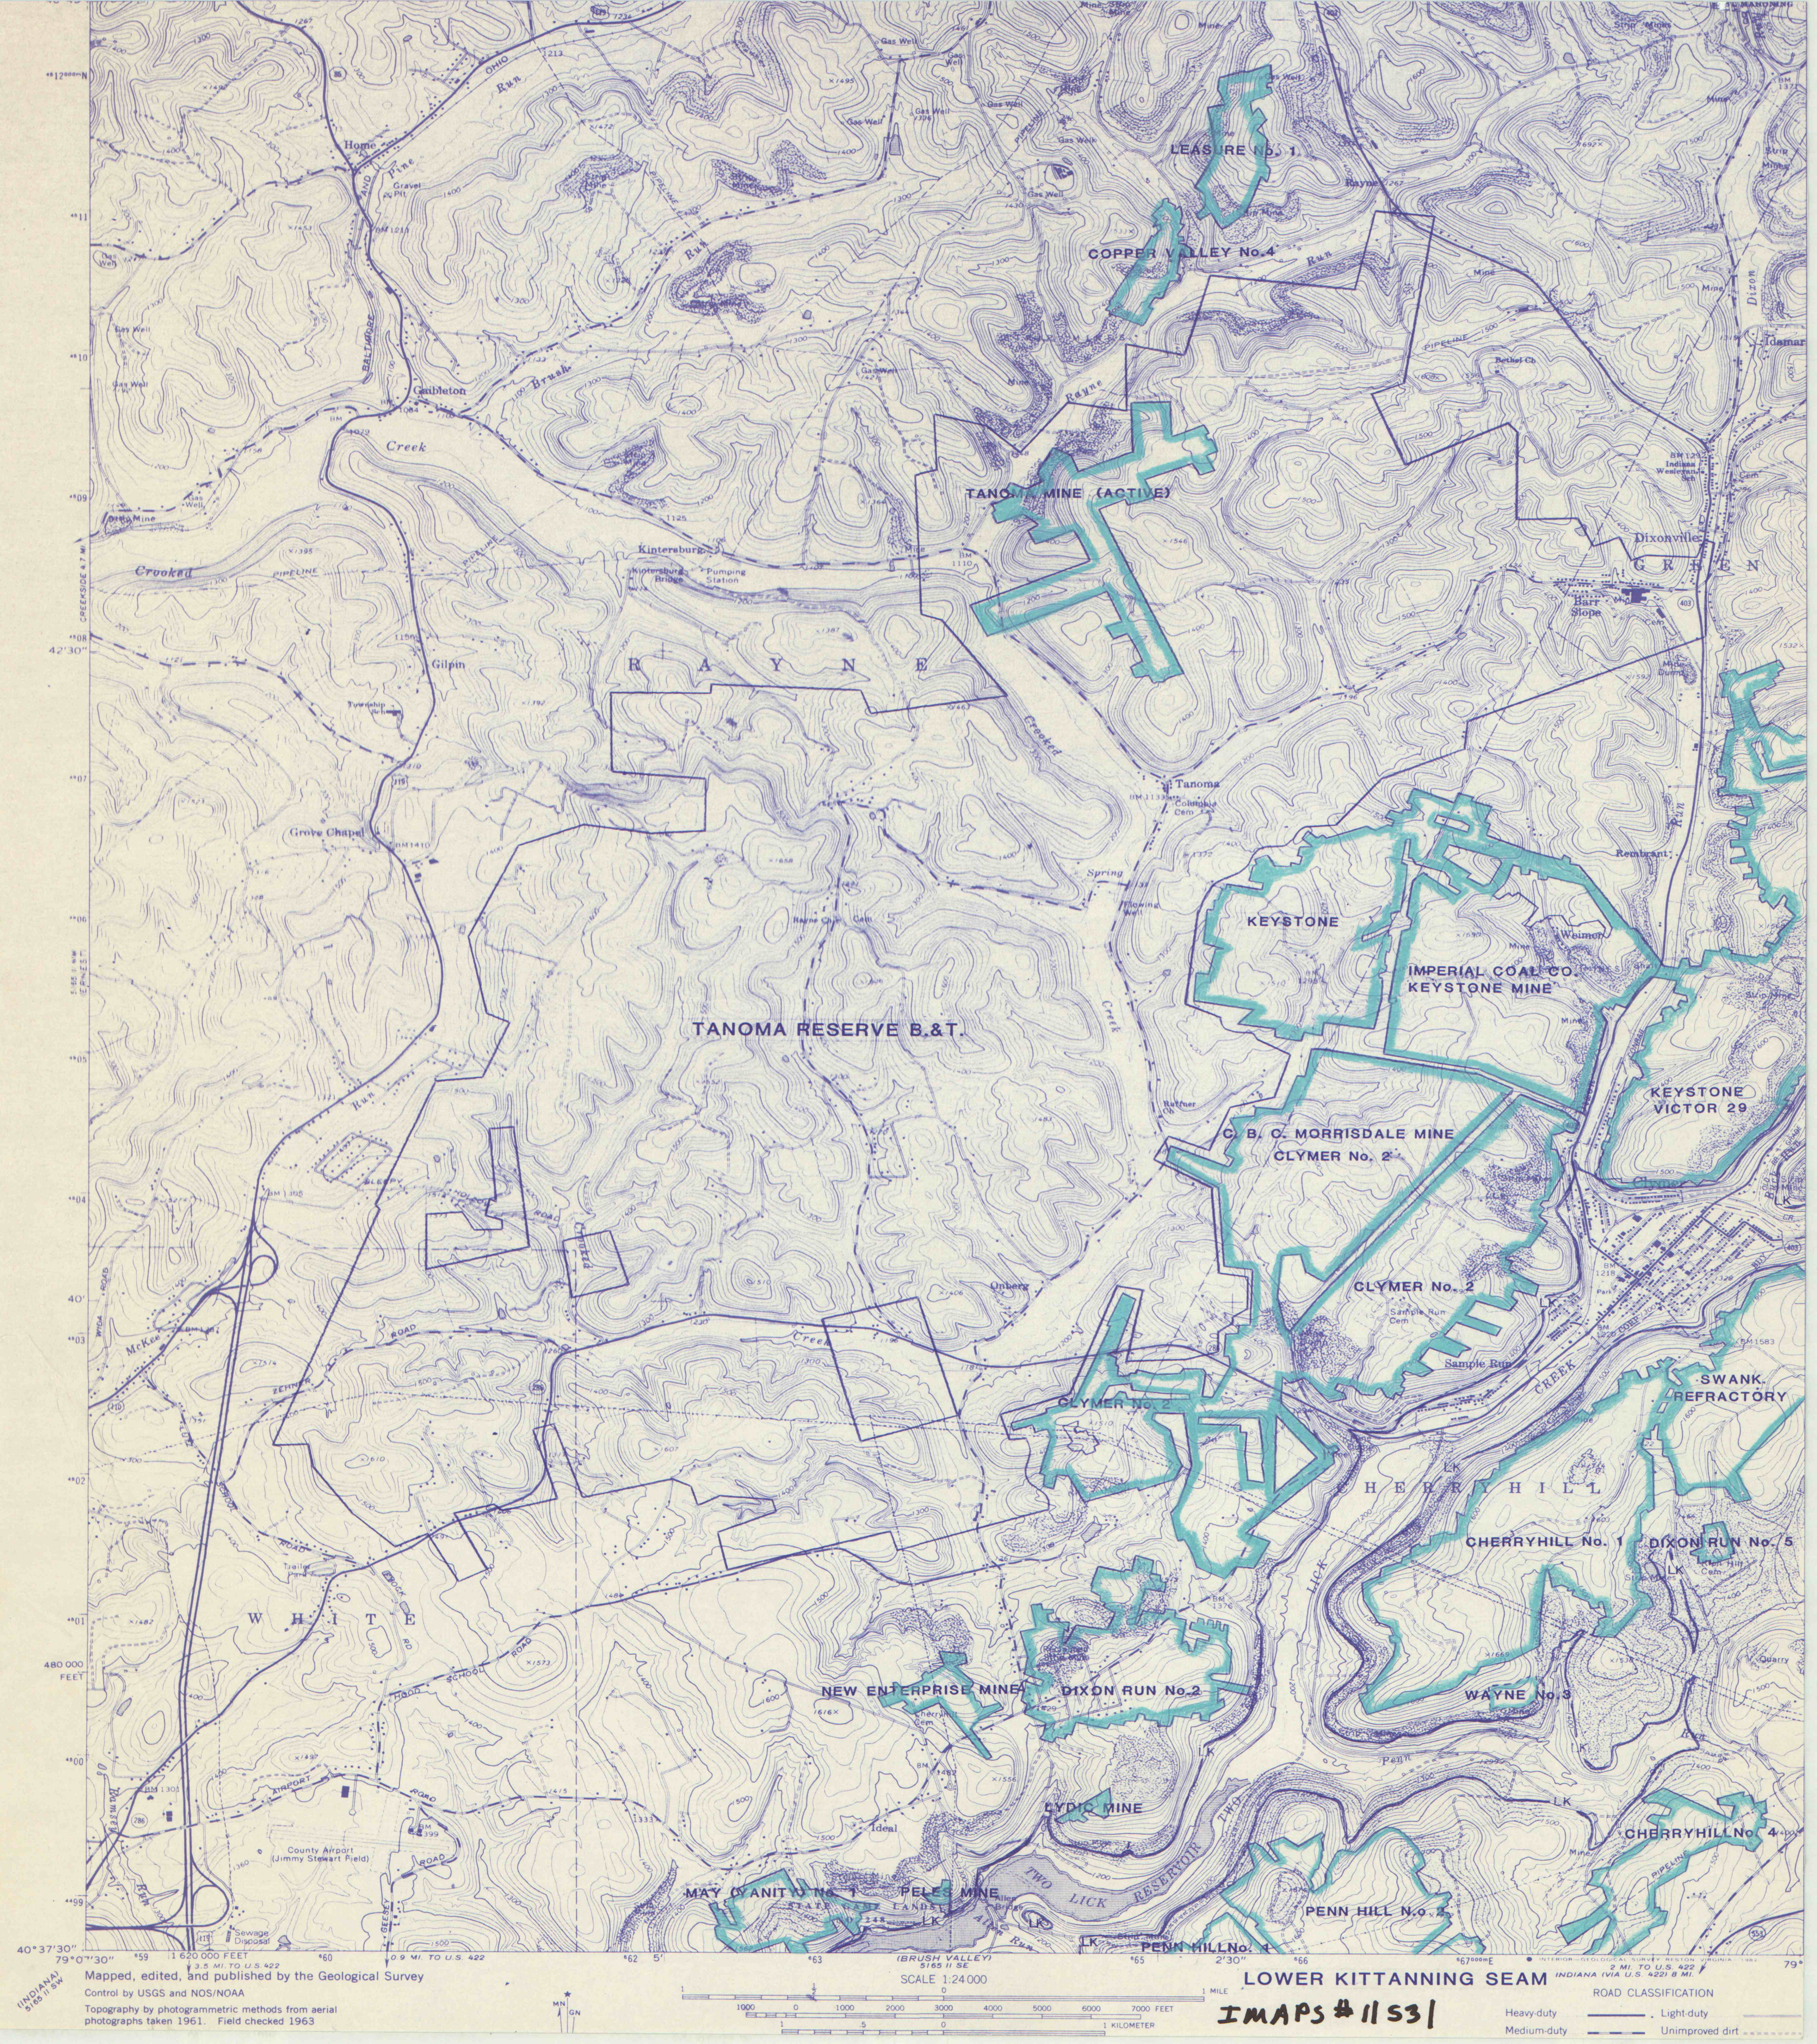

Mapped, edited, and published by the Geological Survey
Control by USGS and NOS/NOAA
Topography by photogrammetric methods from aerial
photographs taken 1961. Field checked 1963

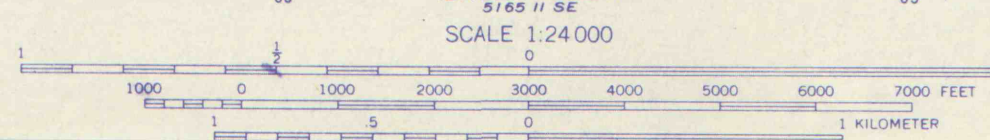

LOWER KITTANNING SEAM
IMAPS #11531
ROAD CLASSIFICATION
Heavy-duty
Medium-duty
Light-duty
Unimproved dirt