


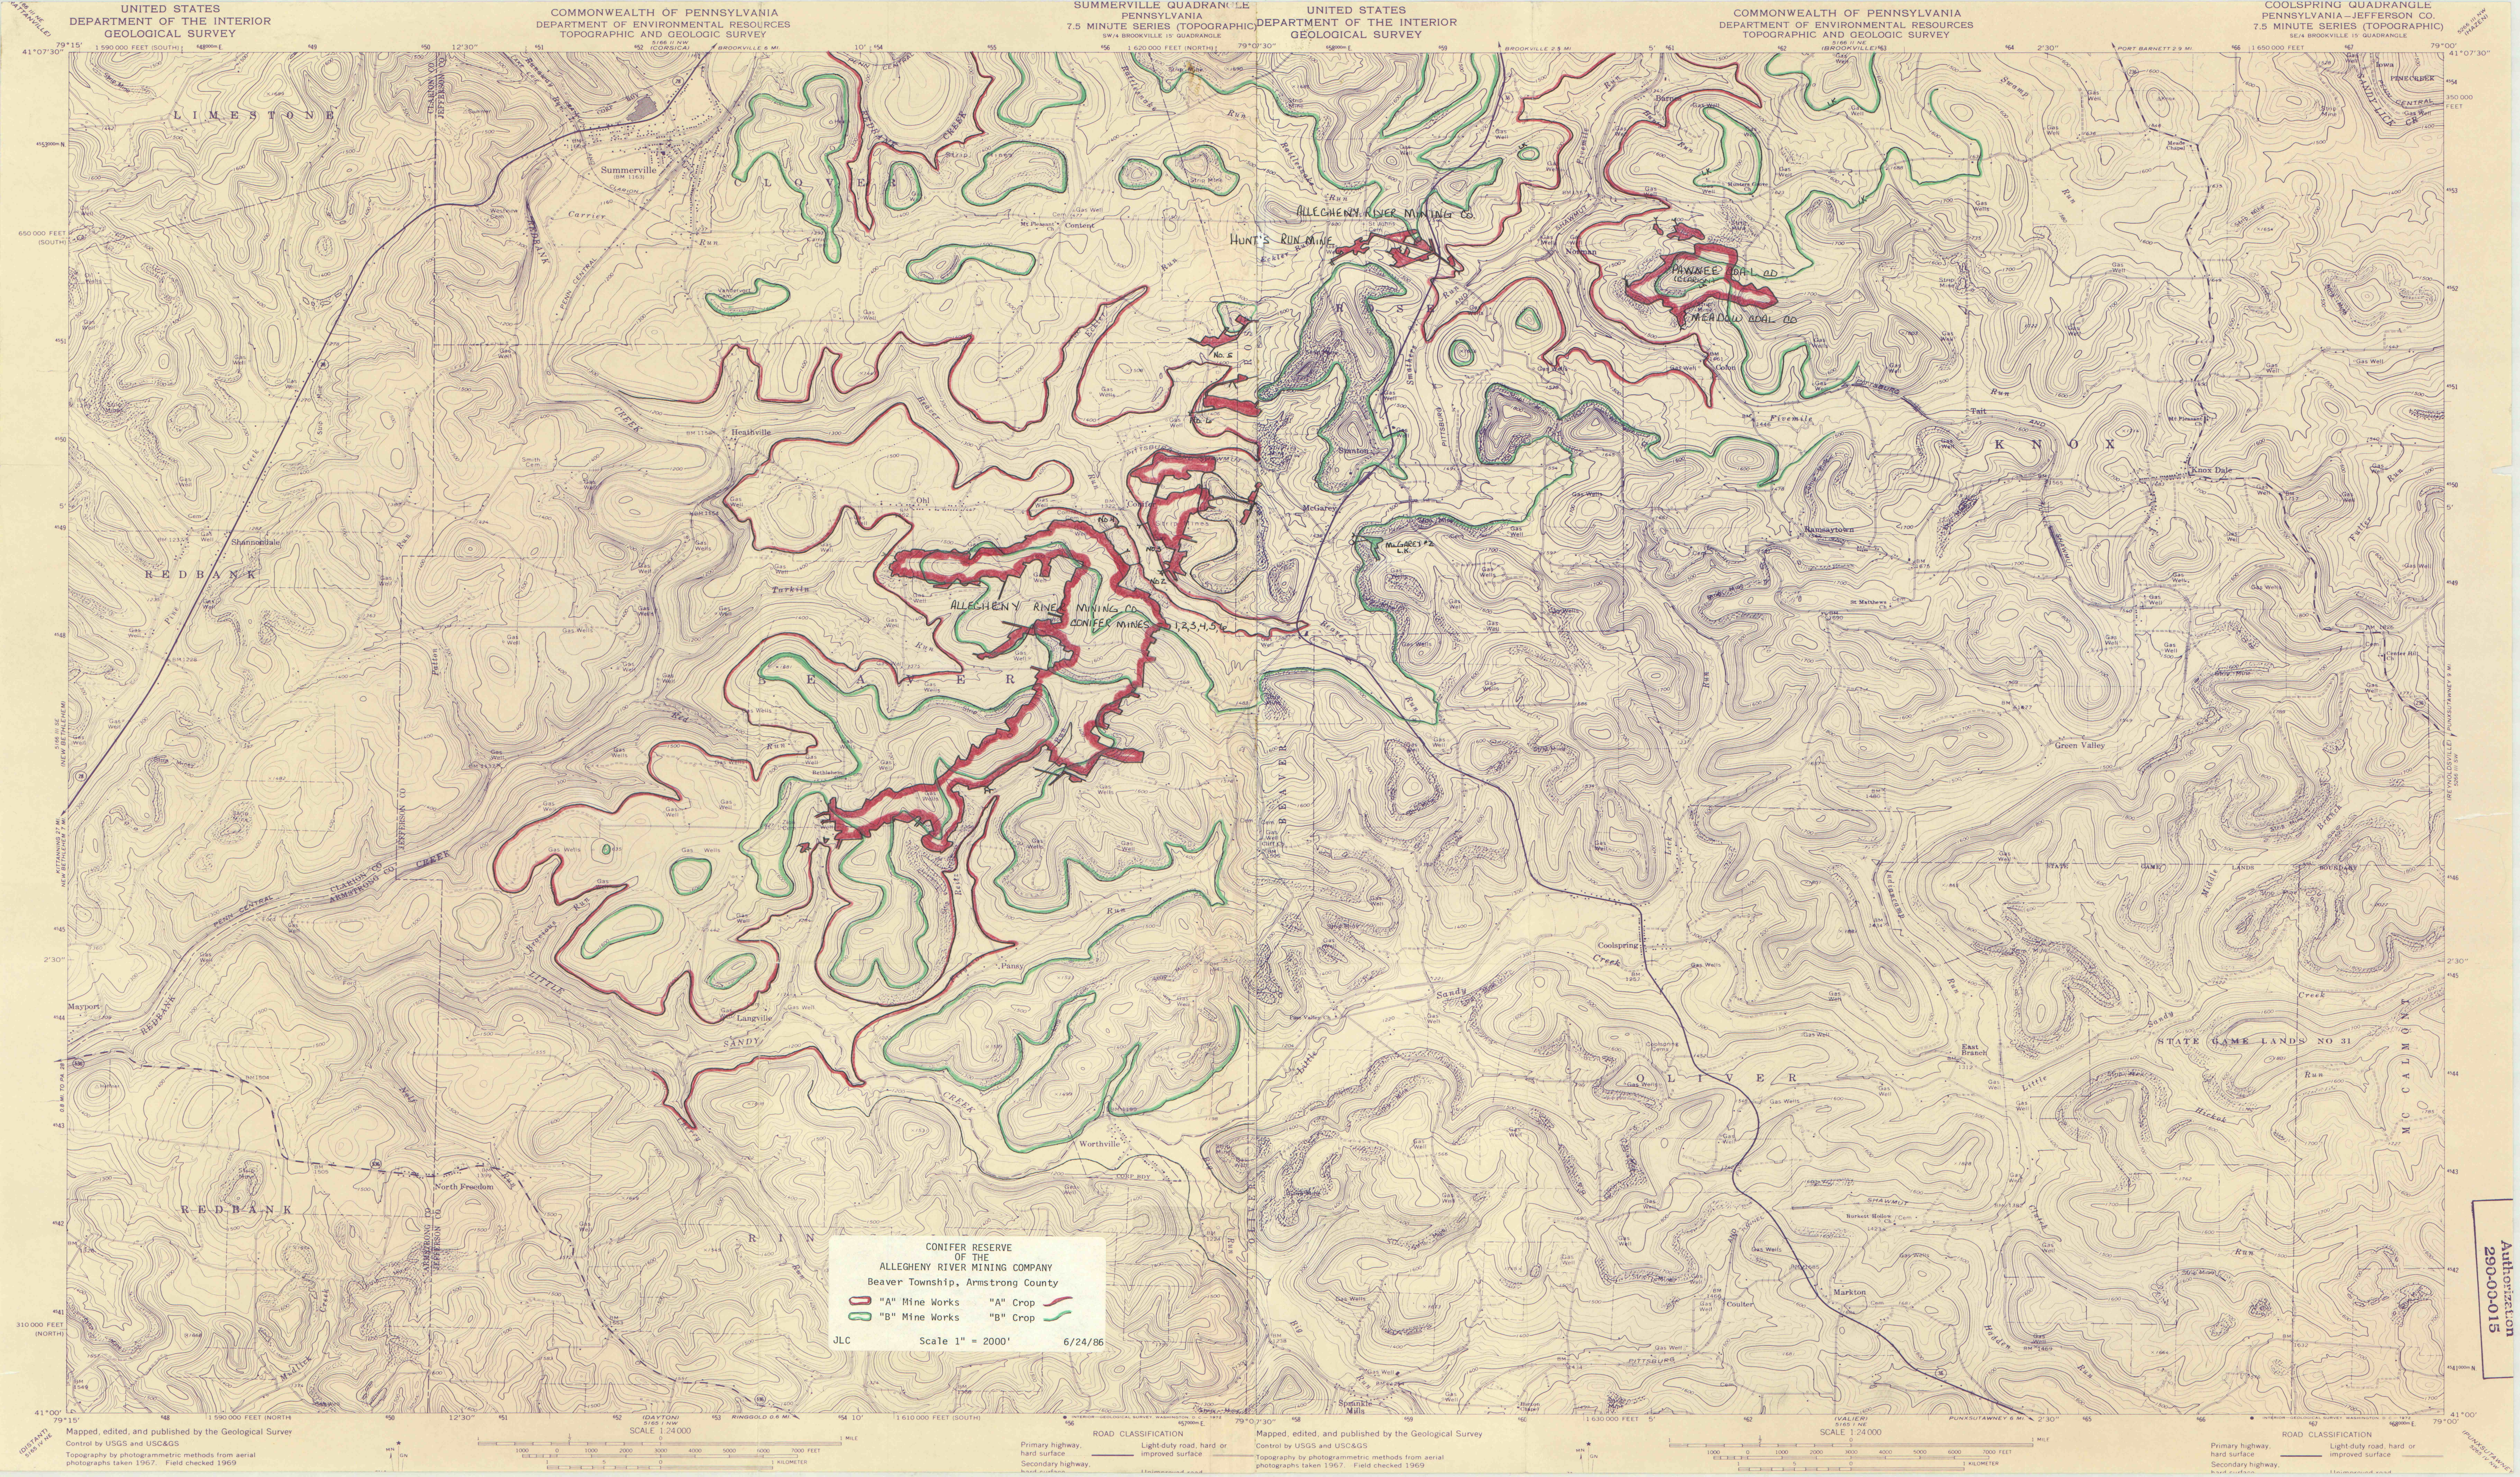

CONIFER RESERVE
OF THE
ALLEGHENY RIVER MINING COMPANY
Beaver Township, Armstrong County

"A" Mine Works

"B" Mine Works

"A" Crop

"B" Crop

JLC

Scale 1" = 2000'

6/24/86

Authorization
290-00-015