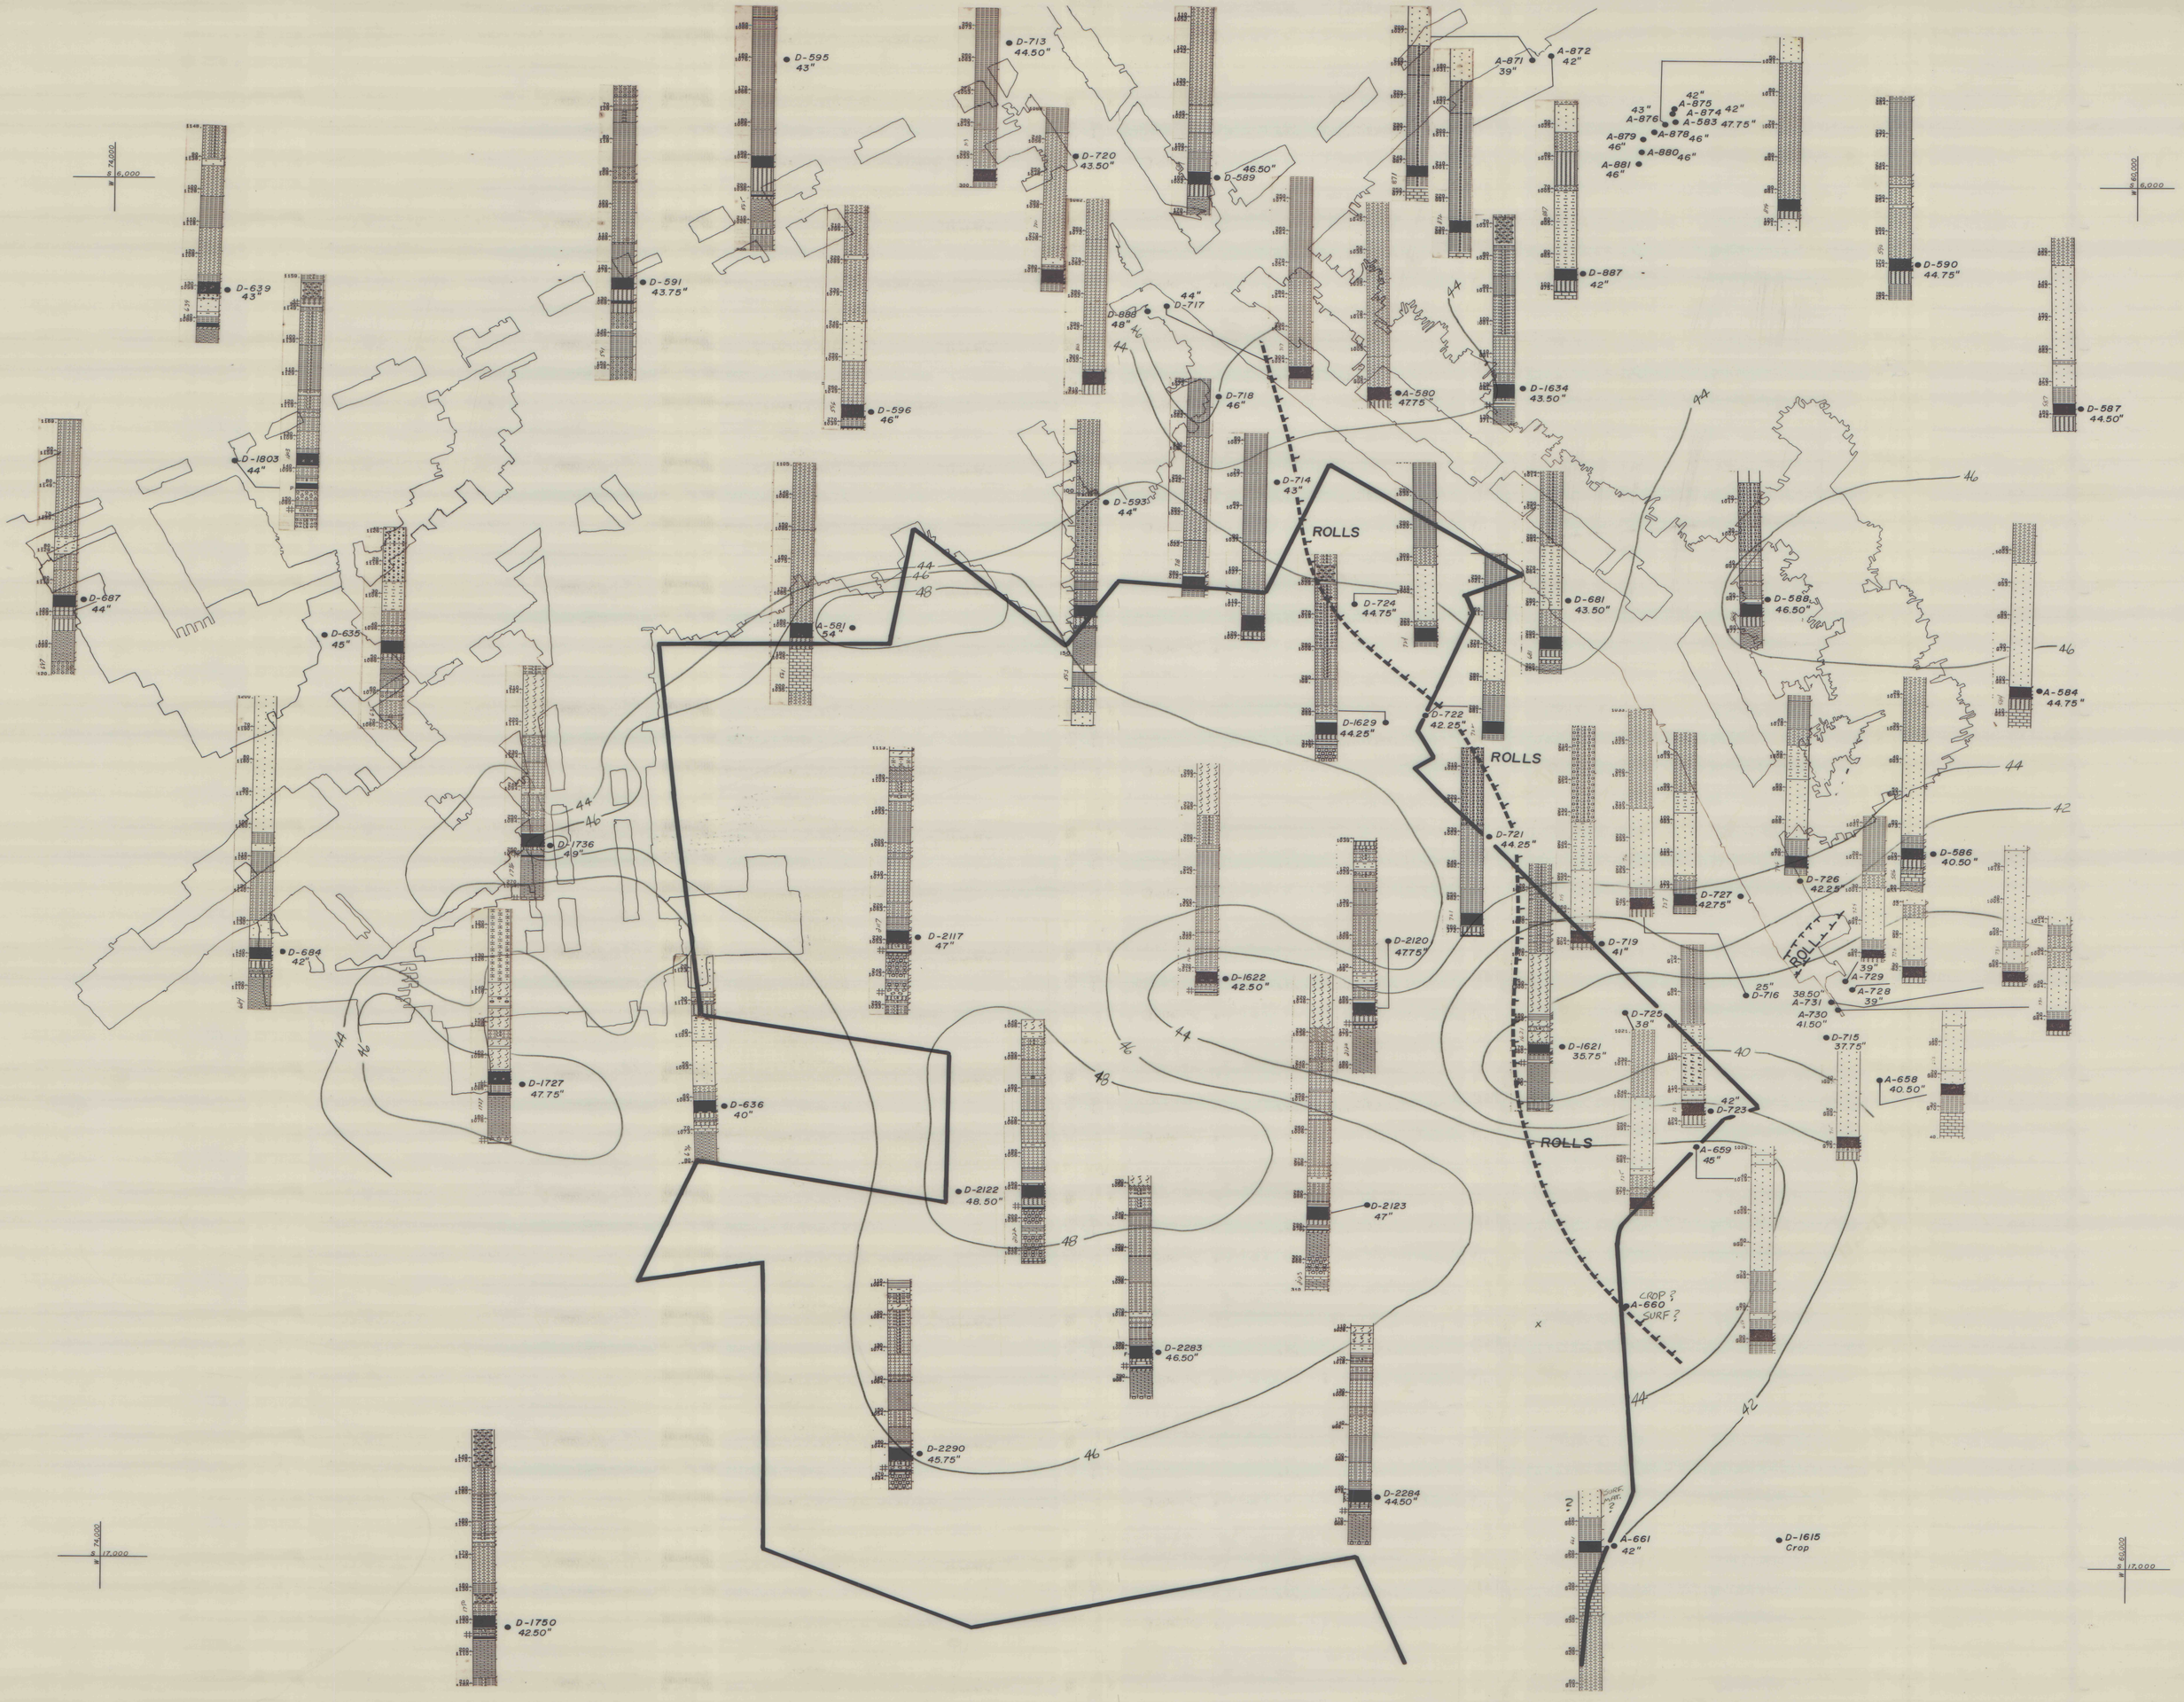
D-595 43"
D-713 44.50"
D-720 43.50"
D-589 46.50"
A-871 39"
A-872 42"
A-875 42"
A-874 42"
A-876 43"
A-583 47.75"
A-879 46"
A-878 46"
A-880 46"
A-881 46"
D-887 42"
D-590 44.75"
D-587 44.50"
D-639 43"
D-591 43.75"
D-596 46"
D-888 48"
D-717 44"
D-718 46"
A-580 47.75"
D-1634 43.50"
D-1803 44"
D-593 44"
D-714 43"
ROLLS
D-724 44.75"
D-681 43.50"
D-588 46.50"
A-584 44.75"
D-687 44"
D-635 45"
A-581 54"
D-1629 44.25"
D-722 42.25"
D-721 44.25"
D-1736 49"
D-586 40.50"
D-726 42.25"
D-727 42.75"
D-684 42"
D-2117 47"
D-1622 42.50"
D-2120 47.75"
D-719 41"
A-729 39"
A-728 39"
D-716 25"
A-731 38.50"
A-730 41.50"
D-725 38"
D-715 37.75"
D-1727 47.75"
D-636 40"
D-1621 35.75"
A-658 40.50"
D-723 42"
A-659 45"
D-2122 48.50"
D-2123 47"
CROP ?
A-660
SURF ?
D-2283 46.50"
D-2290 45.75"
D-2284 44.50"
A-661 42"
D-1615 Crop
D-1750 42.50"

IMAPS #11550