


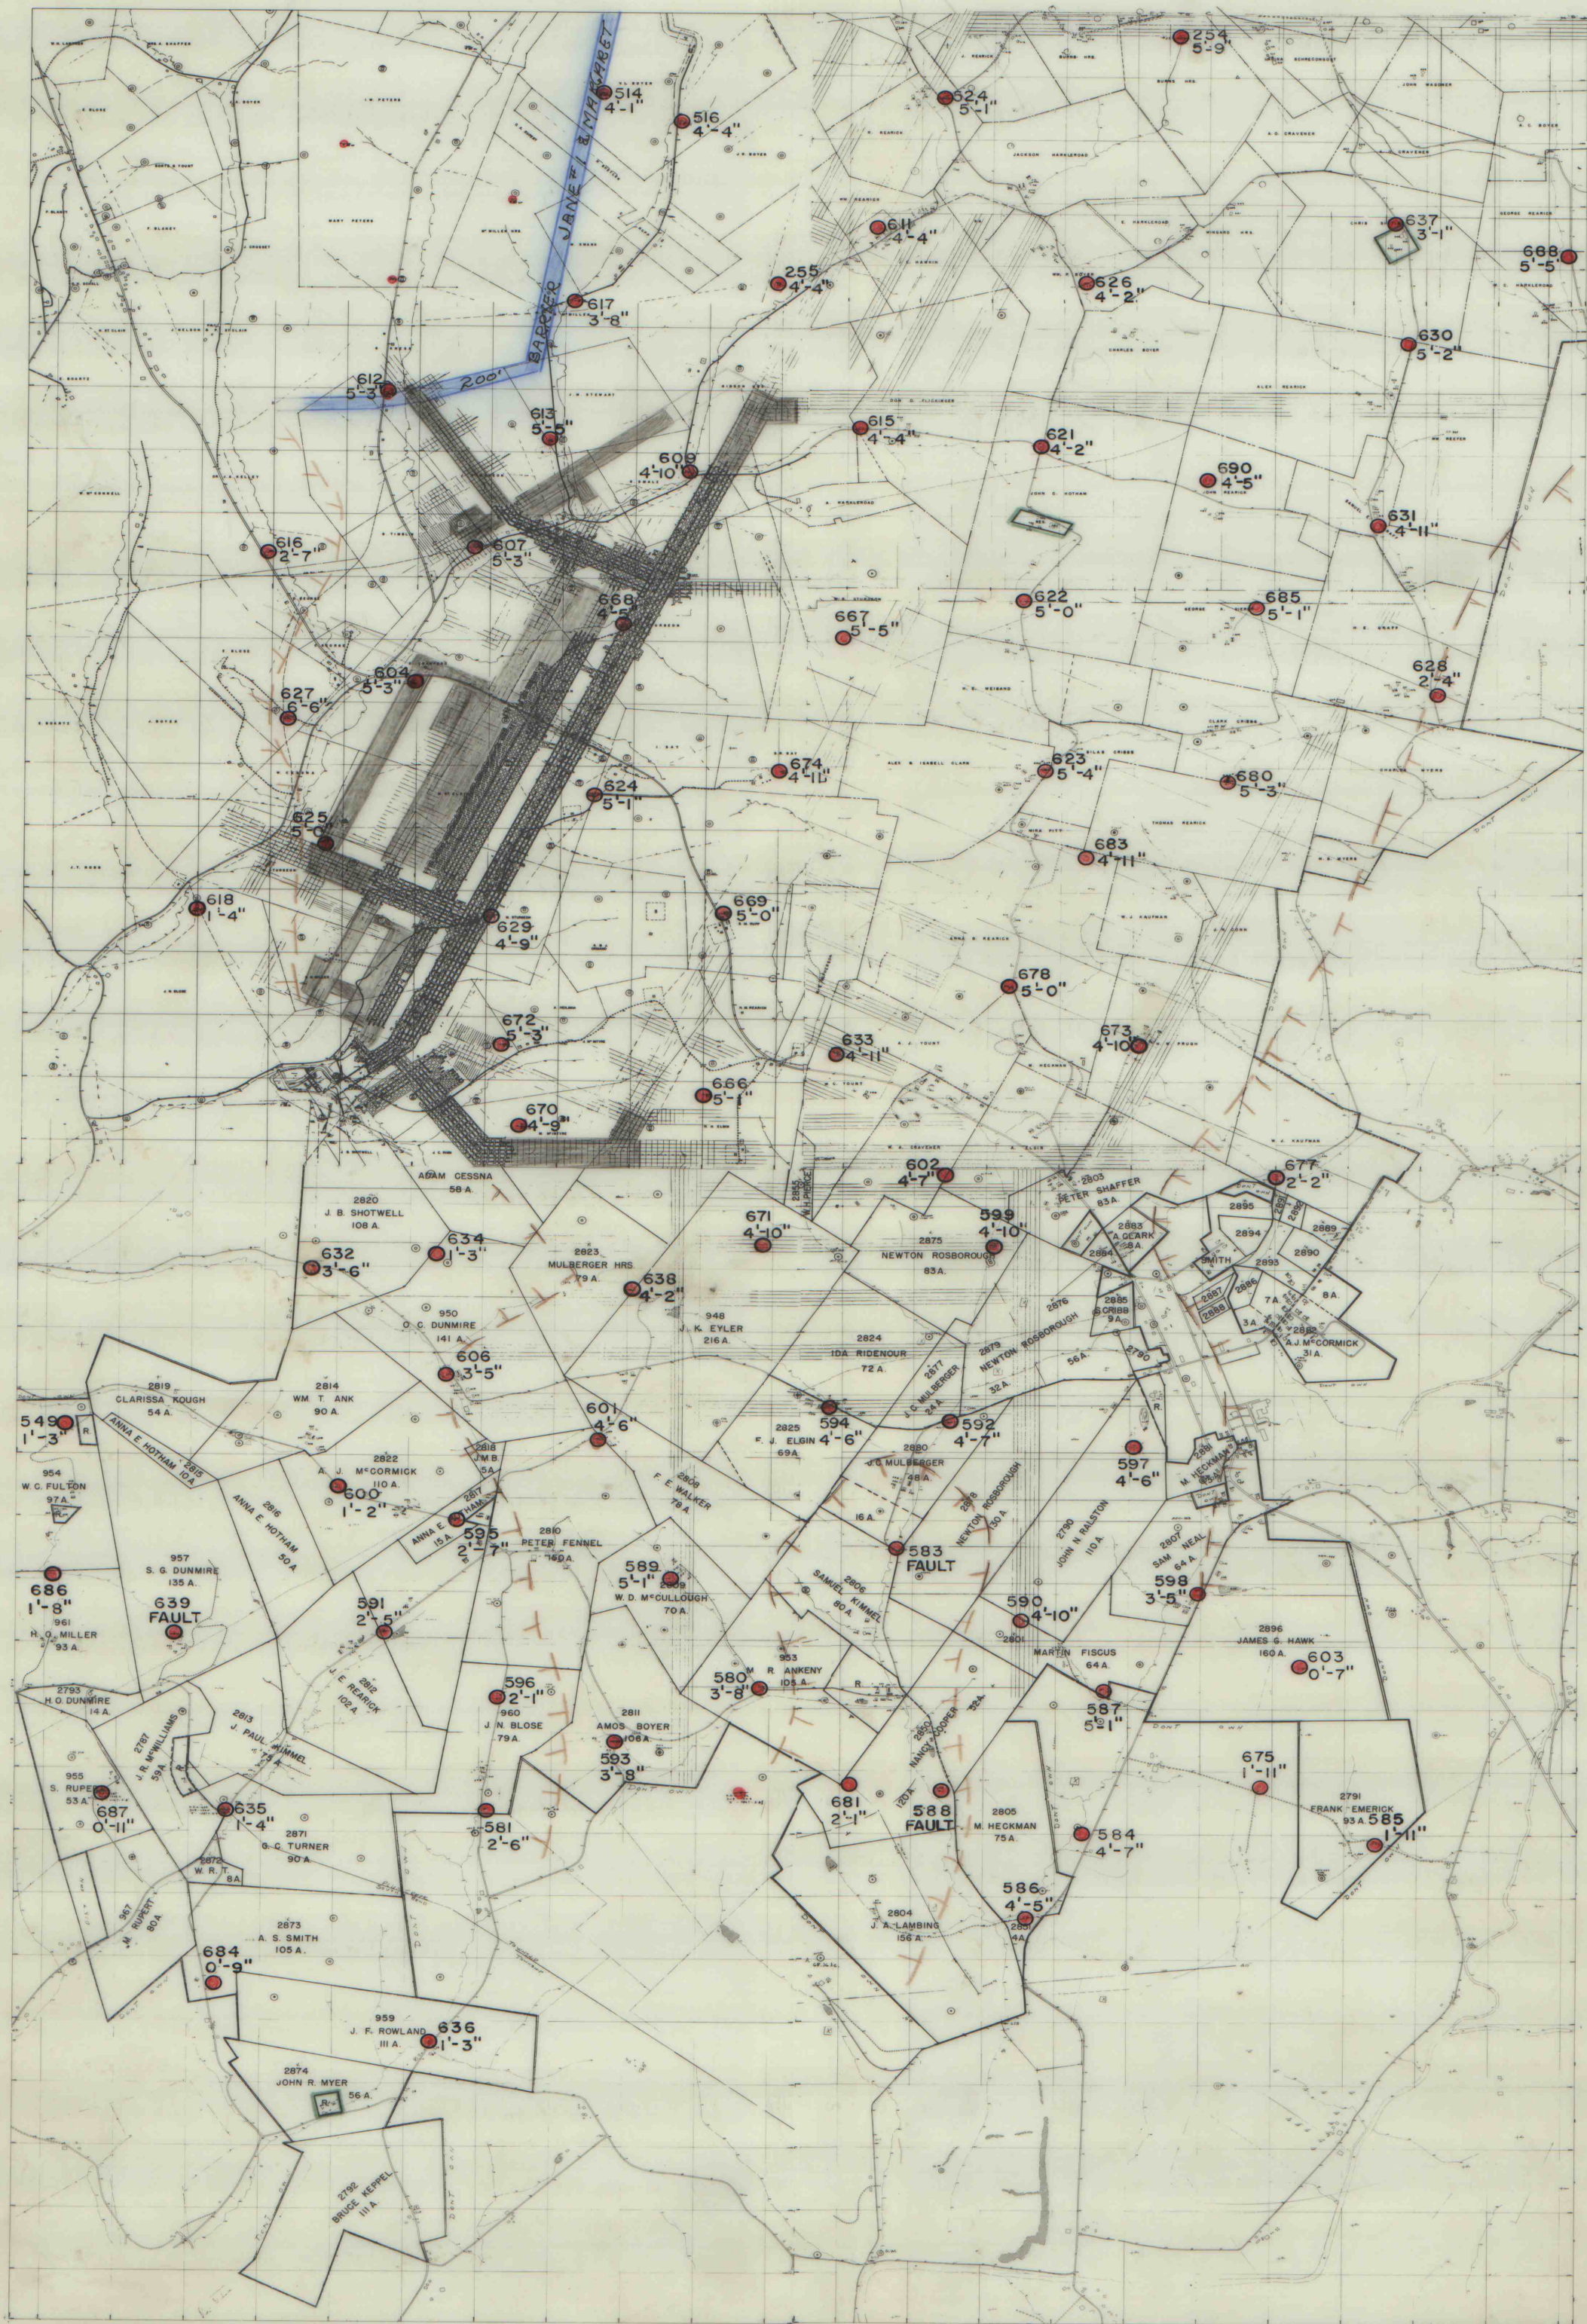

JANE MINES "D" VEIN

SCALE 1" = 2000'

IMAPS# 11563

9711-139