18 Emilie

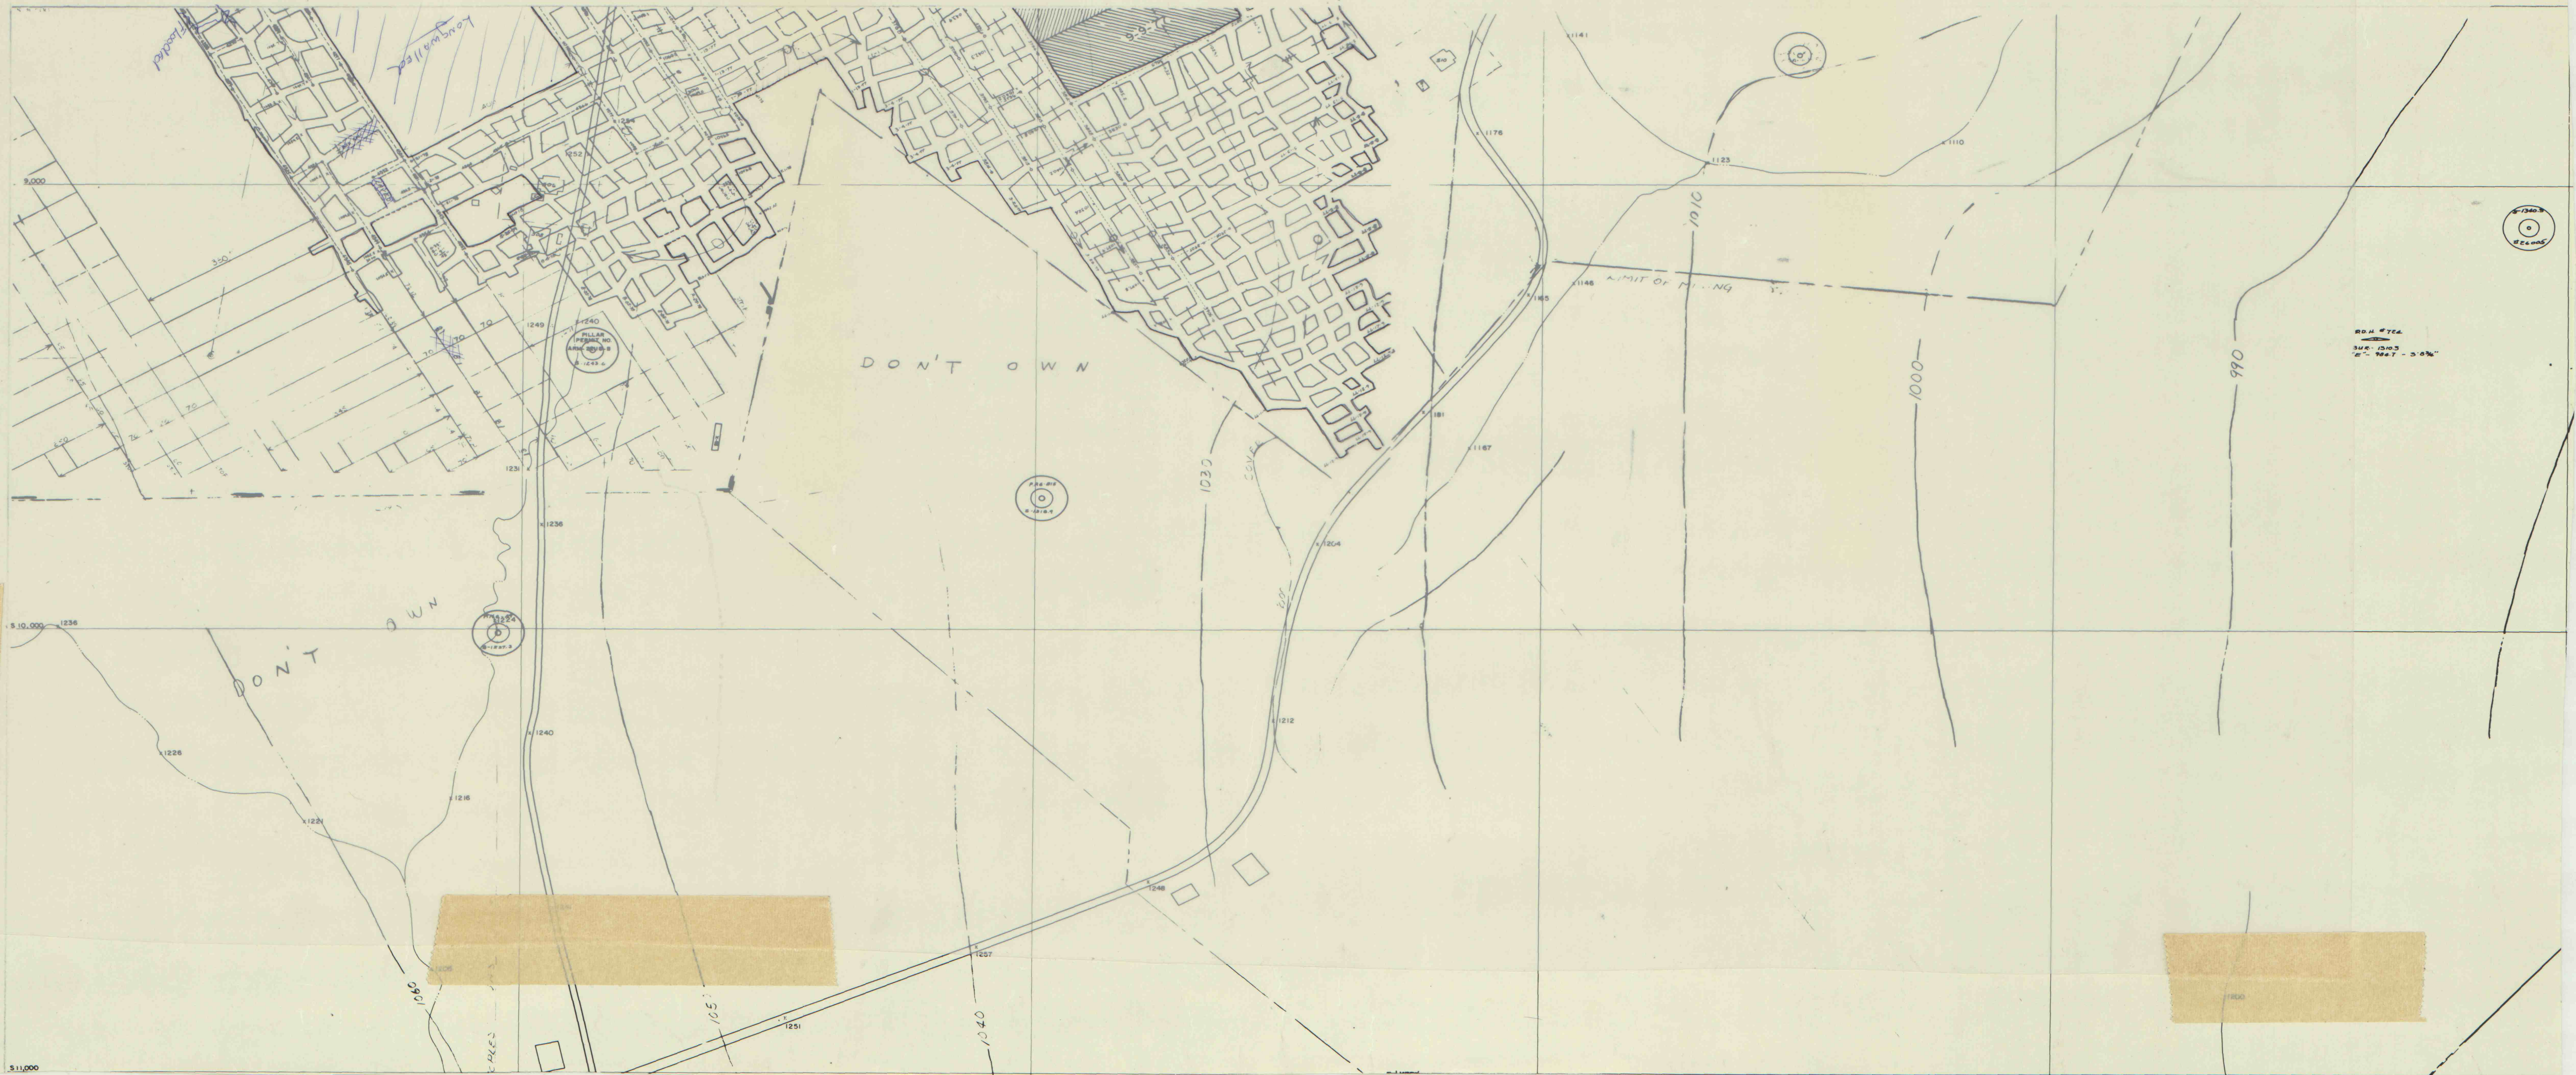

Flooded
Longwalled
9,000
350
1252
1249
1240
PILLAR
1231
DON'T OWN
DON'T OWN
1236
1240
1226
1221
1216
S 10,000
S 11,000
1060
1050
1040
1030
COVER
1204
1212
1248
1257
1251
1141
1176
1123
1110
1146
1165
LIMIT OF MINING
1167
1010
1000
990