


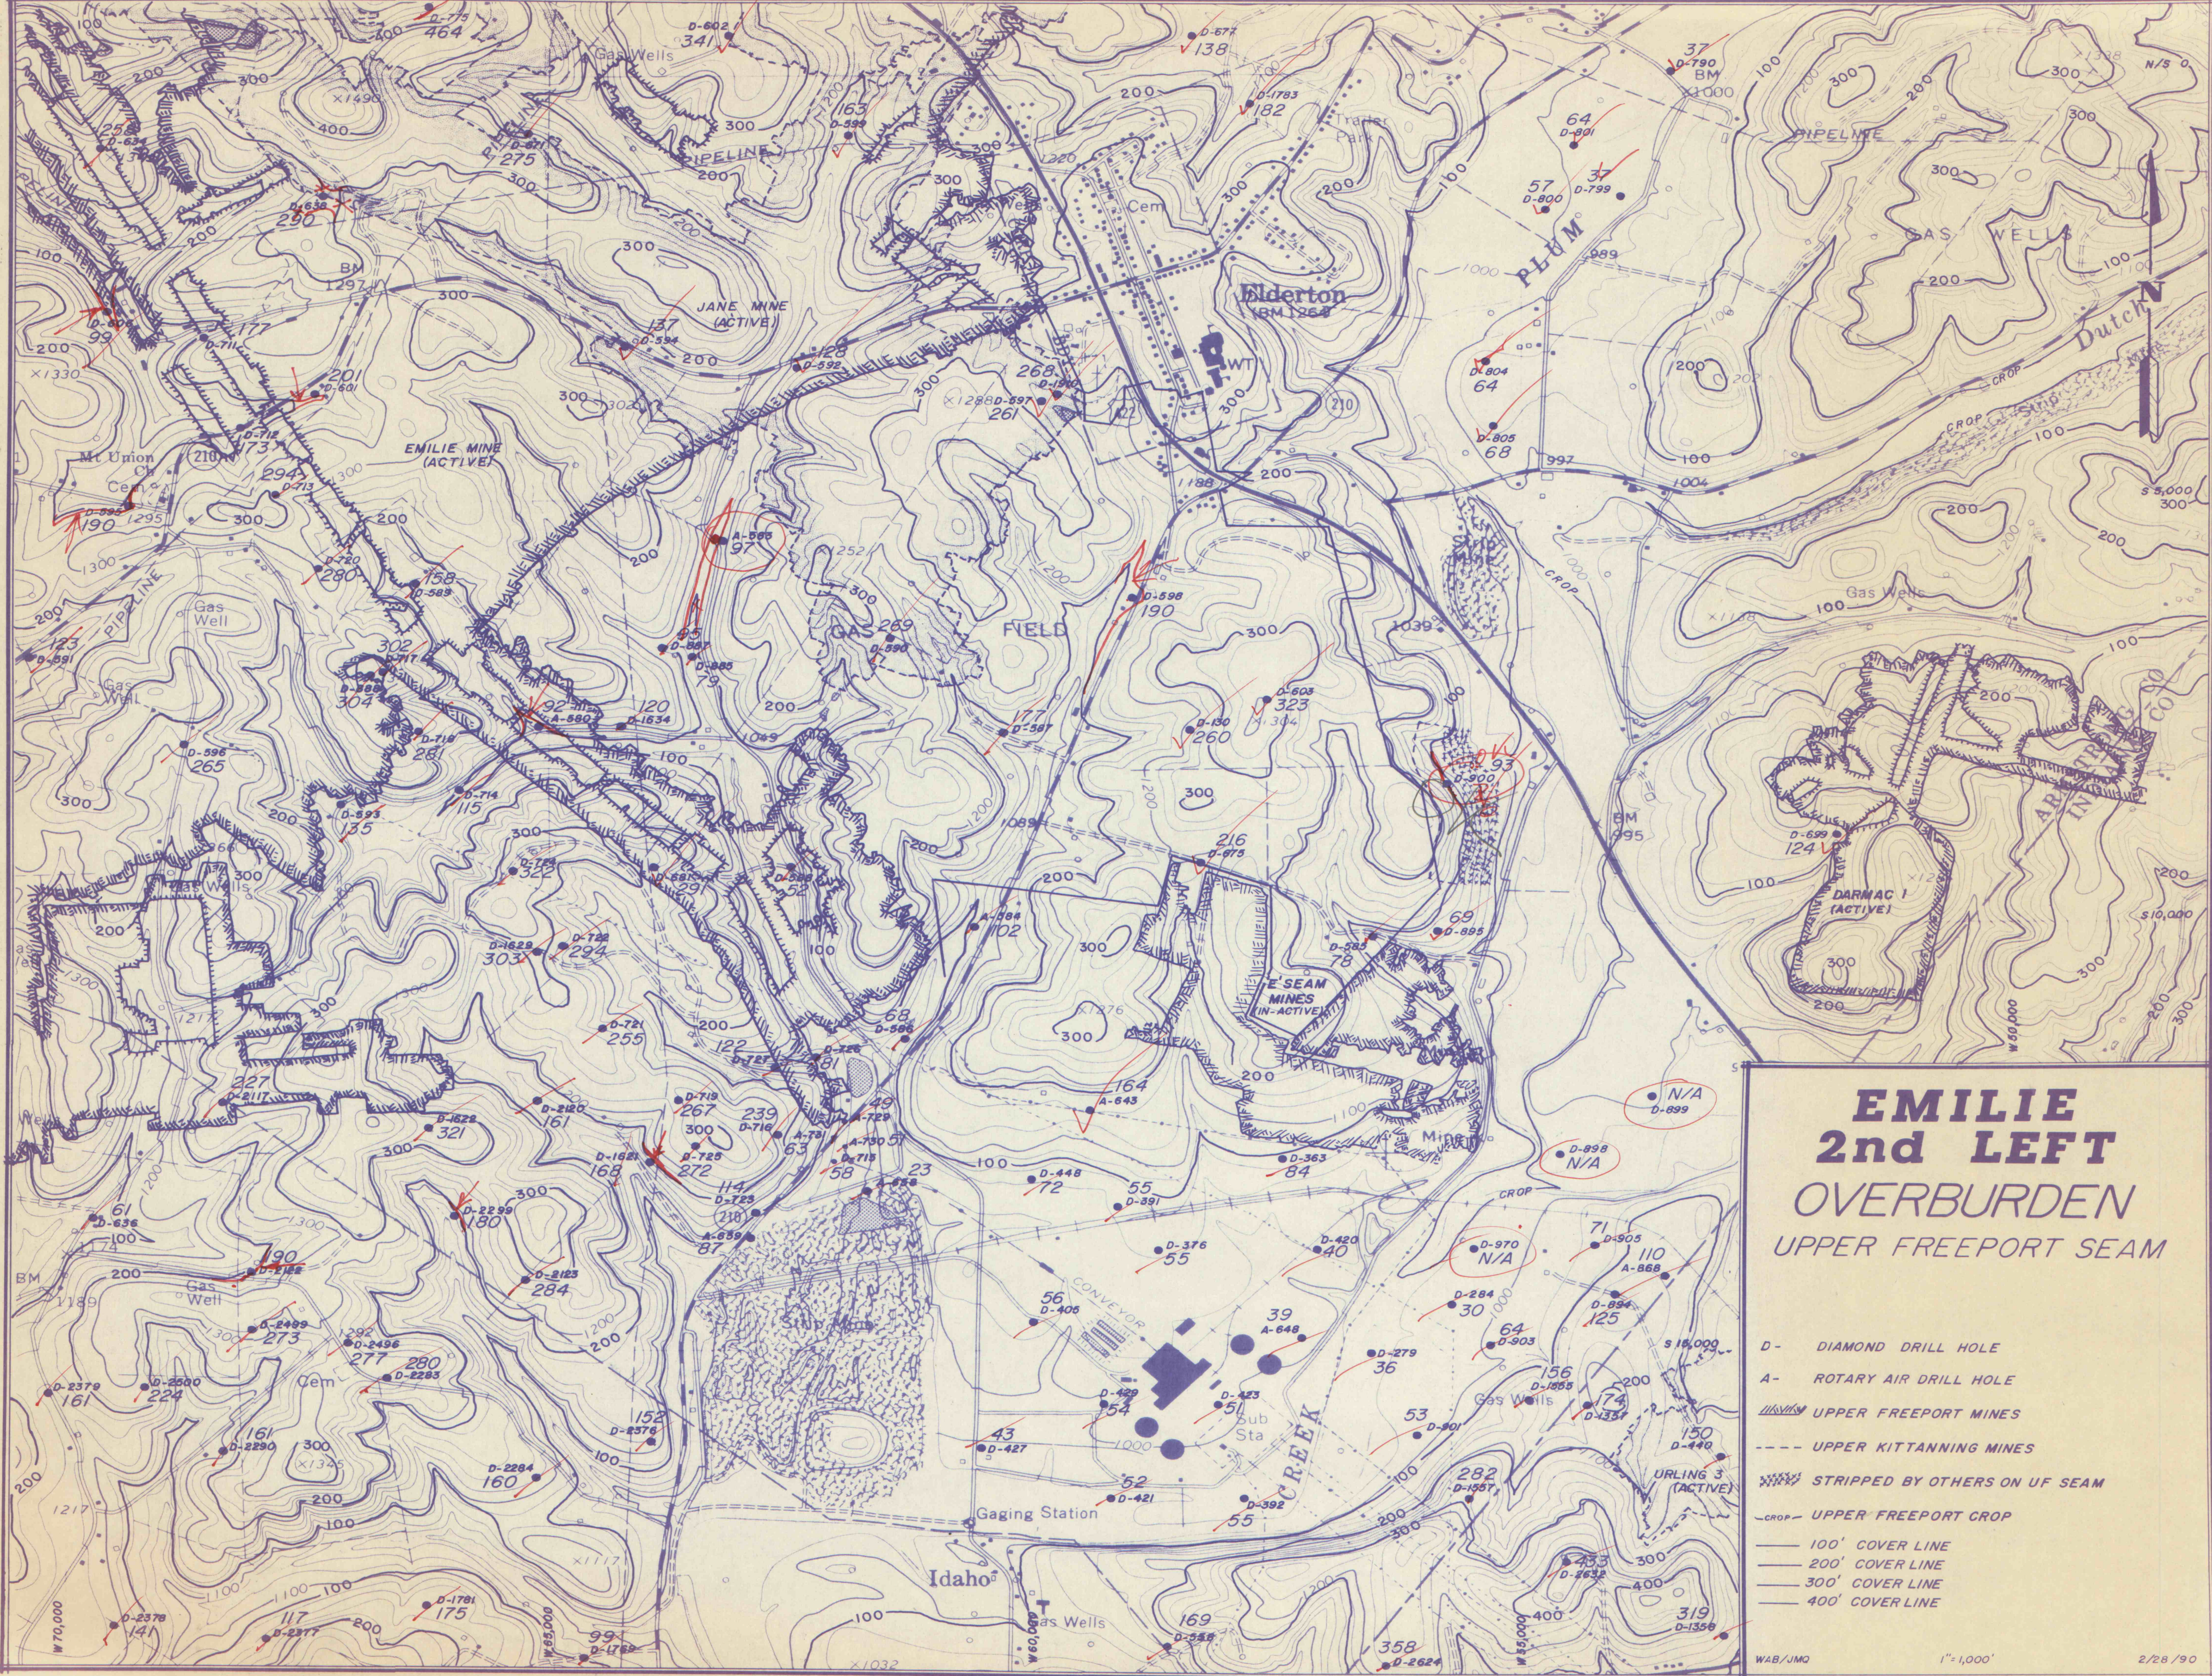

EMILIE 2nd LEFT OVERBURDEN UPPER FREEPORT SEAM

- D - DIAMOND DRILL HOLE
- A - ROTARY AIR DRILL HOLE
- UPPER FREEPORT MINES
- UPPER KITTANNING MINES
- STRIPPED BY OTHERS ON UF SEAM
- UPPER FREEPORT CROP
- 100' COVER LINE
- 200' COVER LINE
- 300' COVER LINE
- 400' COVER LINE