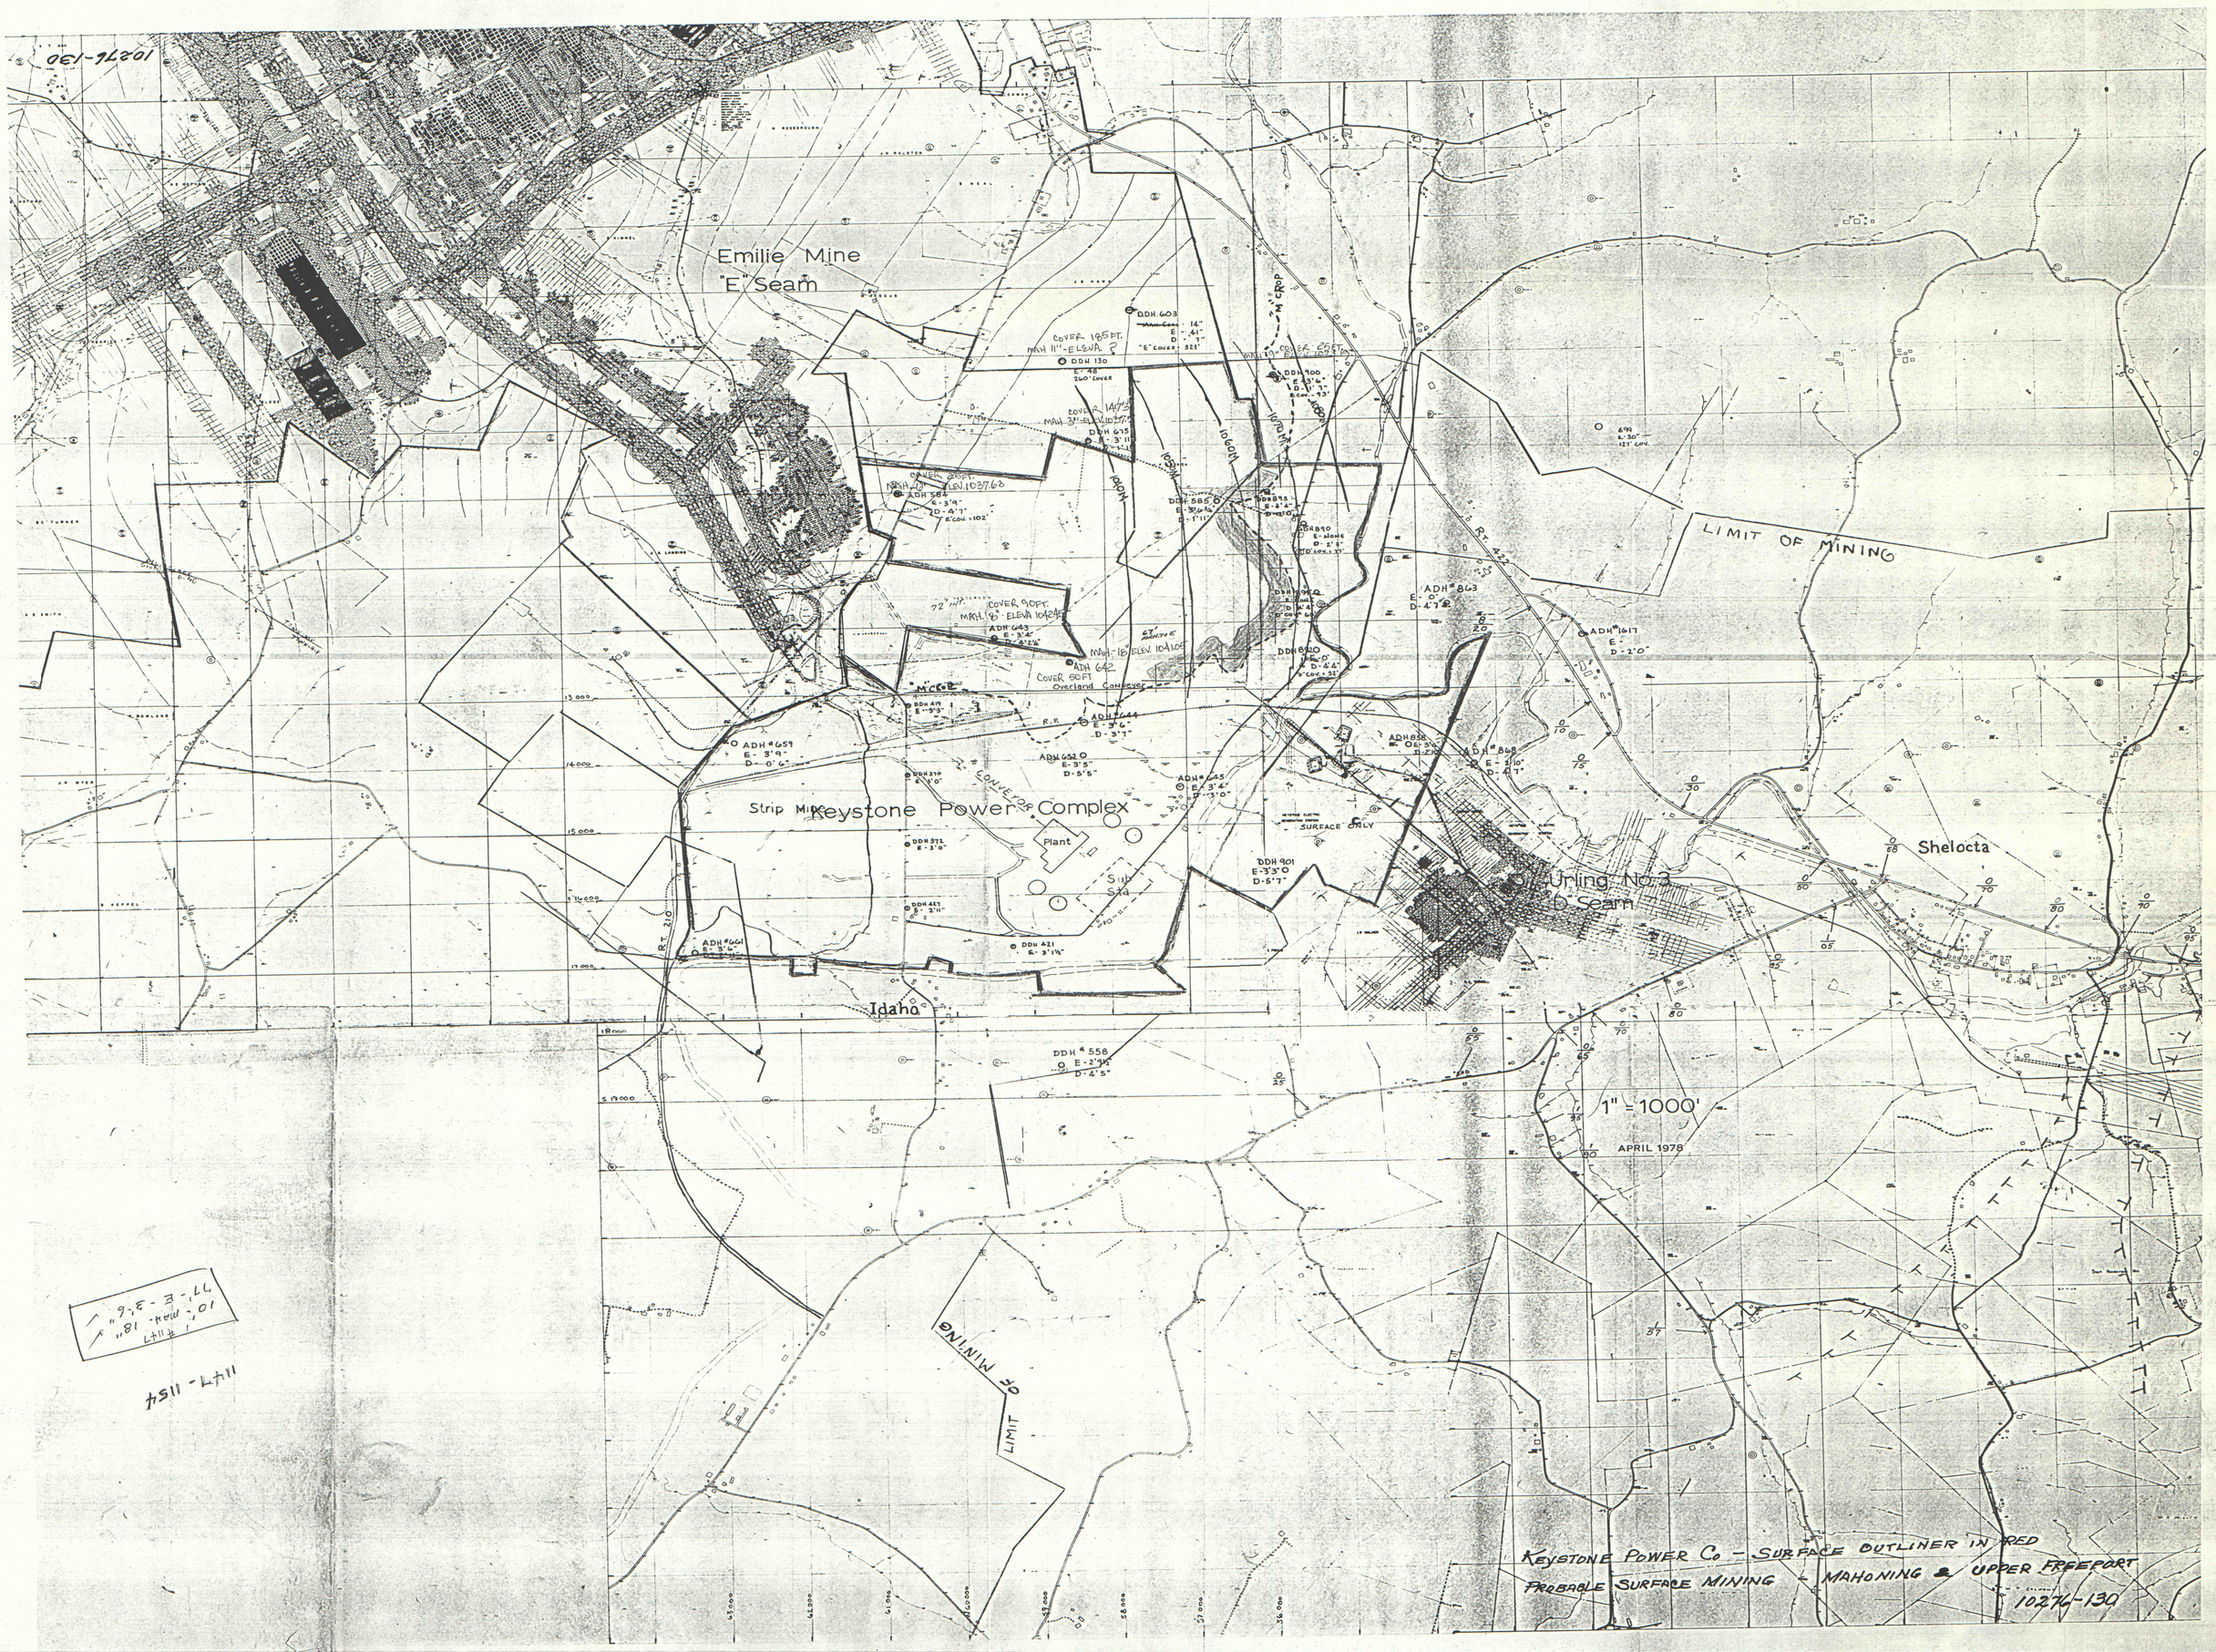
Emilie Mine
"E" Seam
Strip Mine
Keystone Power Complex
Plant
Silt Sta
Conveyor
Idaho
Shelocta
Urling No. 3
"D" Seam
LIMIT OF MINING
LIMIT OF MINING
1" = 1000'
APRIL 1978
Keystone Power Co. - SURFACE OUTLINER IN RED
PROBABLE SURFACE MINING - MAHONING & UPPER FREEPORT
10276-130

IMAPS # 11628