


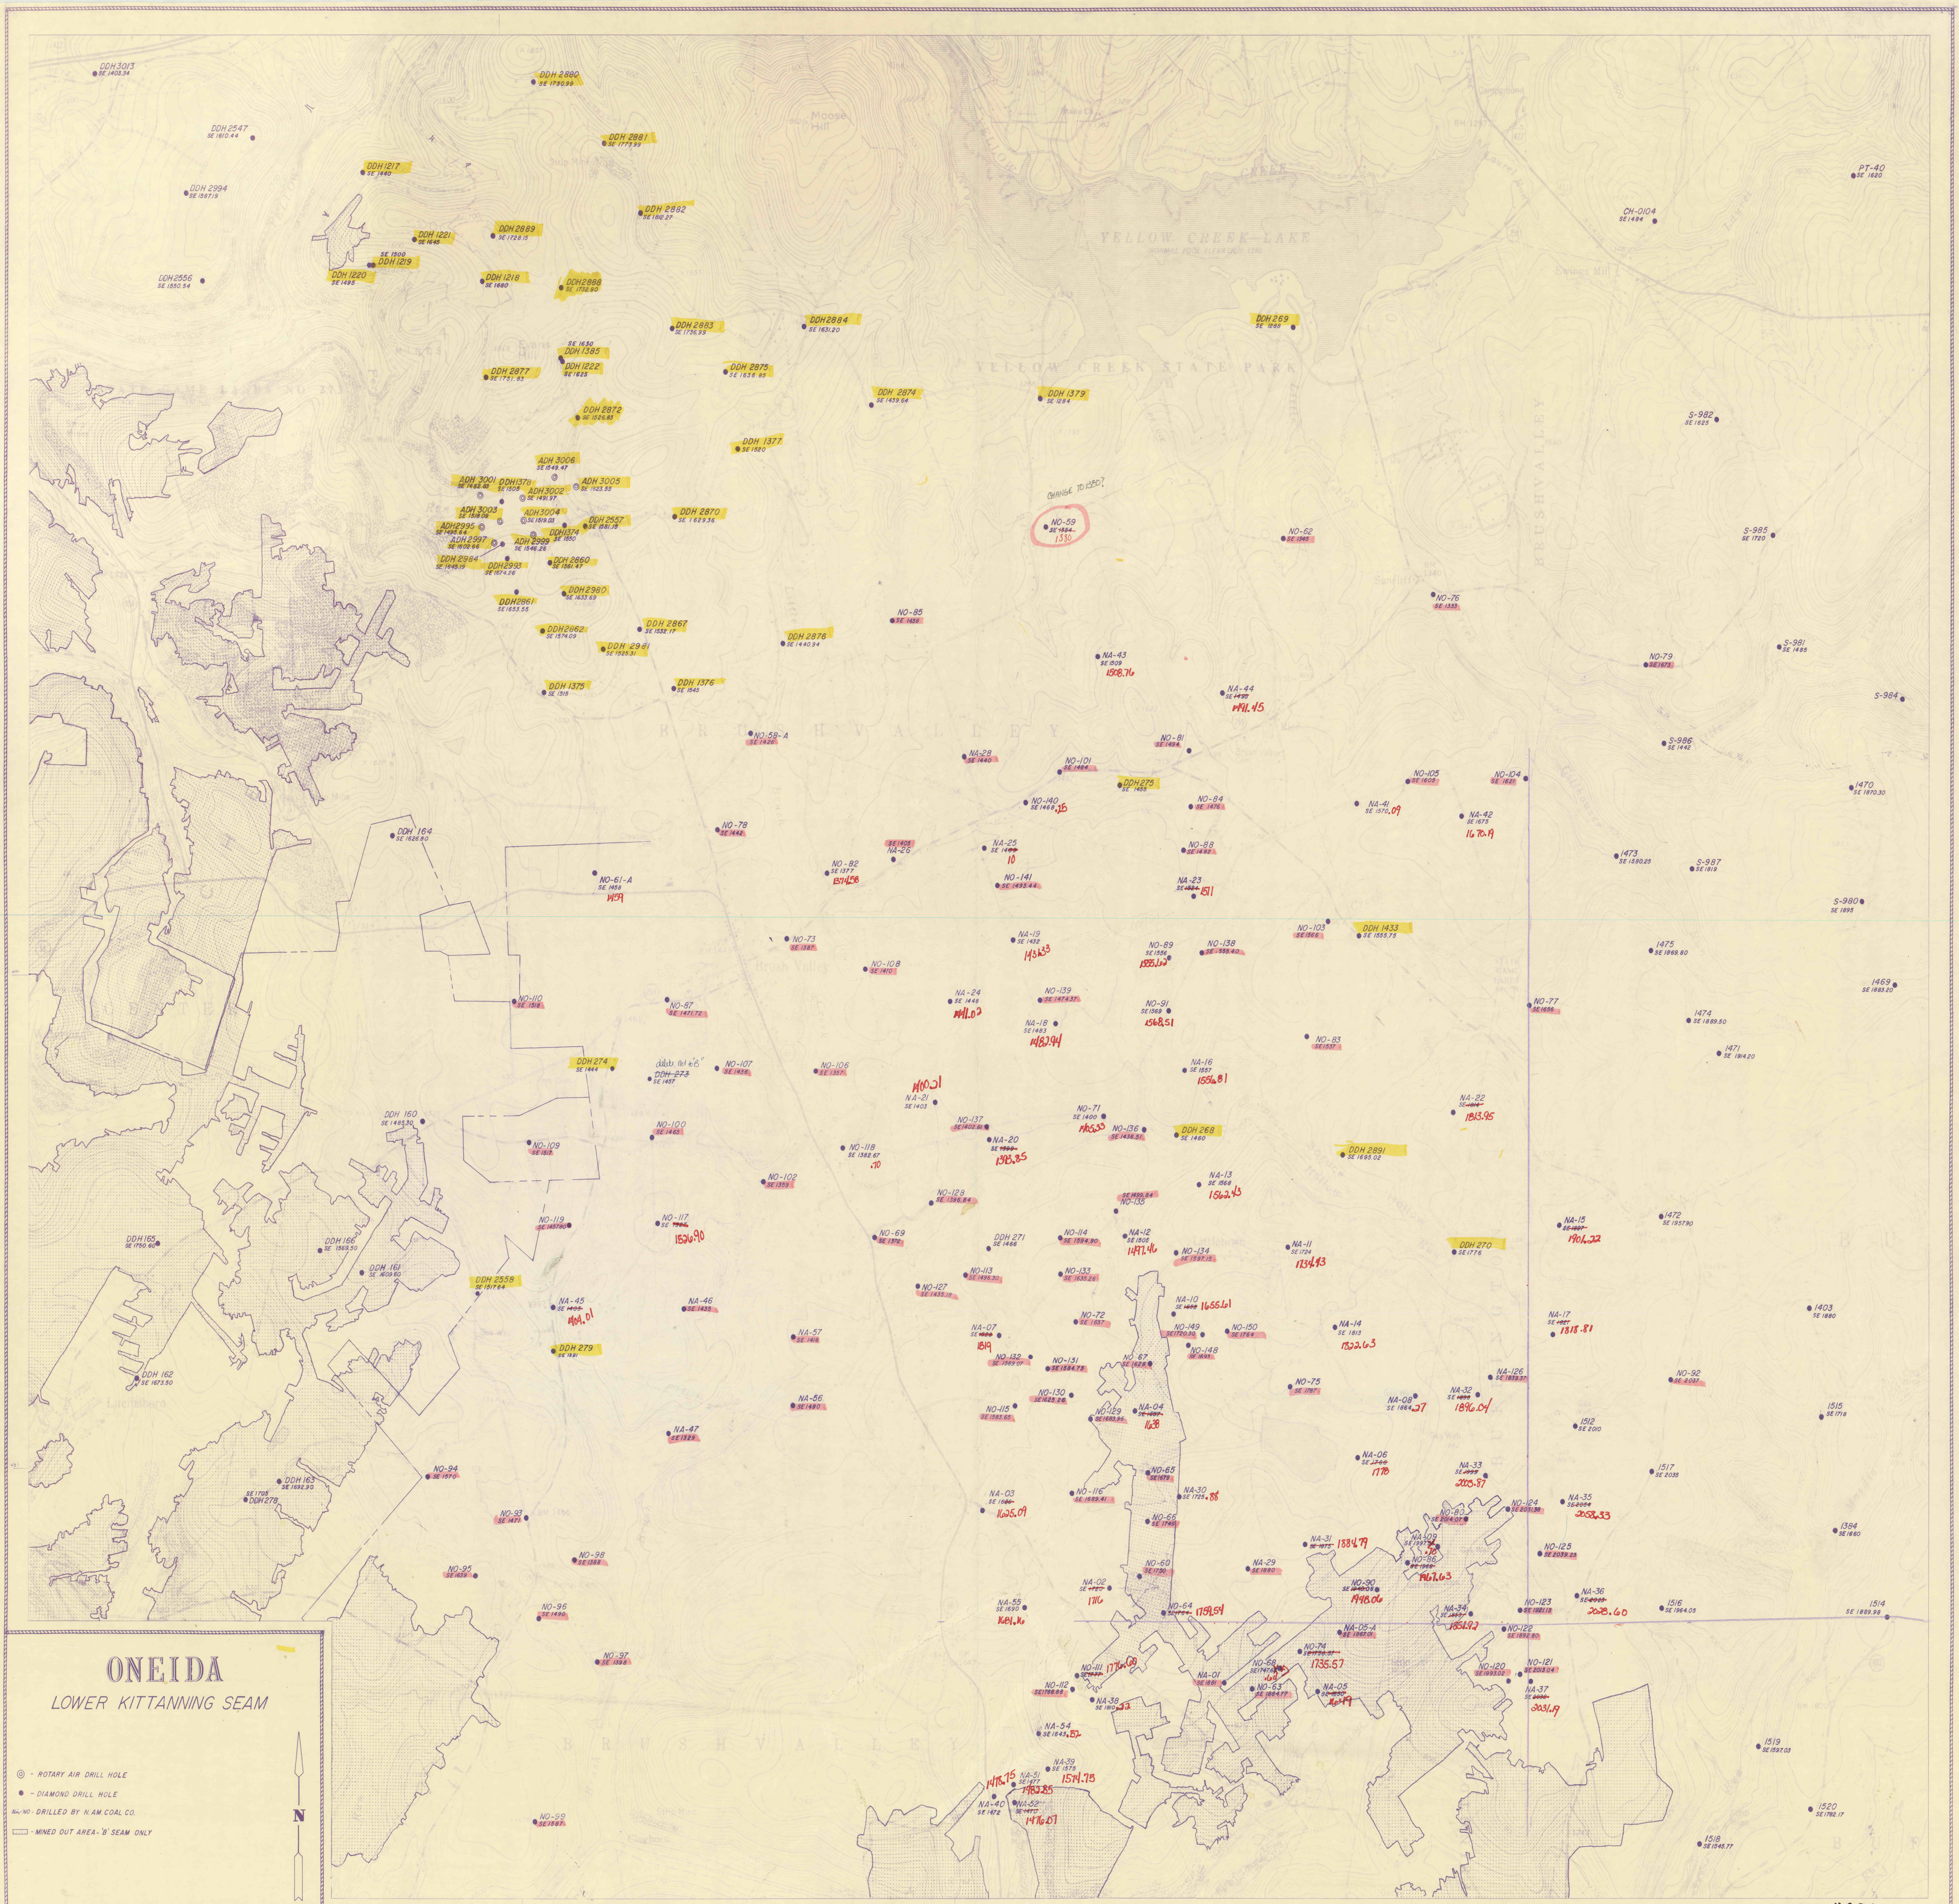

ONEIDA
LOWER KITTANNING SEAM

● - ROTARY AIR DRILL HOLE
● - DIAMOND DRILL HOLE
--- MINED OUT AREA - B SEAM ONLY