


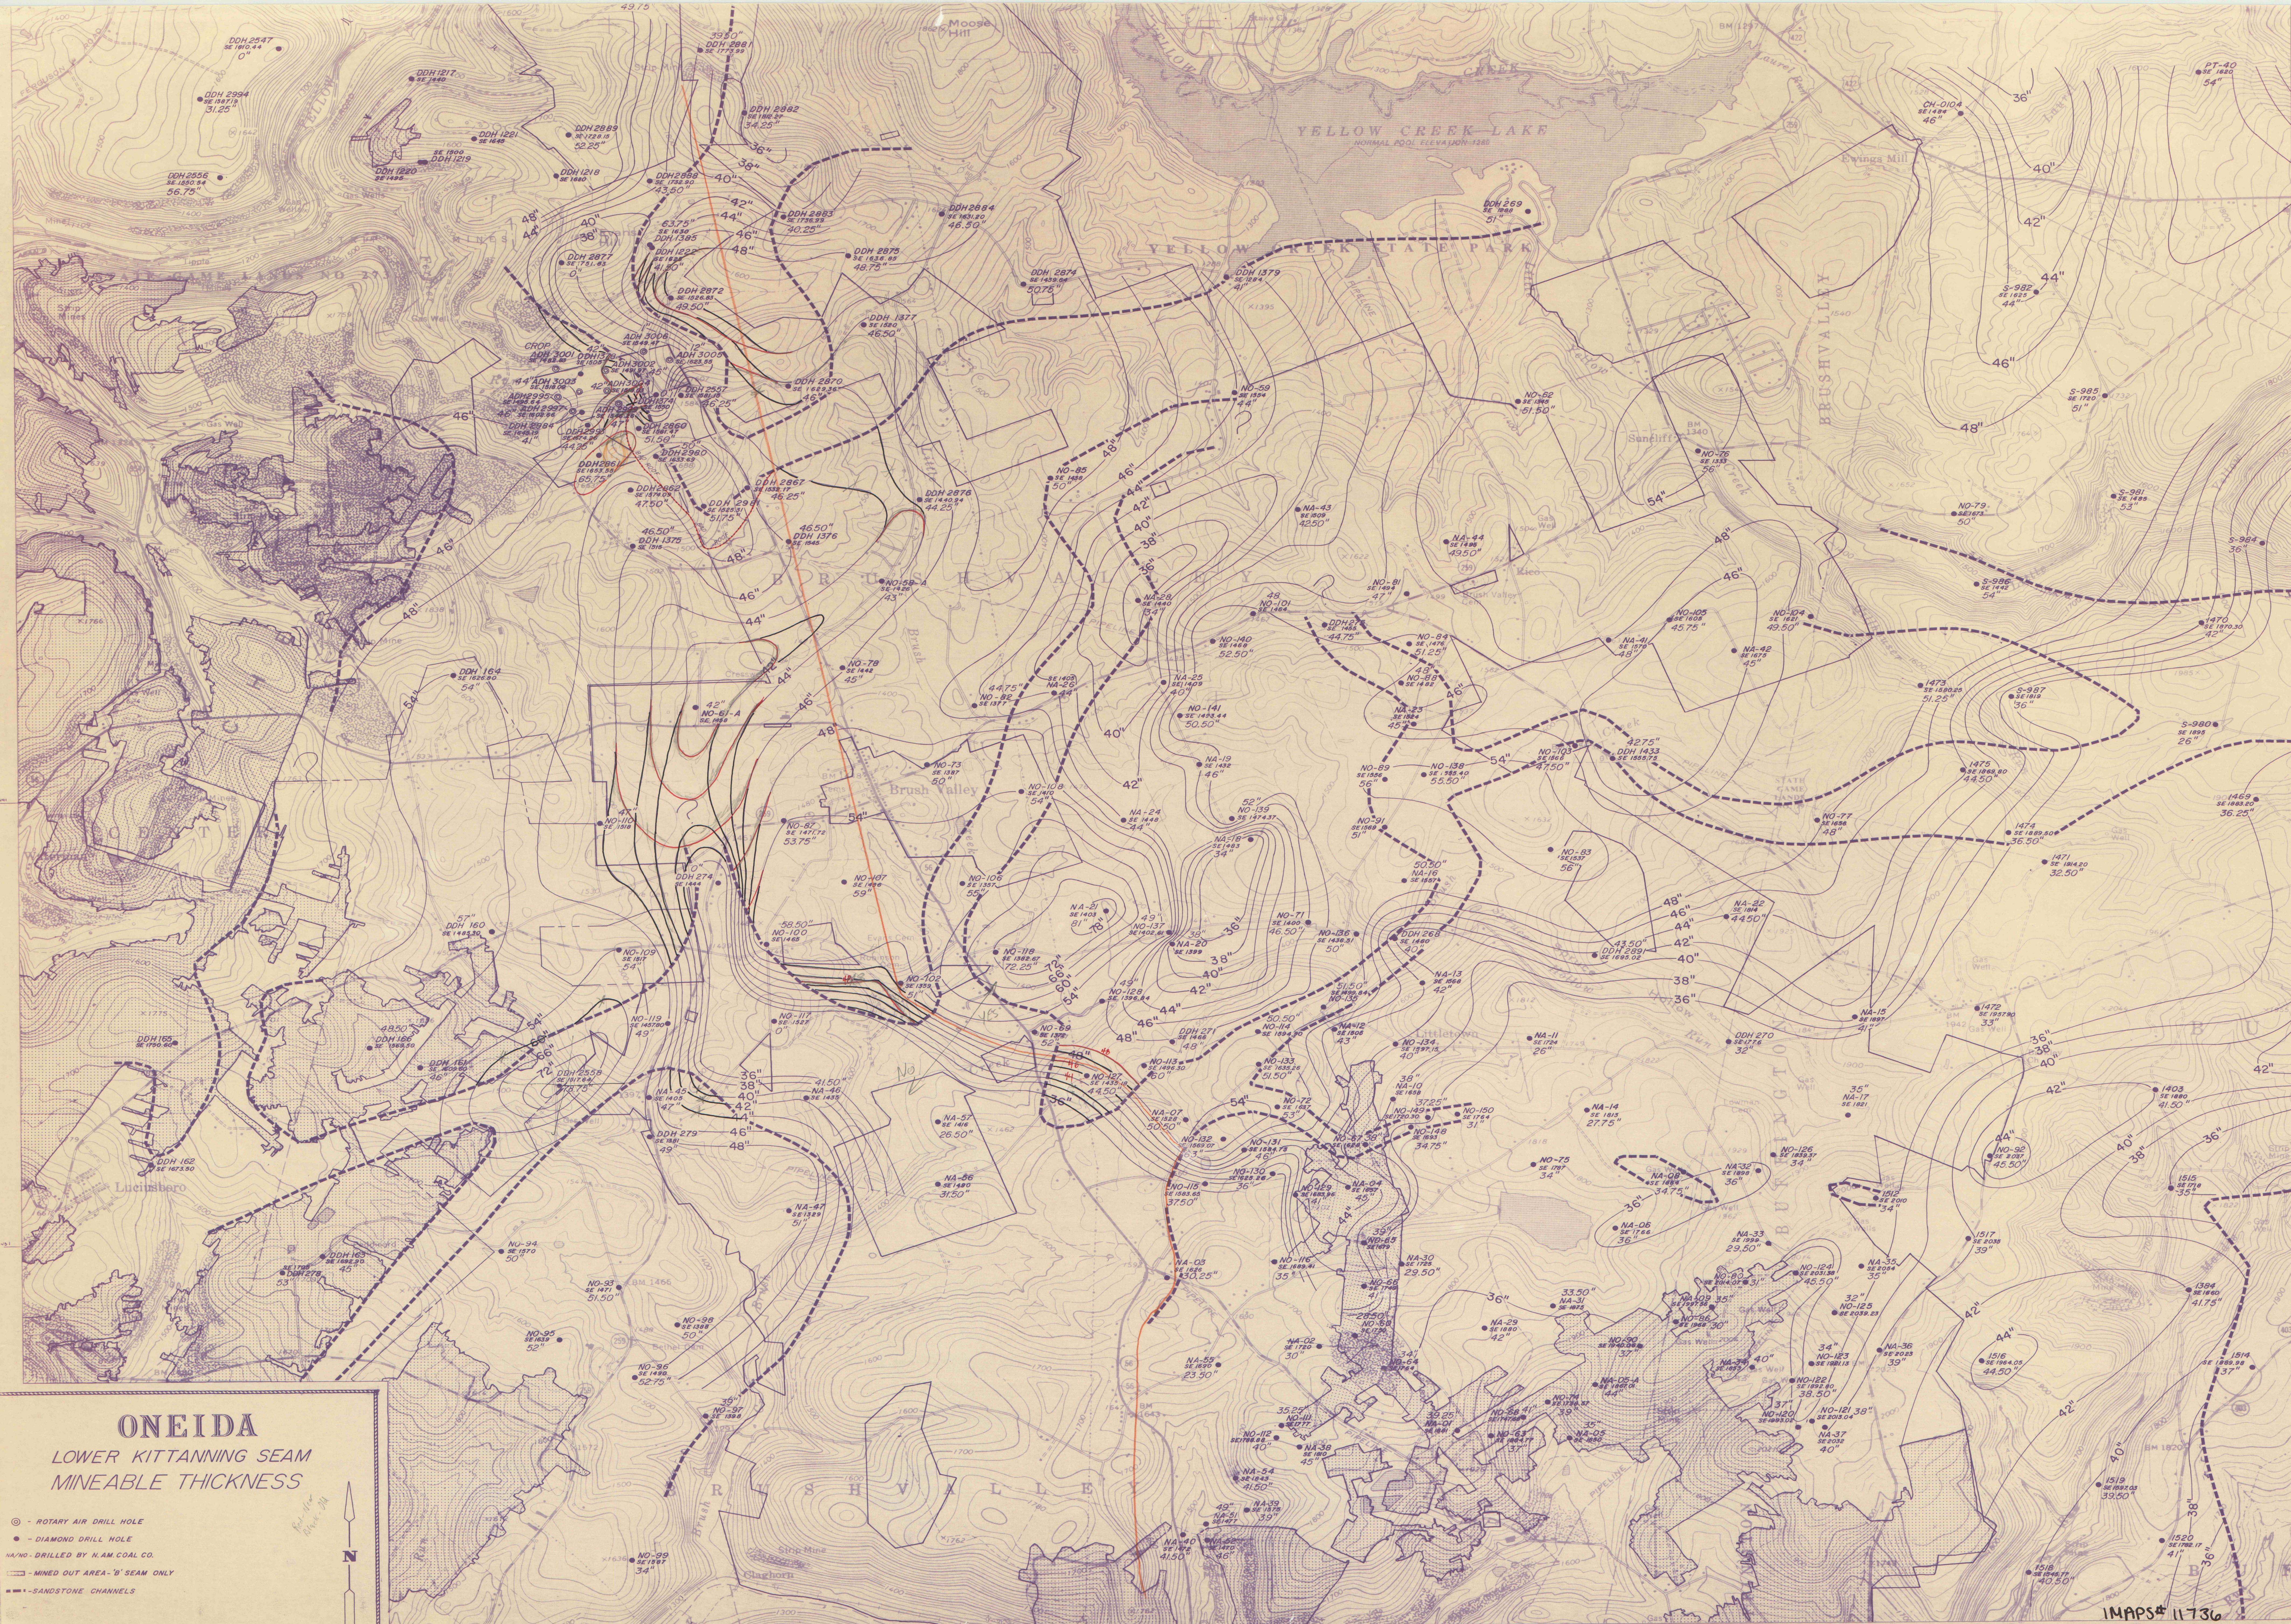

ONEIDA
LOWER KITTANNING SEAM
MINEABLE THICKNESS

- ⊙ - ROTARY AIR DRILL HOLE
- - DIAMOND DRILL HOLE
- NA-NO. DRILLED BY N.A.M. COAL CO.
- MINED OUT AREA - 'B' SEAM ONLY
- SANDSTONE CHANNELS