


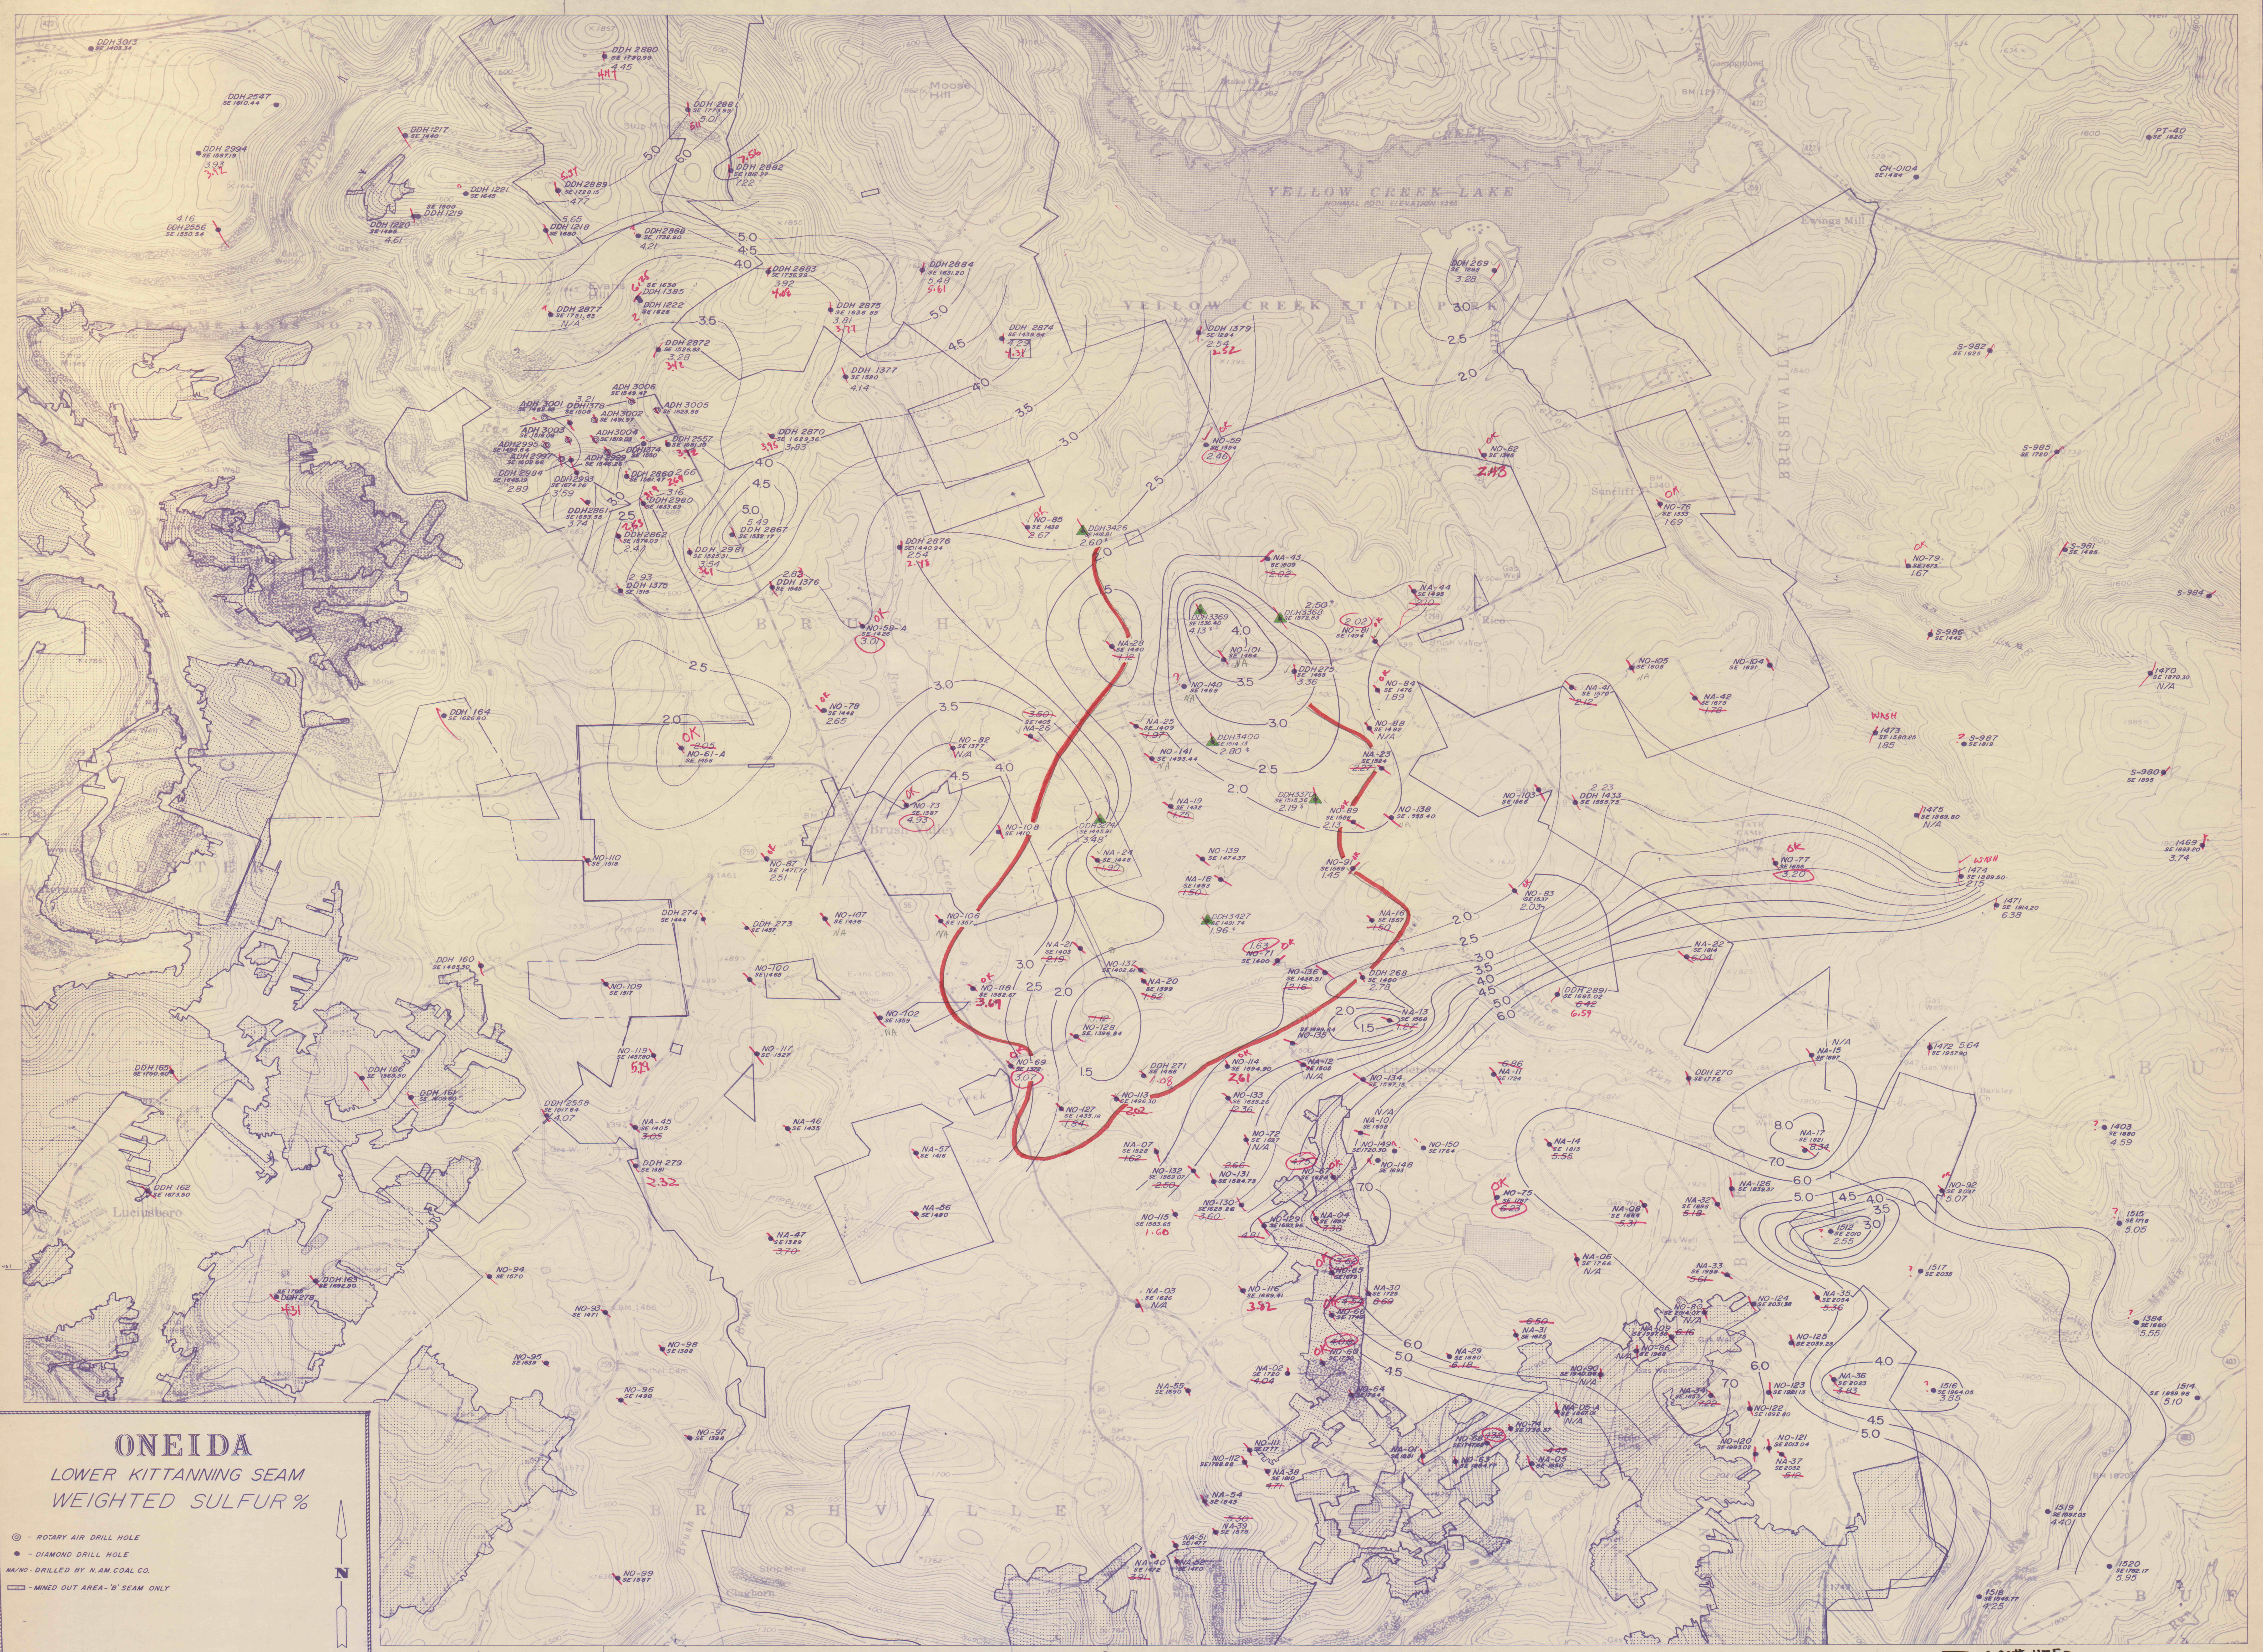

ONEIDA

LOWER KITTANNING SEAM
WEIGHTED SULFUR %

● - ROTARY AIR DRILL HOLE

◆ - DIAMOND DRILL HOLE

NA/NO - DRILLED BY N.A.M. COAL CO.

▭ - MINED OUT AREA - D' SEAM ONLY

↑ N

REV 9-91

1"=1,000'

REV 9-91