


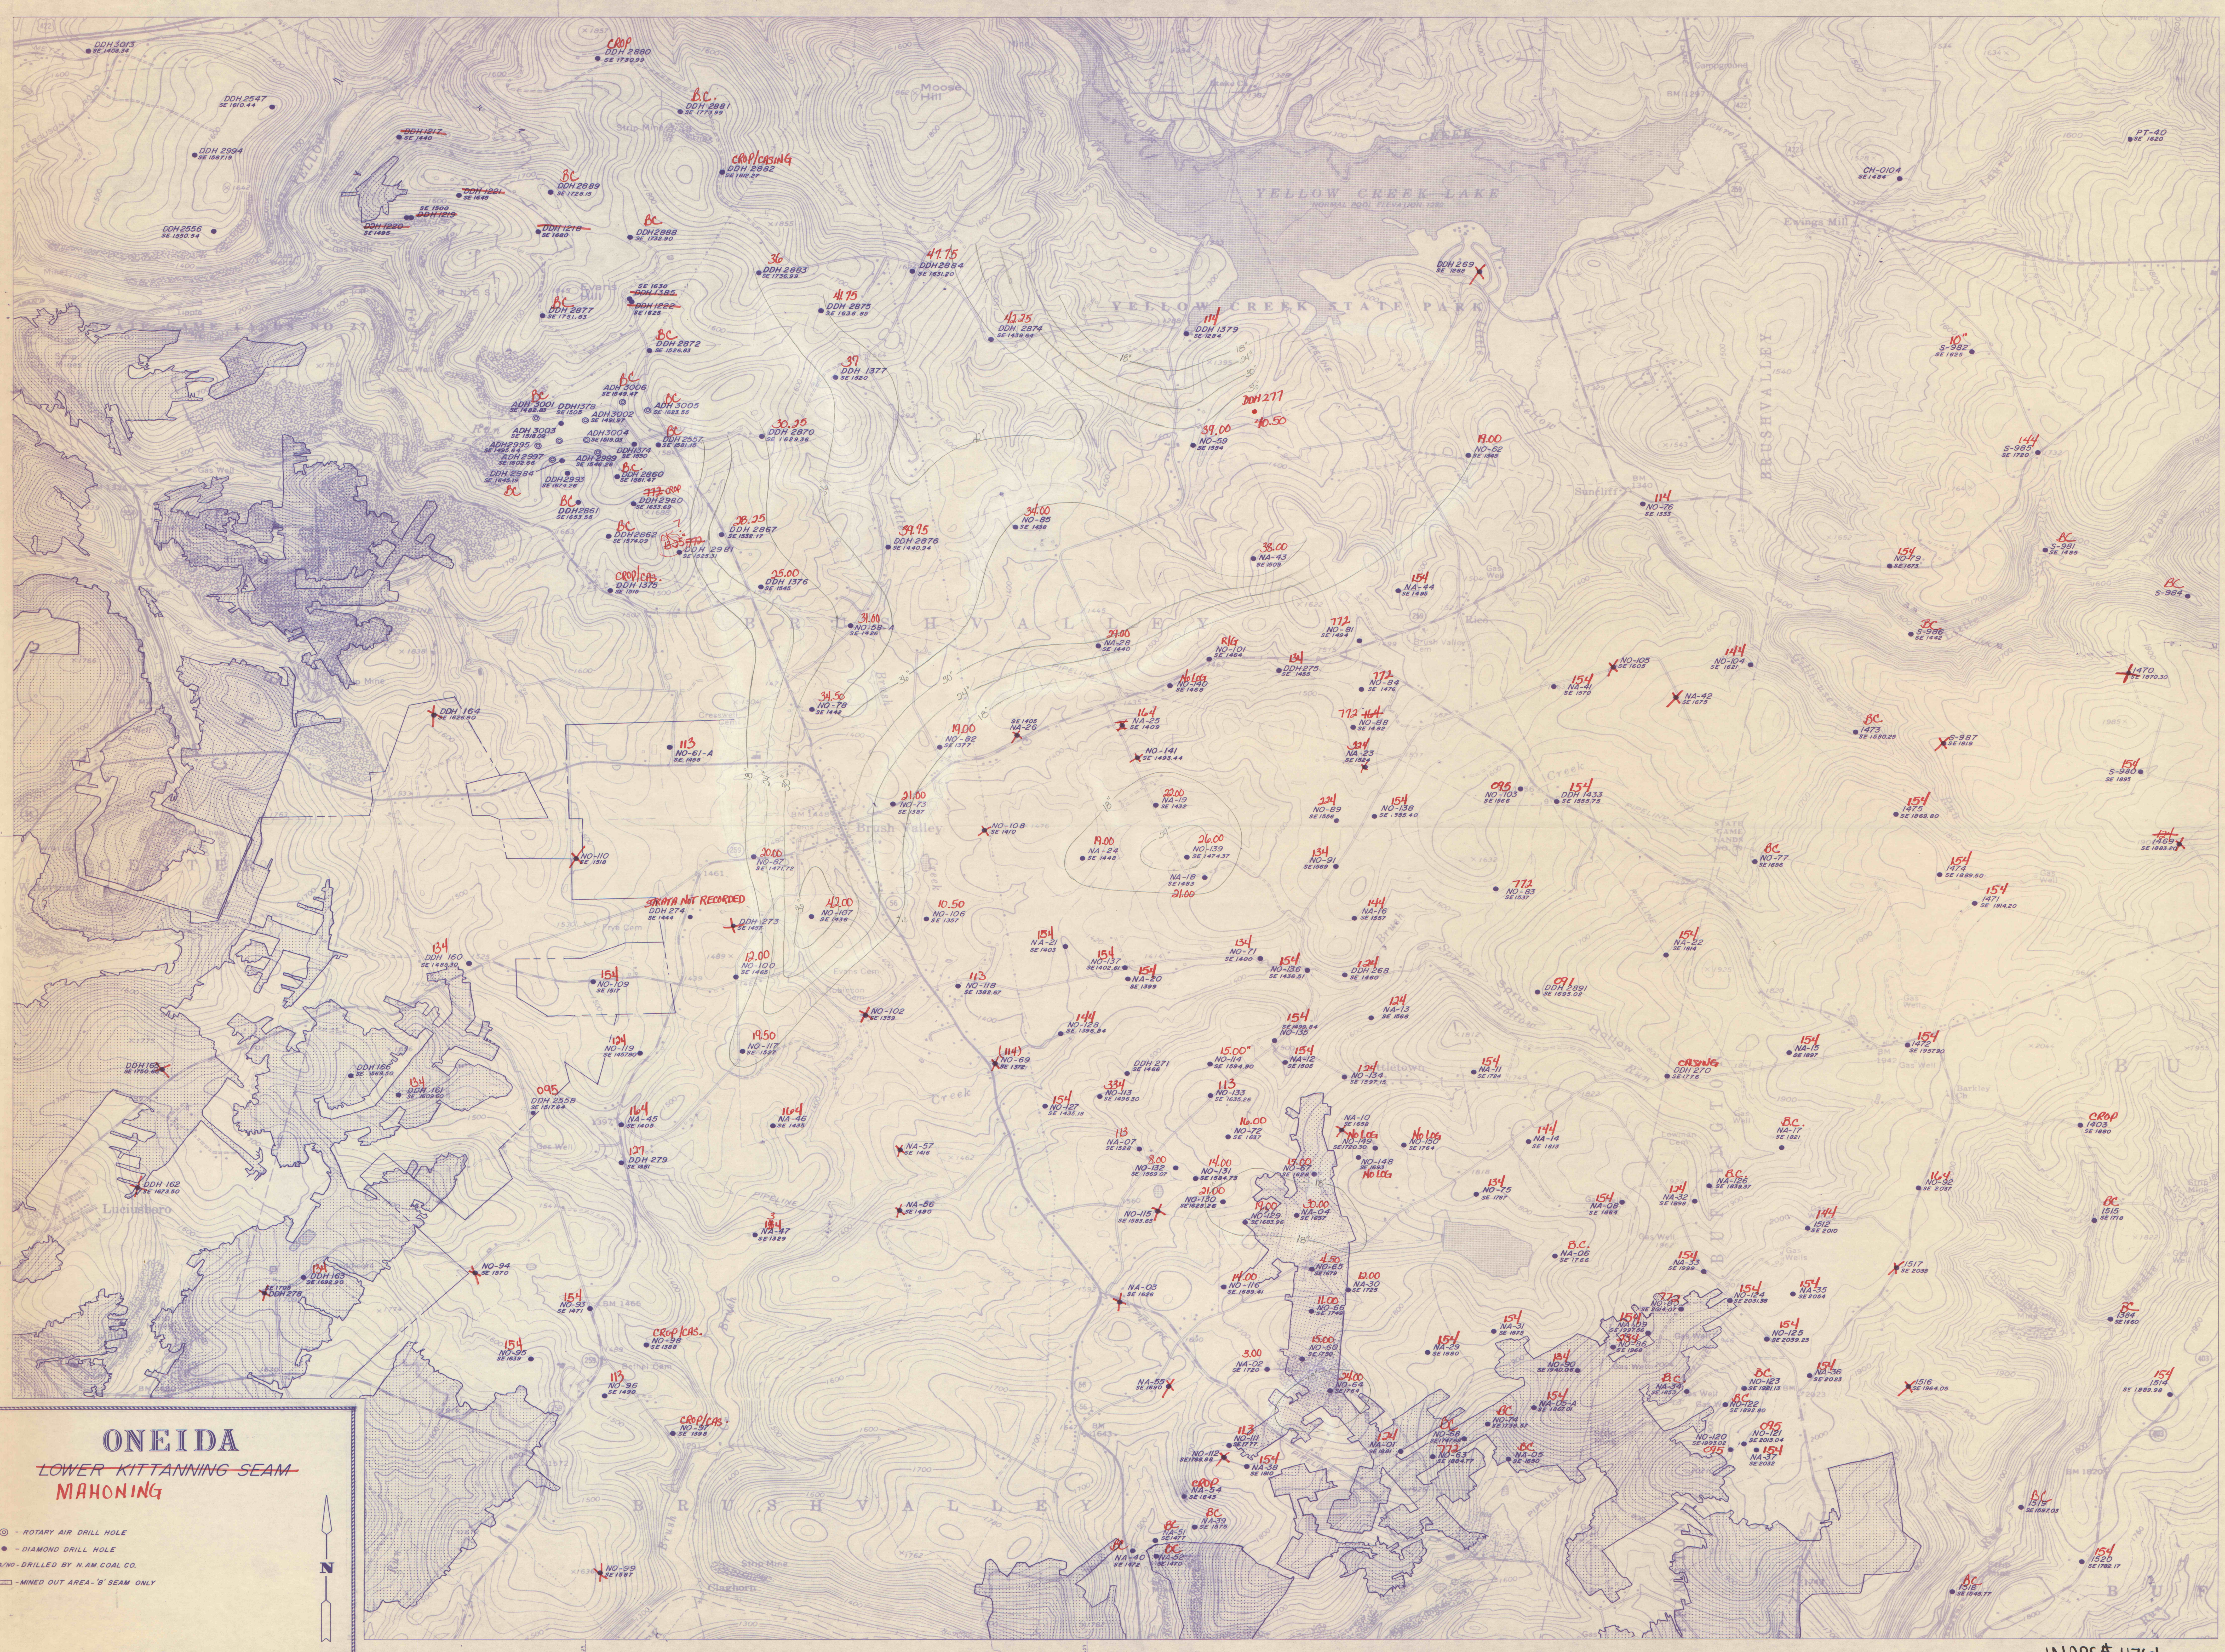

ONEIDA
LOWER KITTANNING SEAM-
MAHONING

- ⊙ - ROTARY AIR DRILL HOLE
- - DIAMOND DRILL HOLE
- NA/NO - DRILLED BY N.A.M. COAL CO.
- ▭ - MINED OUT AREA - 'B' SEAM ONLY