


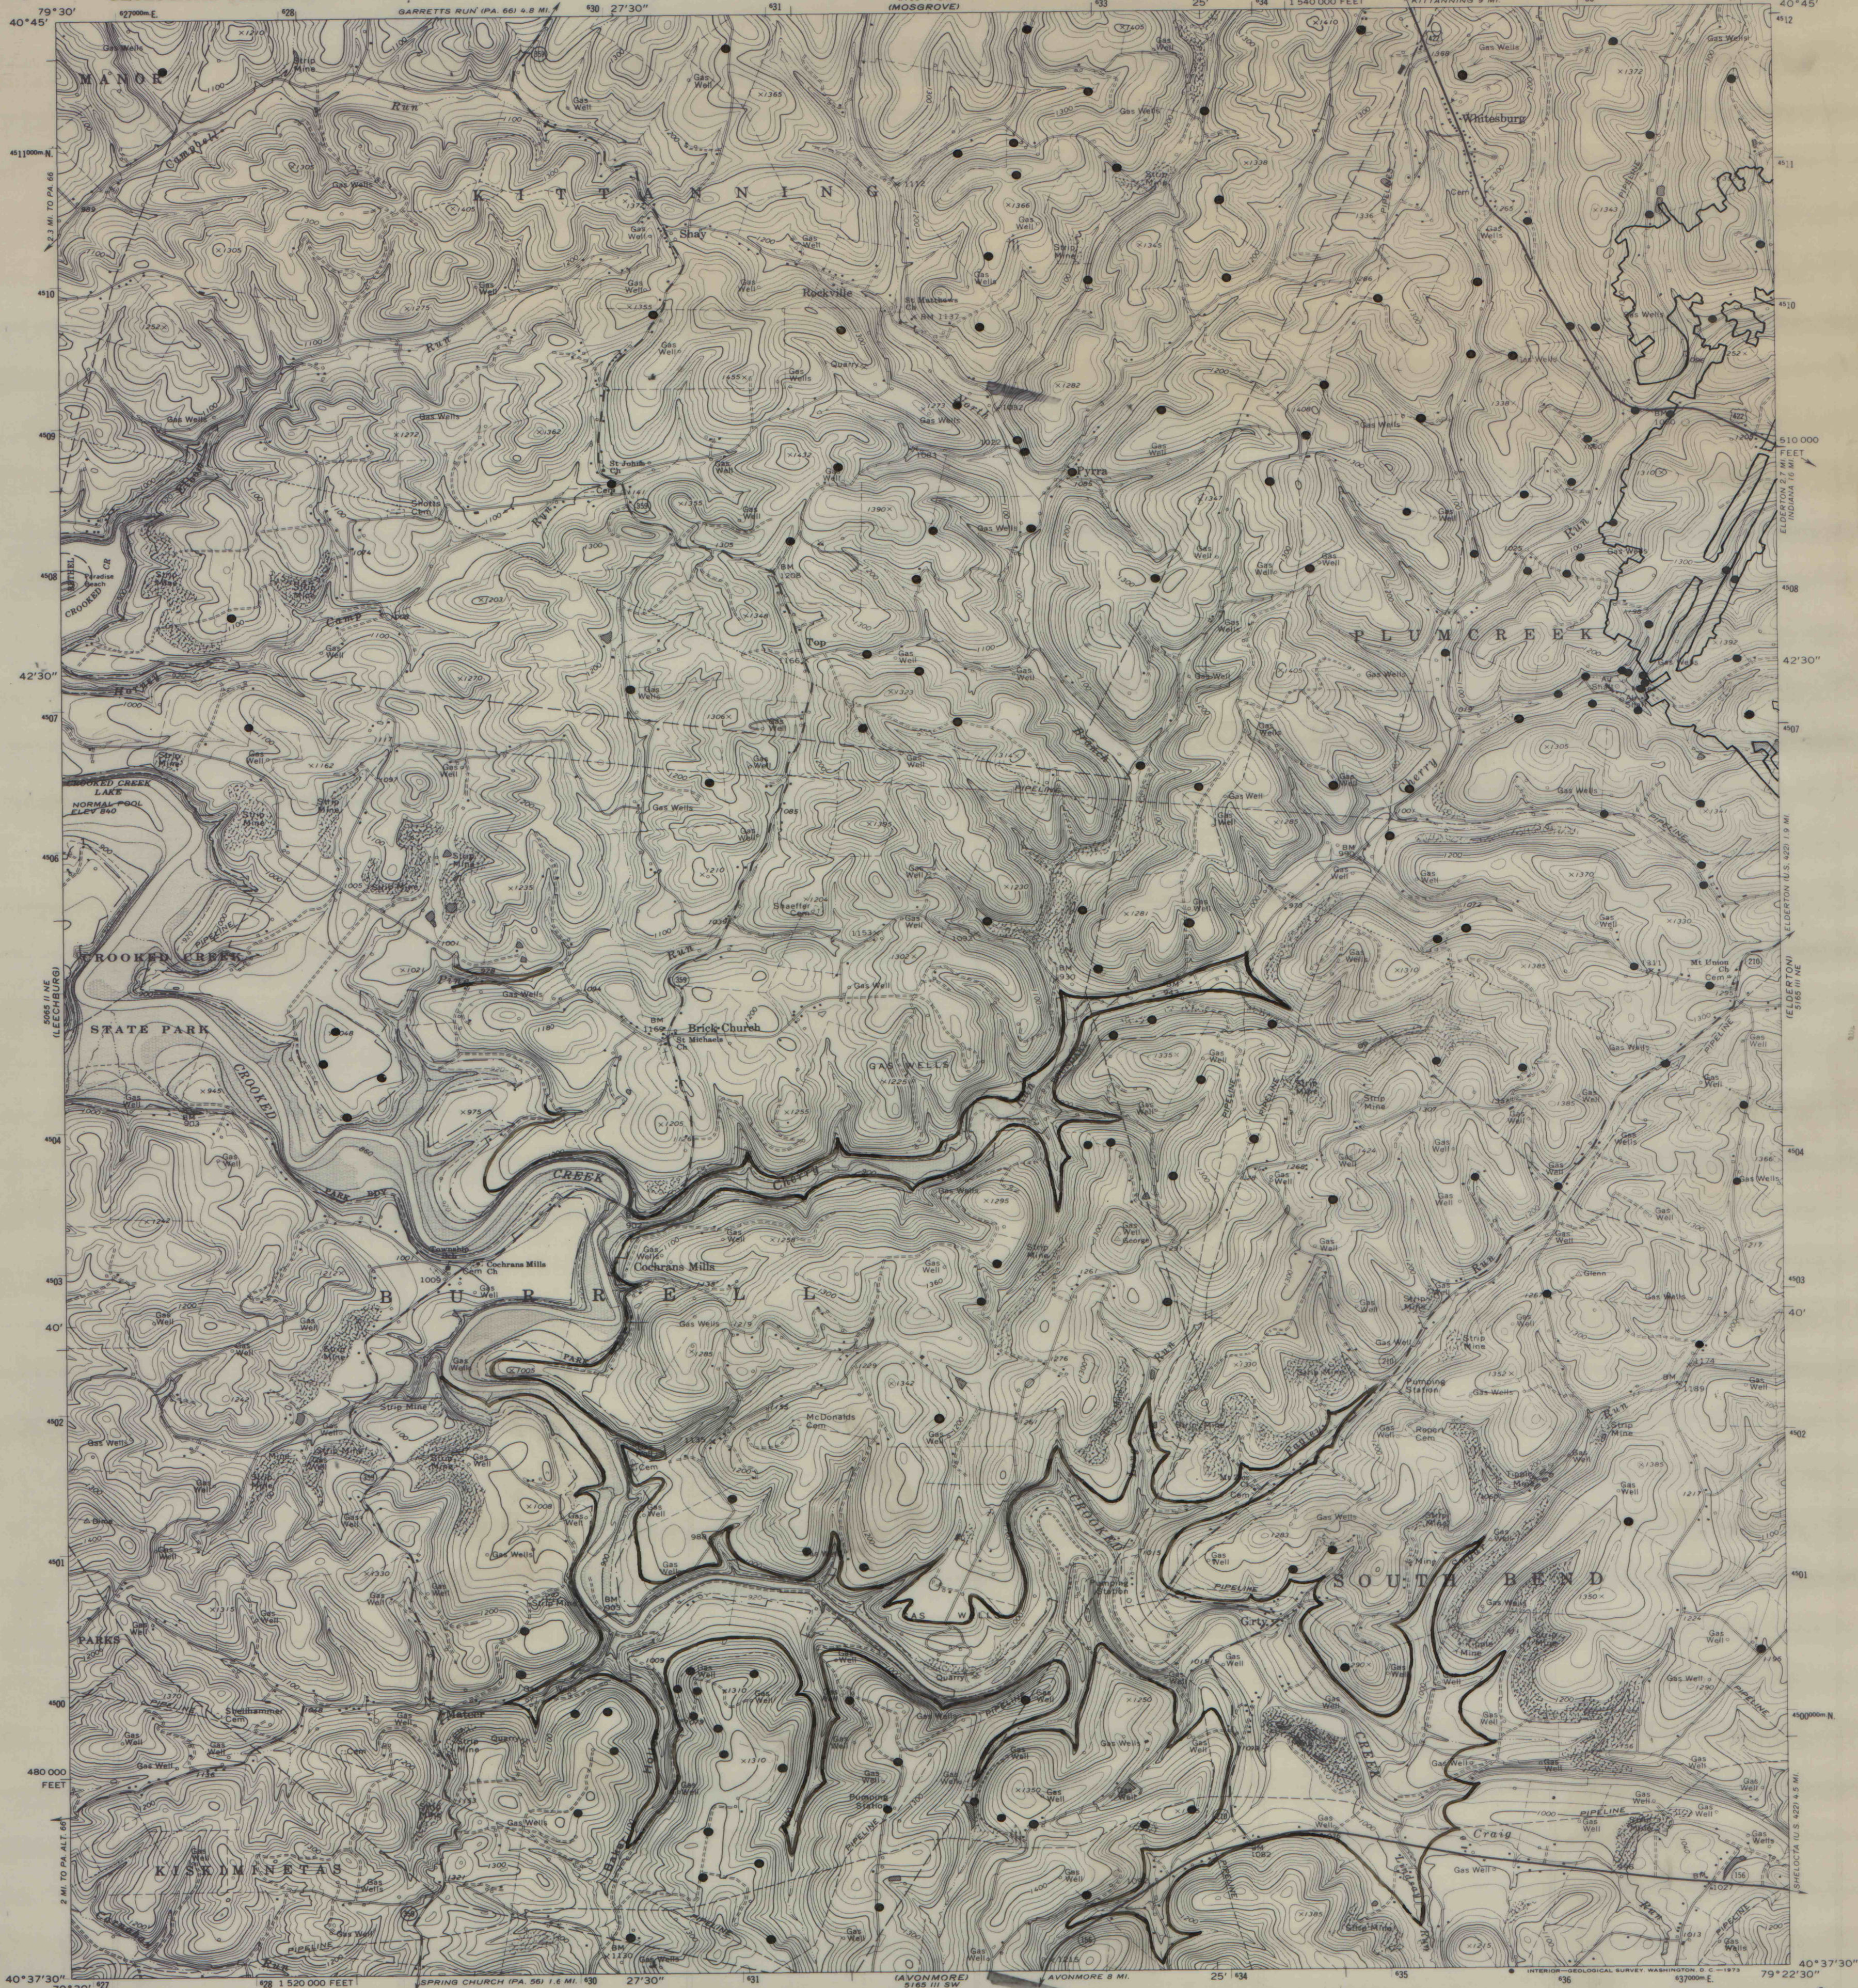

Mapped, edited, and published by the Geological Survey

Control by USGS and USC&GS

Topography by photogrammetric methods from aerial

photographs taken 1962 and 1963. Field checked 1964

Polyconic projection. 1927 North American datum

10,000-foot grid based on Pennsylvania coordinate system,

south zone

1000-meter Universal Transverse Mercator grid ticks,



zone 17, shown in blue

Fine red dashed lines indicate selected fence and field lines where



generally visible on aerial photographs. This information is unchecked

Areas covered by dashed light-blue pattern are subject to controlled

inundation

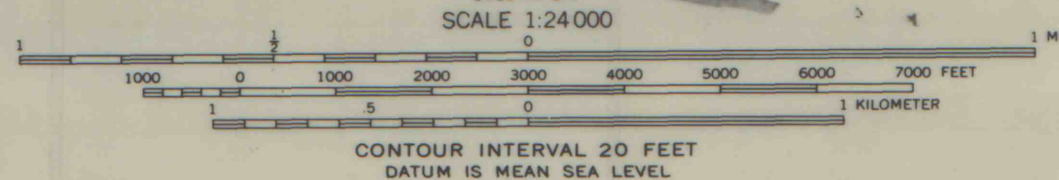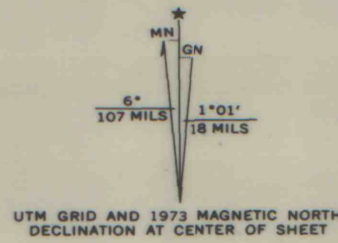

CONTOUR INTERVAL 20 FEET
DATUM IS MEAN SEA LEVEL

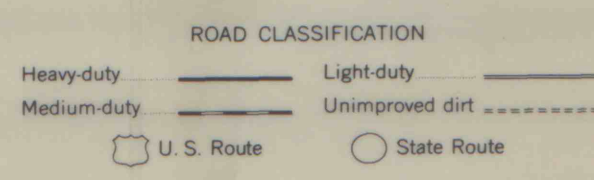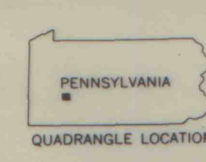

WHITESBURG, PA.

N4037.5—W7922.5/7.5

1964

PHOTOREVISED 1973

AMS 5165 III NW—SERIES V831

THIS MAP COMPLIES WITH NATIONAL MAP ACCURACY STANDARDS
FOR SALE BY U.S. GEOLOGICAL SURVEY, WASHINGTON, D.C. 20242
A FOLDER DESCRIBING TOPOGRAPHIC MAPS AND SYMBOLS IS AVAILABLE ON REQUEST

Revisions shown in purple compiled in cooperation with
State of Pennsylvania agencies from aerial photographs
taken 1973. This information not field checked

IMAPS # 11815