


Rochester & Pittsburgh Coal Company AVONMORE

MINI MAP

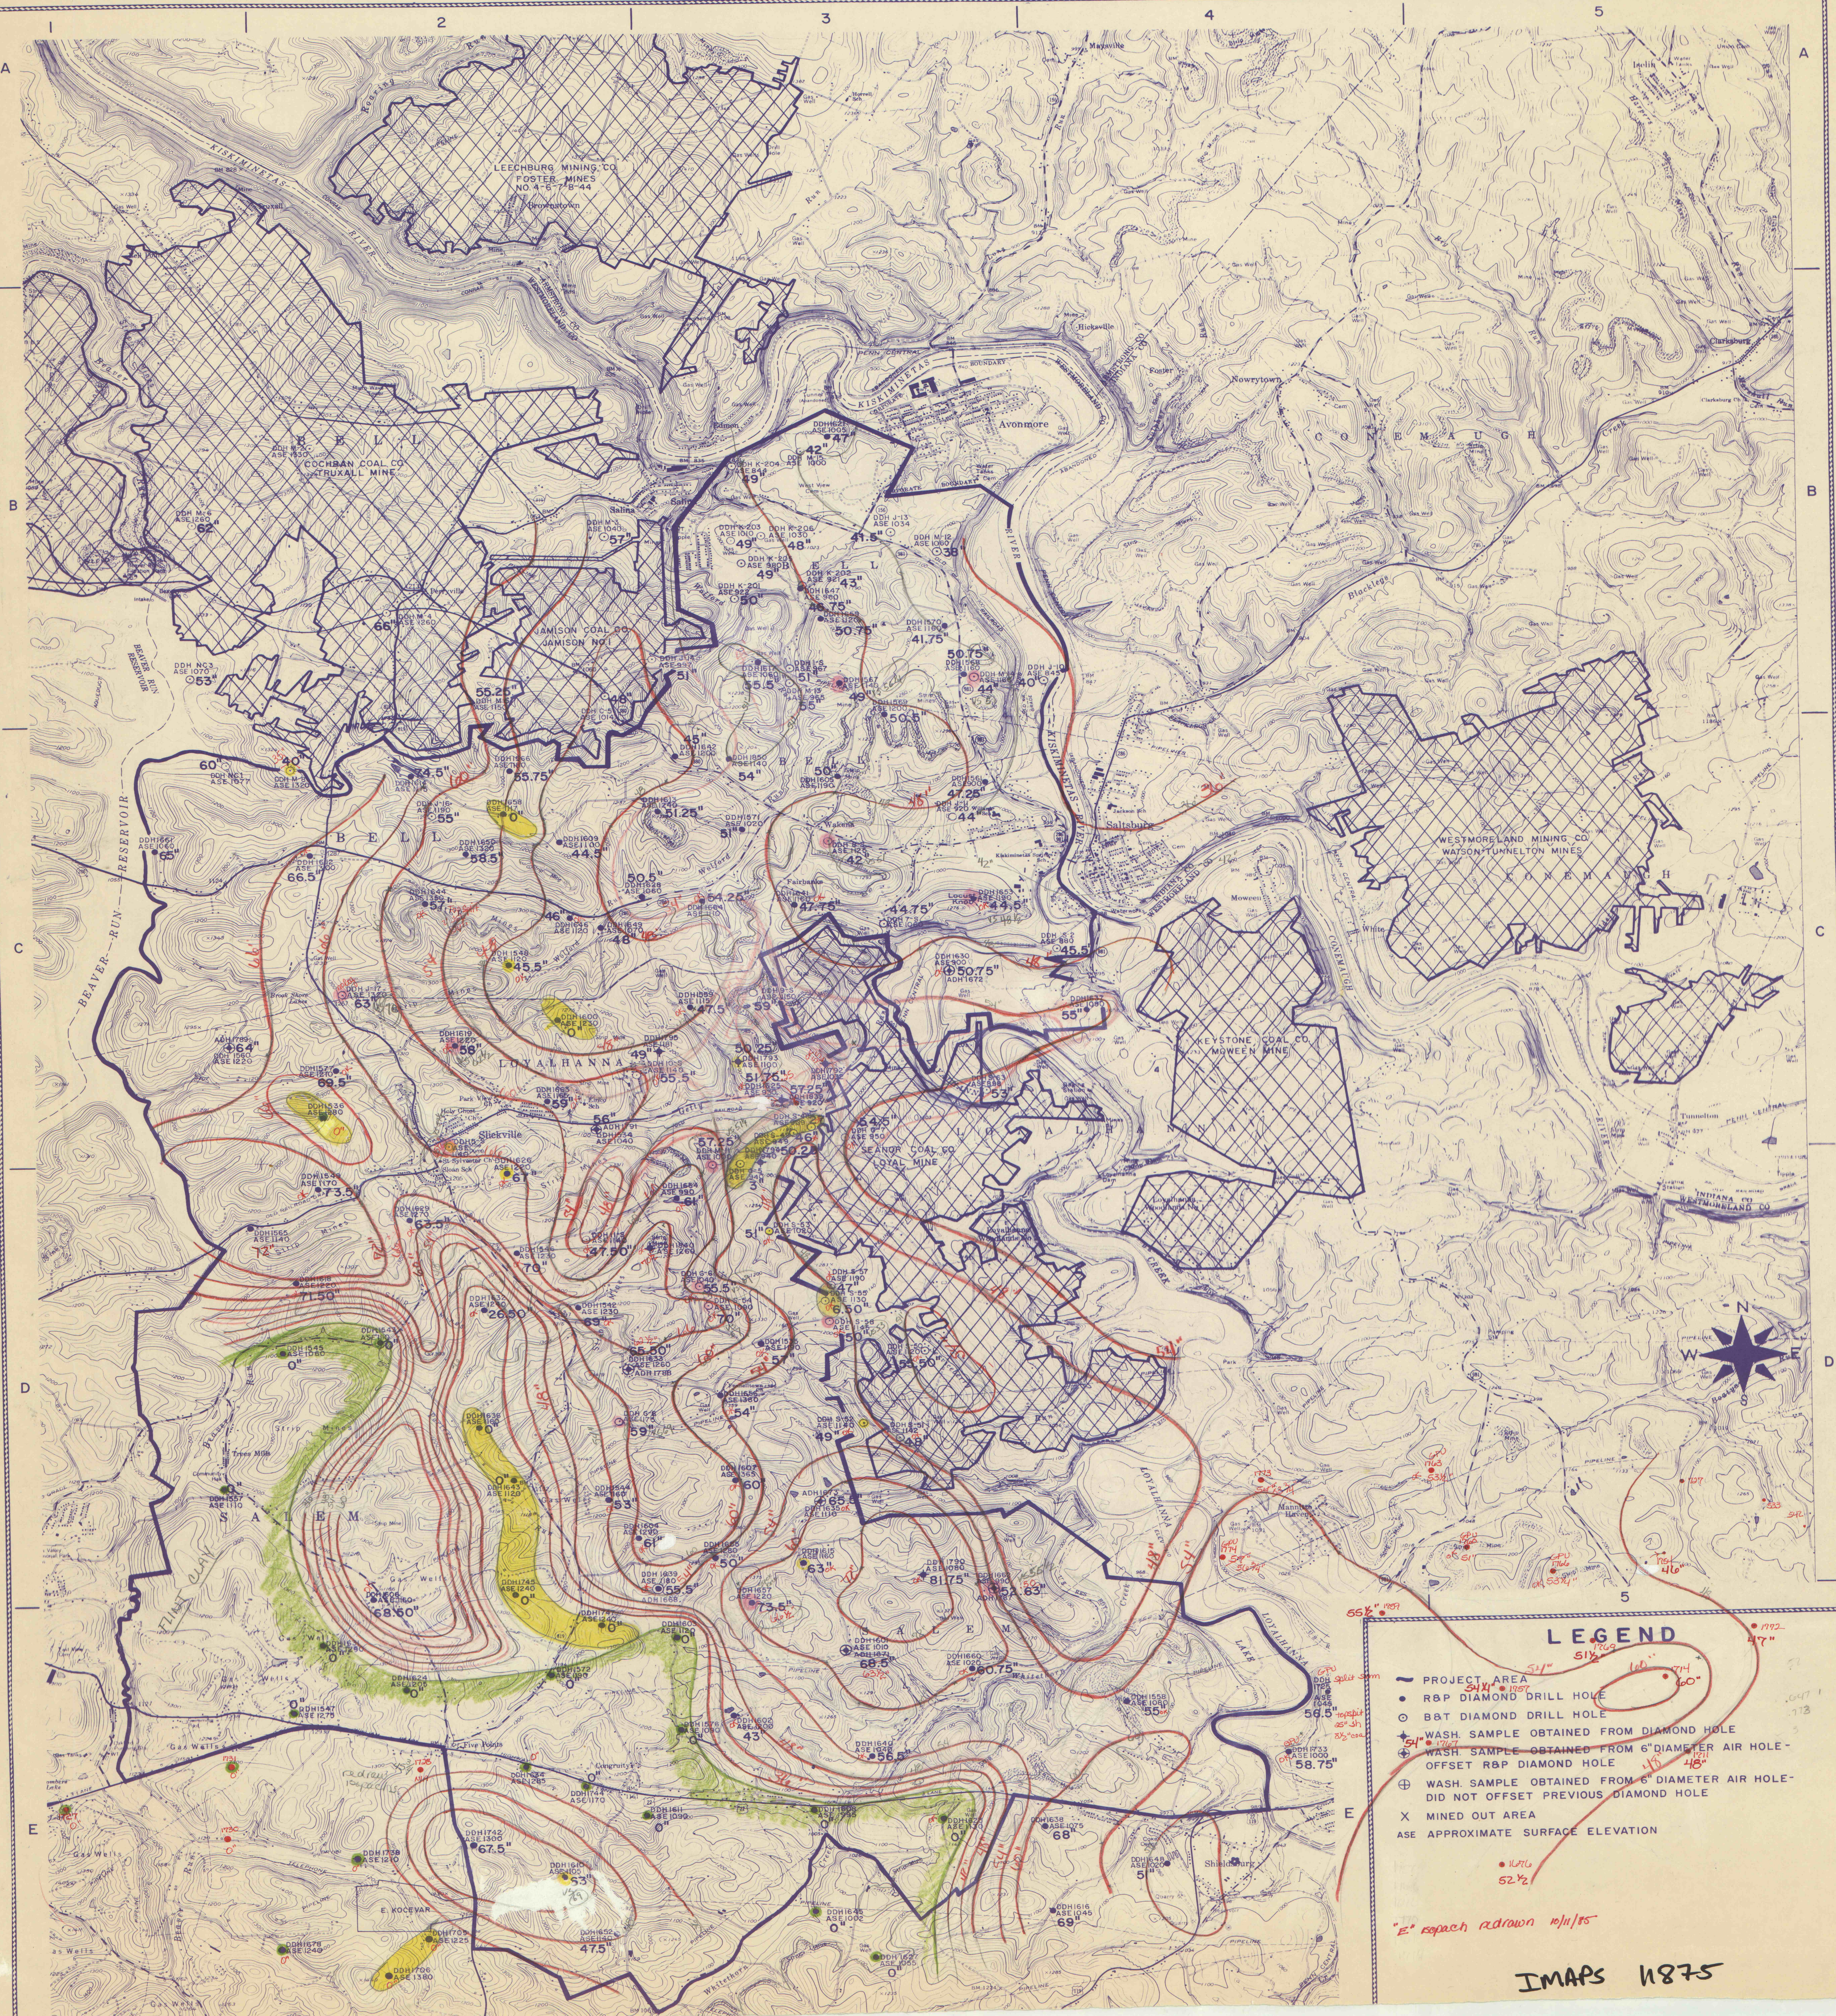

LEGEND

- PROJECT AREA
- R&P DIAMOND DRILL HOLE
- B&T DIAMOND DRILL HOLE
- WASH. SAMPLE OBTAINED FROM DIAMOND HOLE
- WASH. SAMPLE OBTAINED FROM 6" DIAMETER AIR HOLE - OFFSET R&P DIAMOND HOLE
- WASH. SAMPLE OBTAINED FROM 6" DIAMETER AIR HOLE - DID NOT OFFSET PREVIOUS DIAMOND HOLE
- X MINED OUT AREA
- ASE APPROXIMATE SURFACE ELEVATION

E' sketch redrawn 11/11/85

IMAPS 11875