


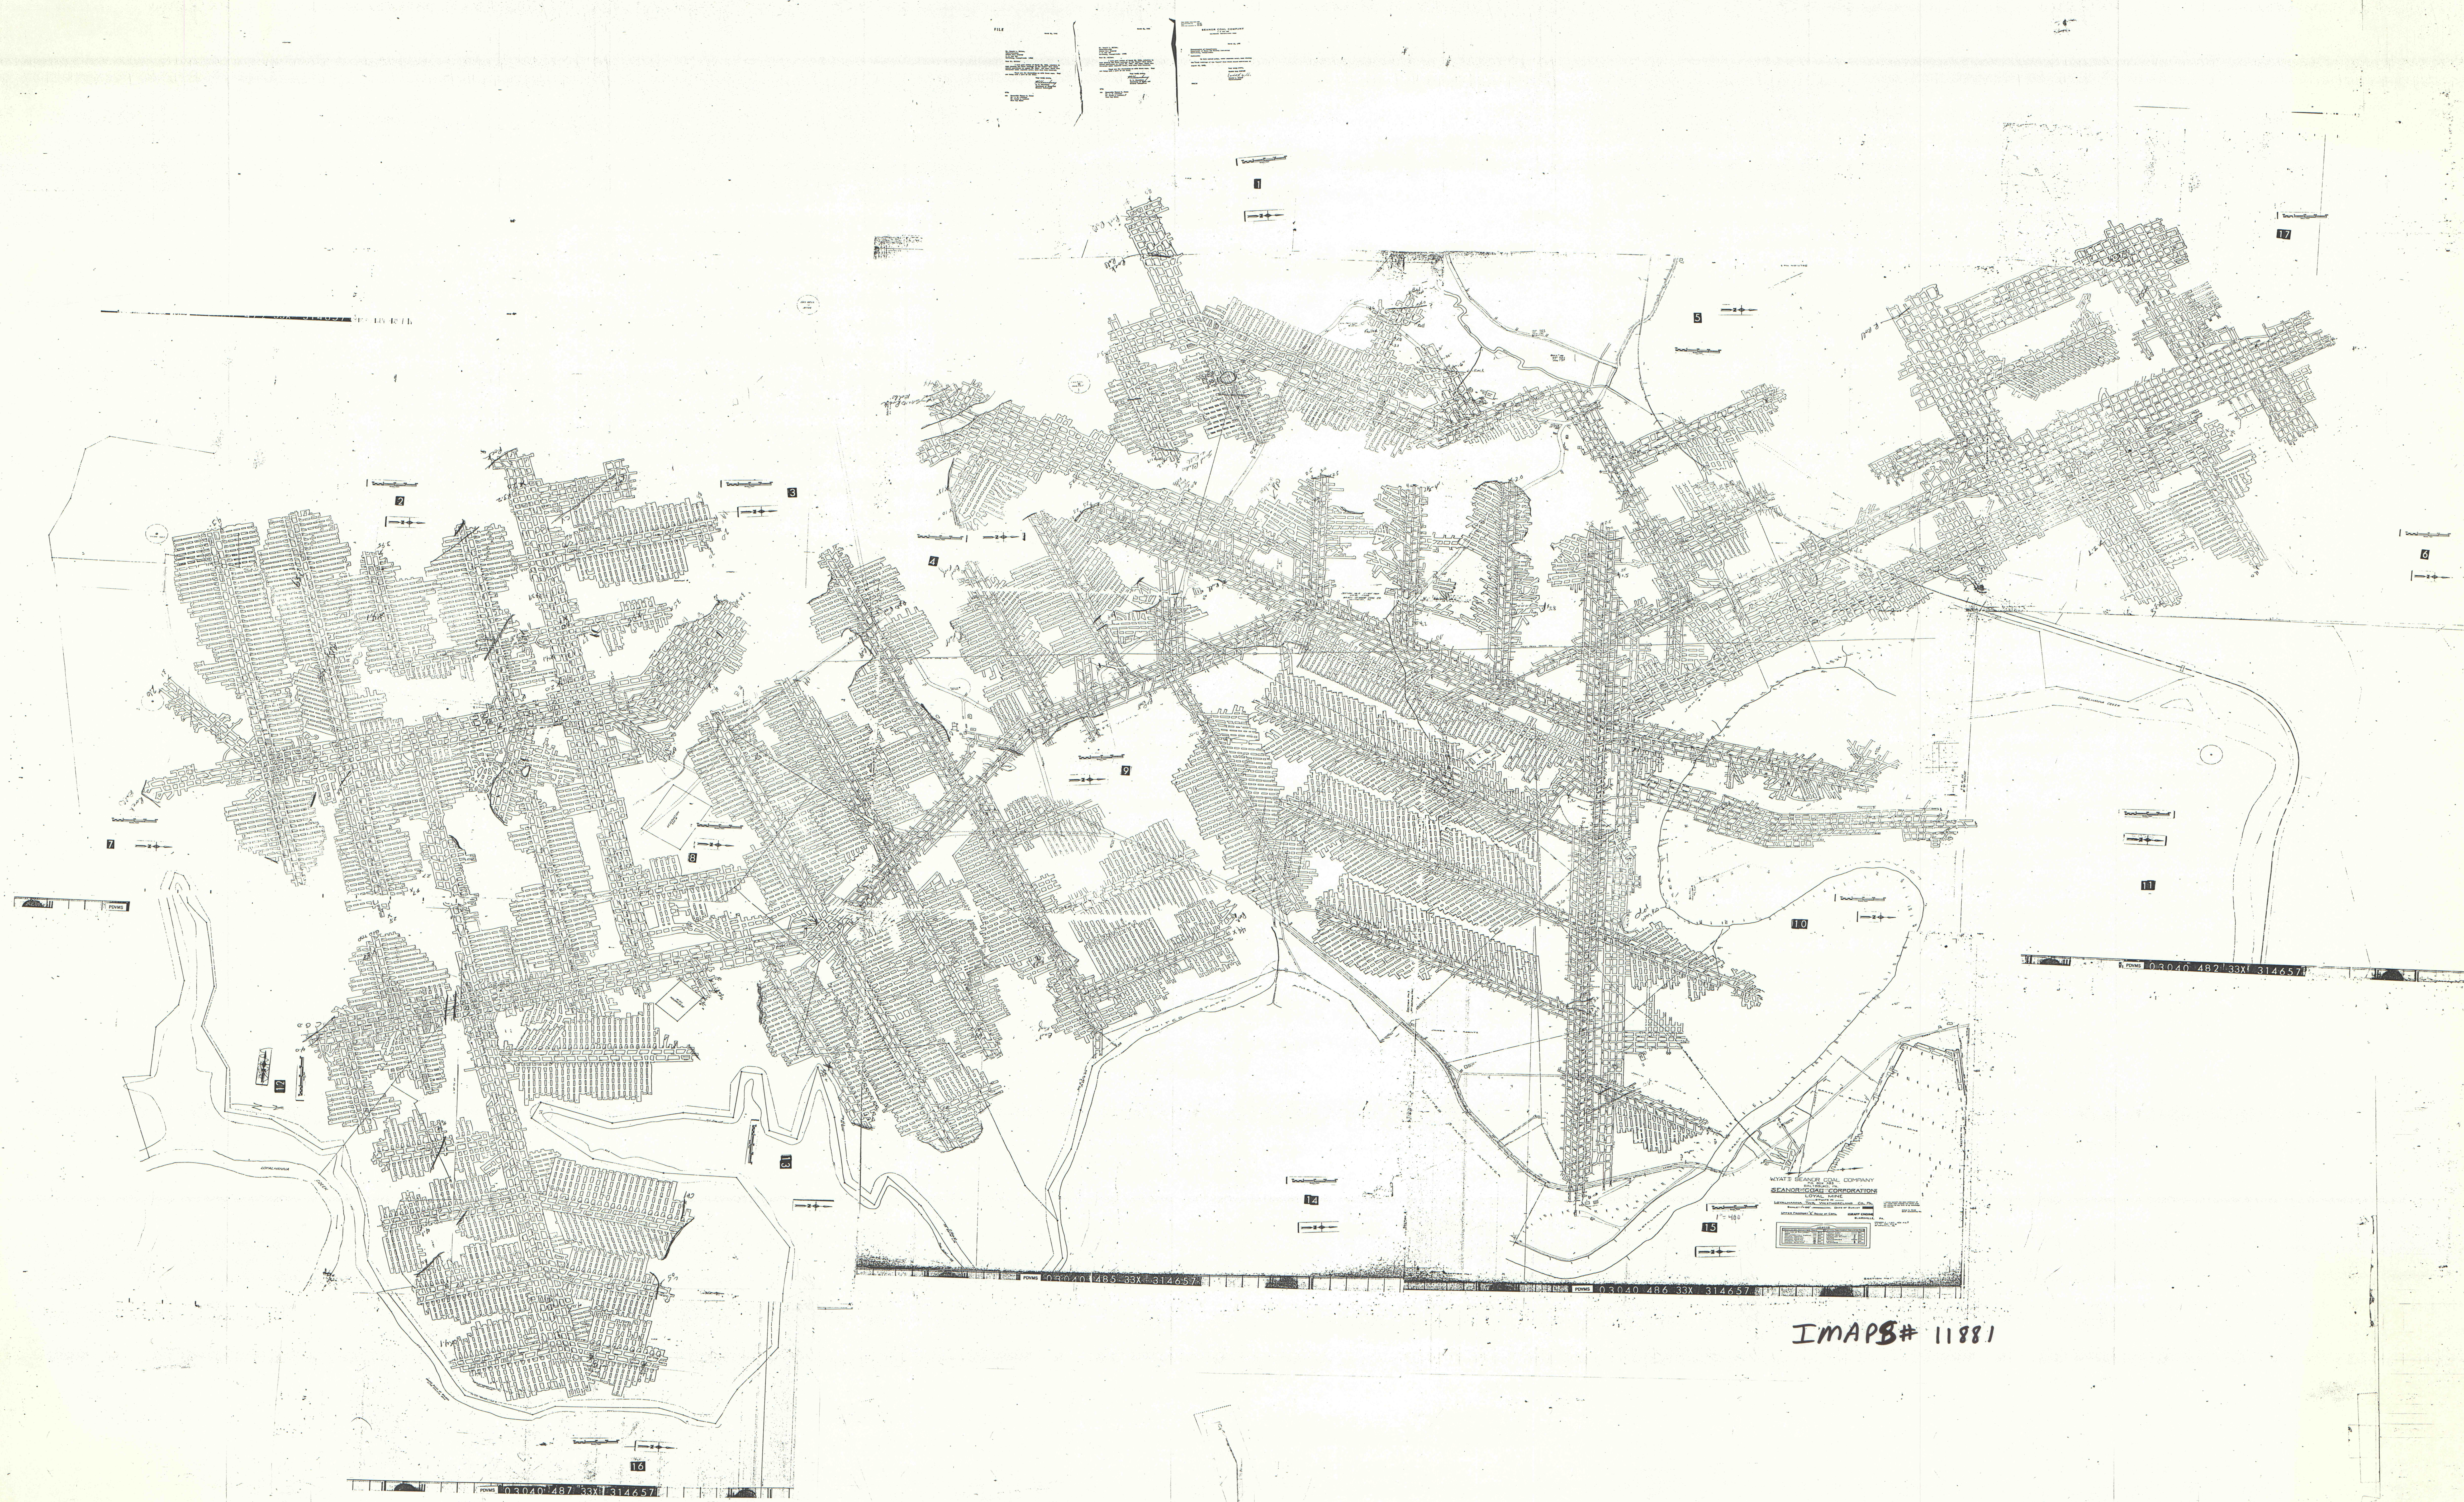

IMAPB# 11881