


AVONMARE

NEW HALL

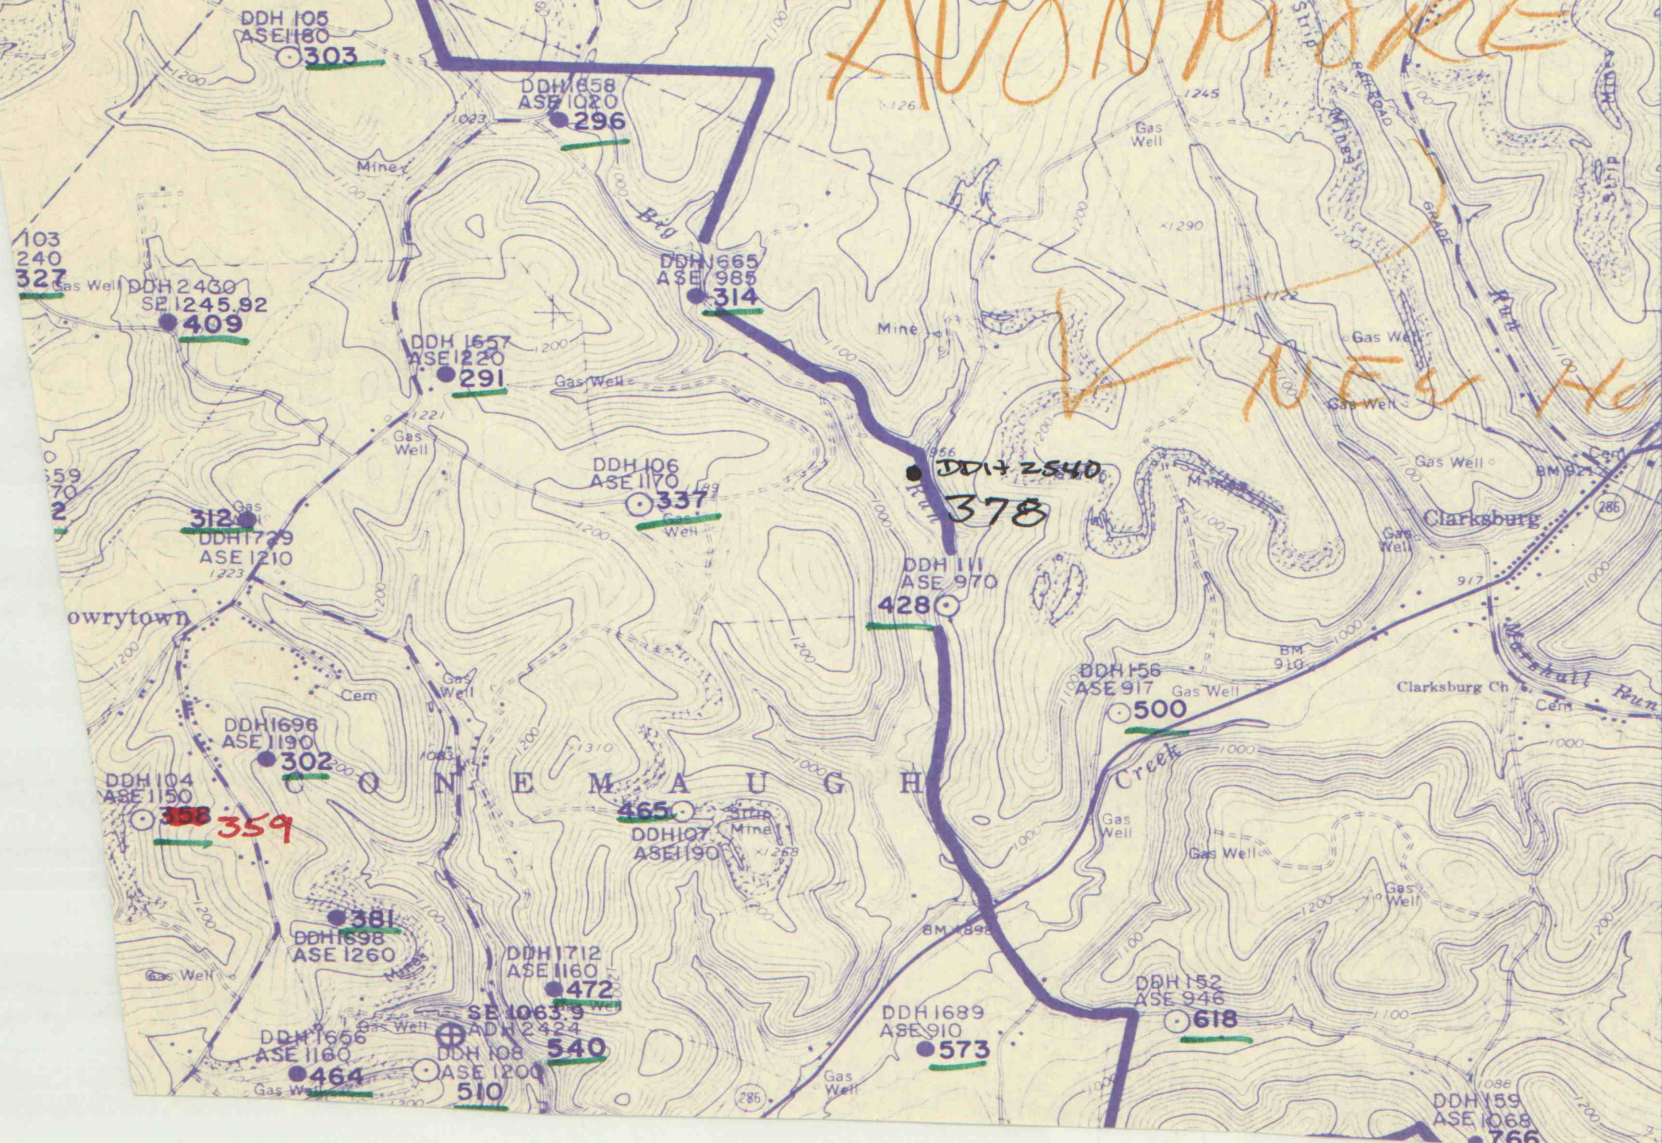

B

INAPS#11887