


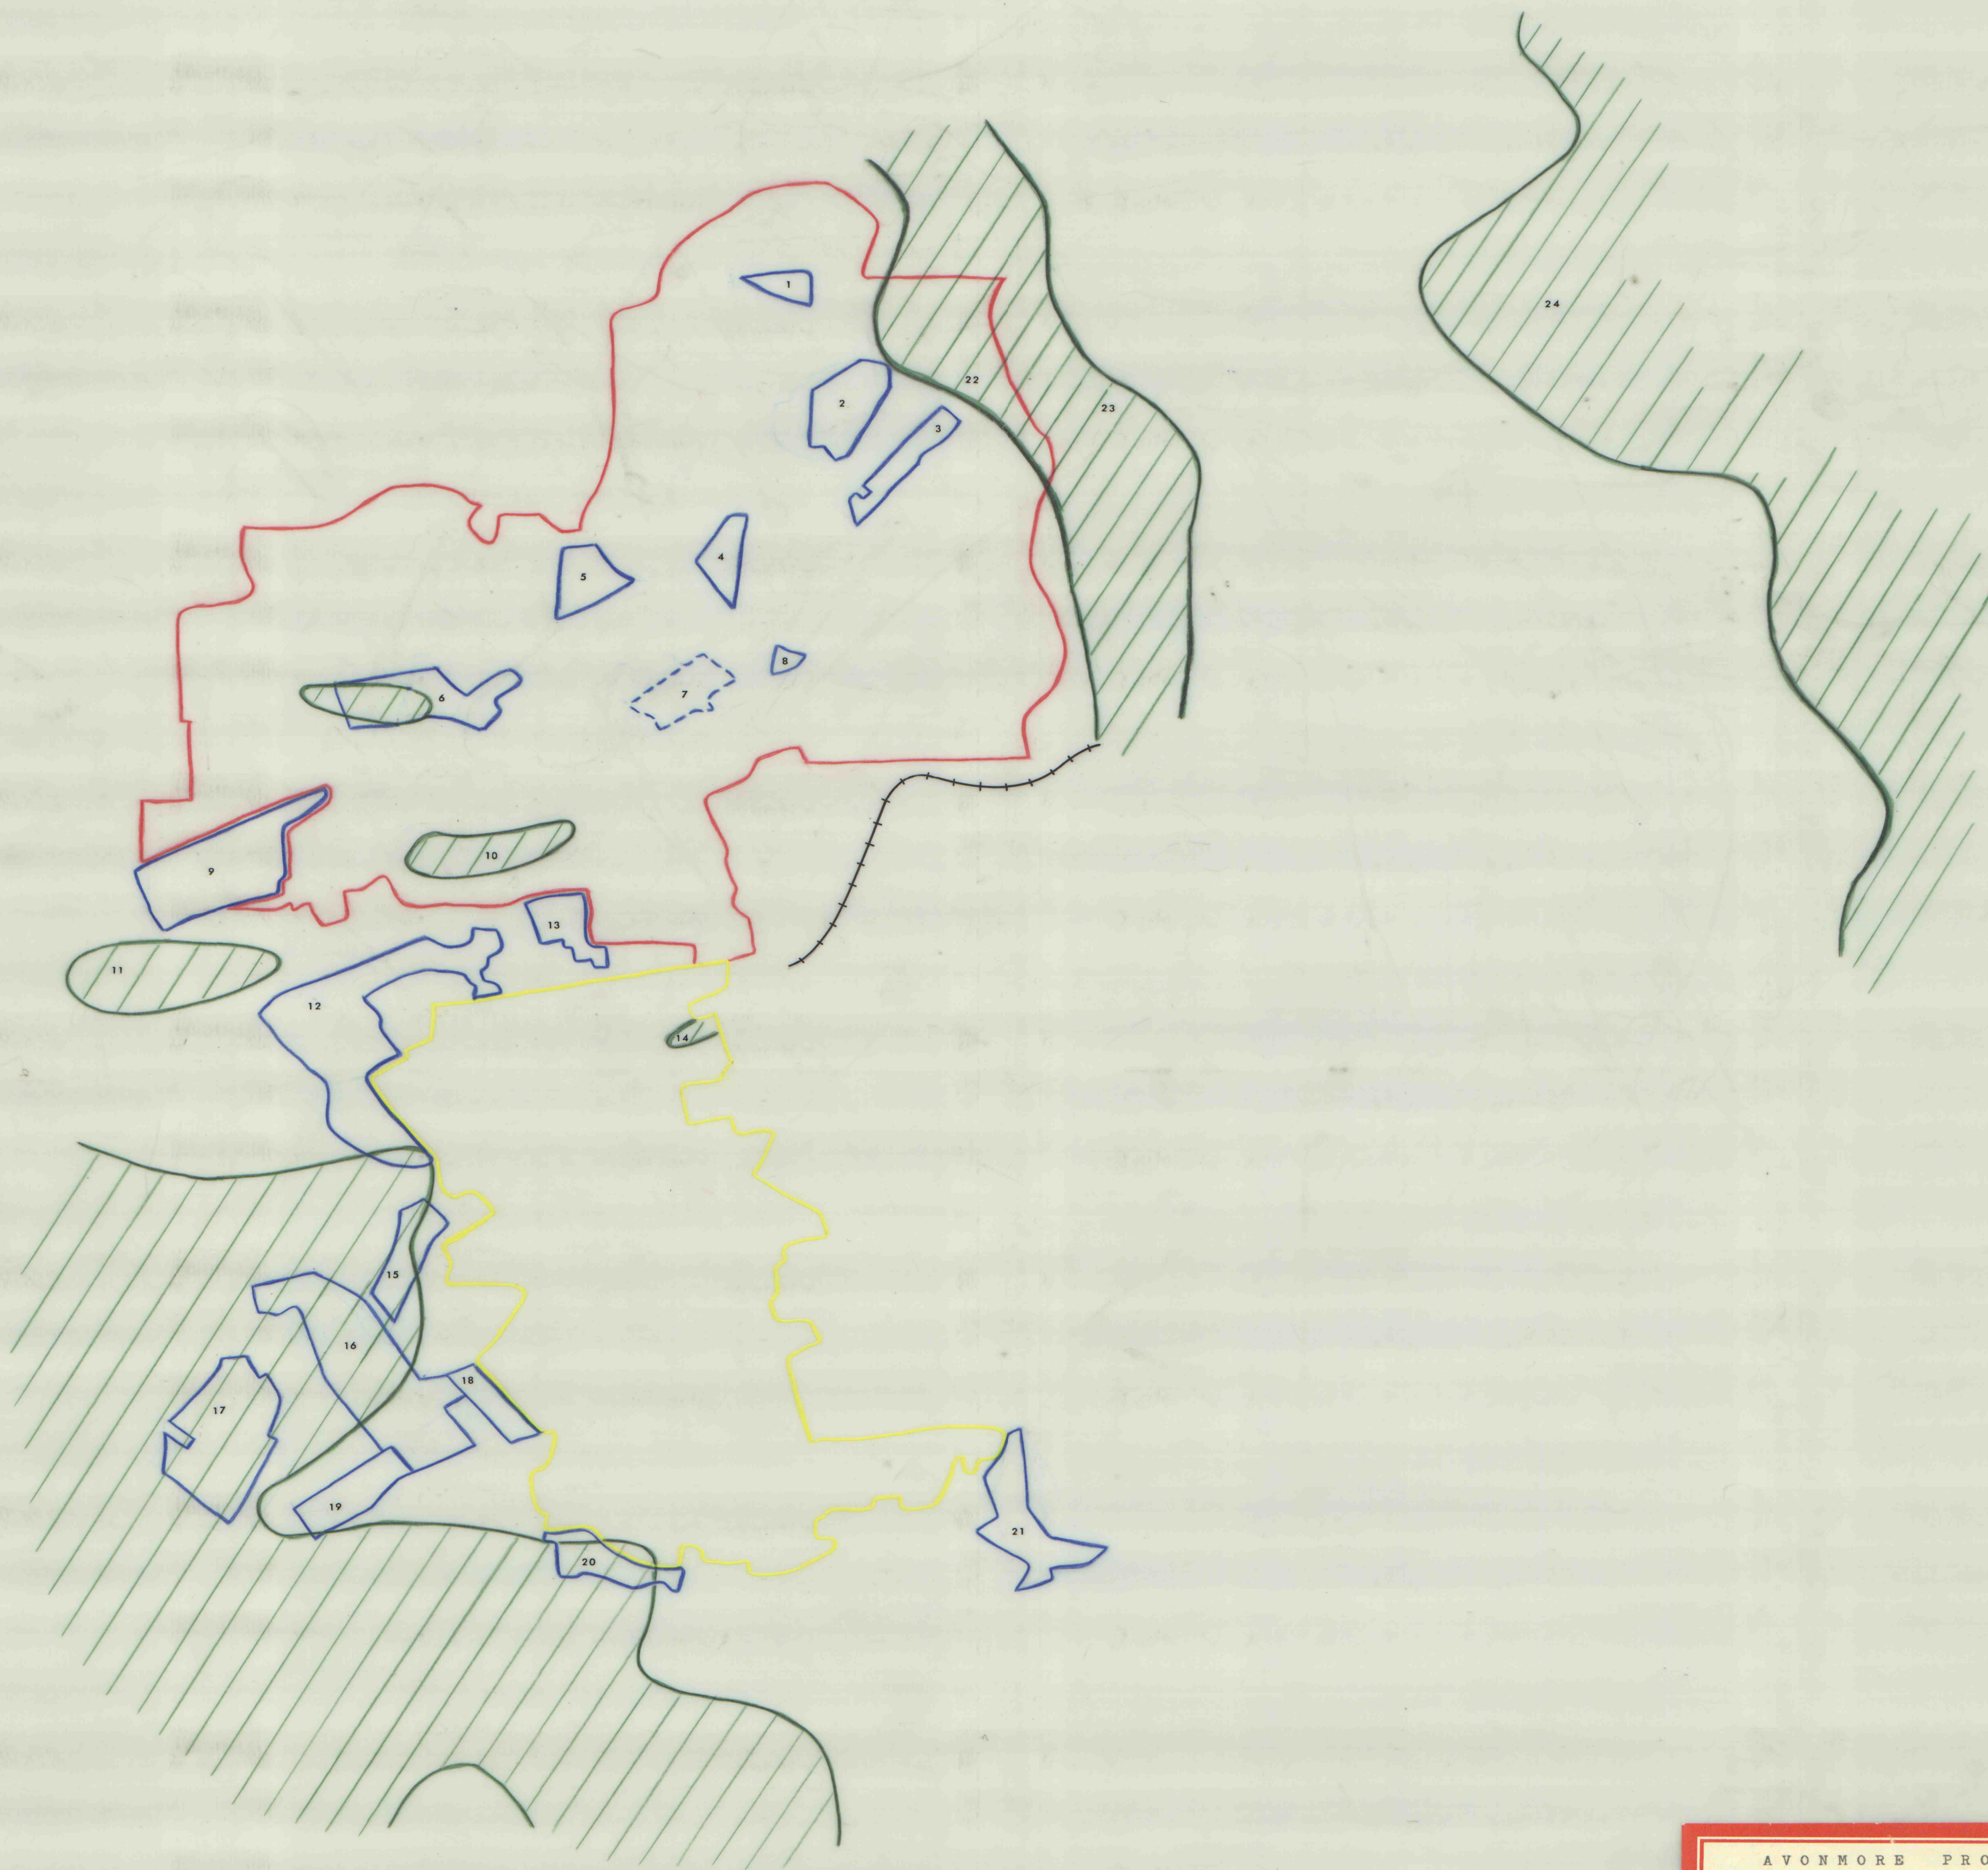

AVONMORE PROPERTY

	Boundary of North Mine
	Boundary of South Mine
	Coal not for Sale or Lease
	Less than 40" coal seam