


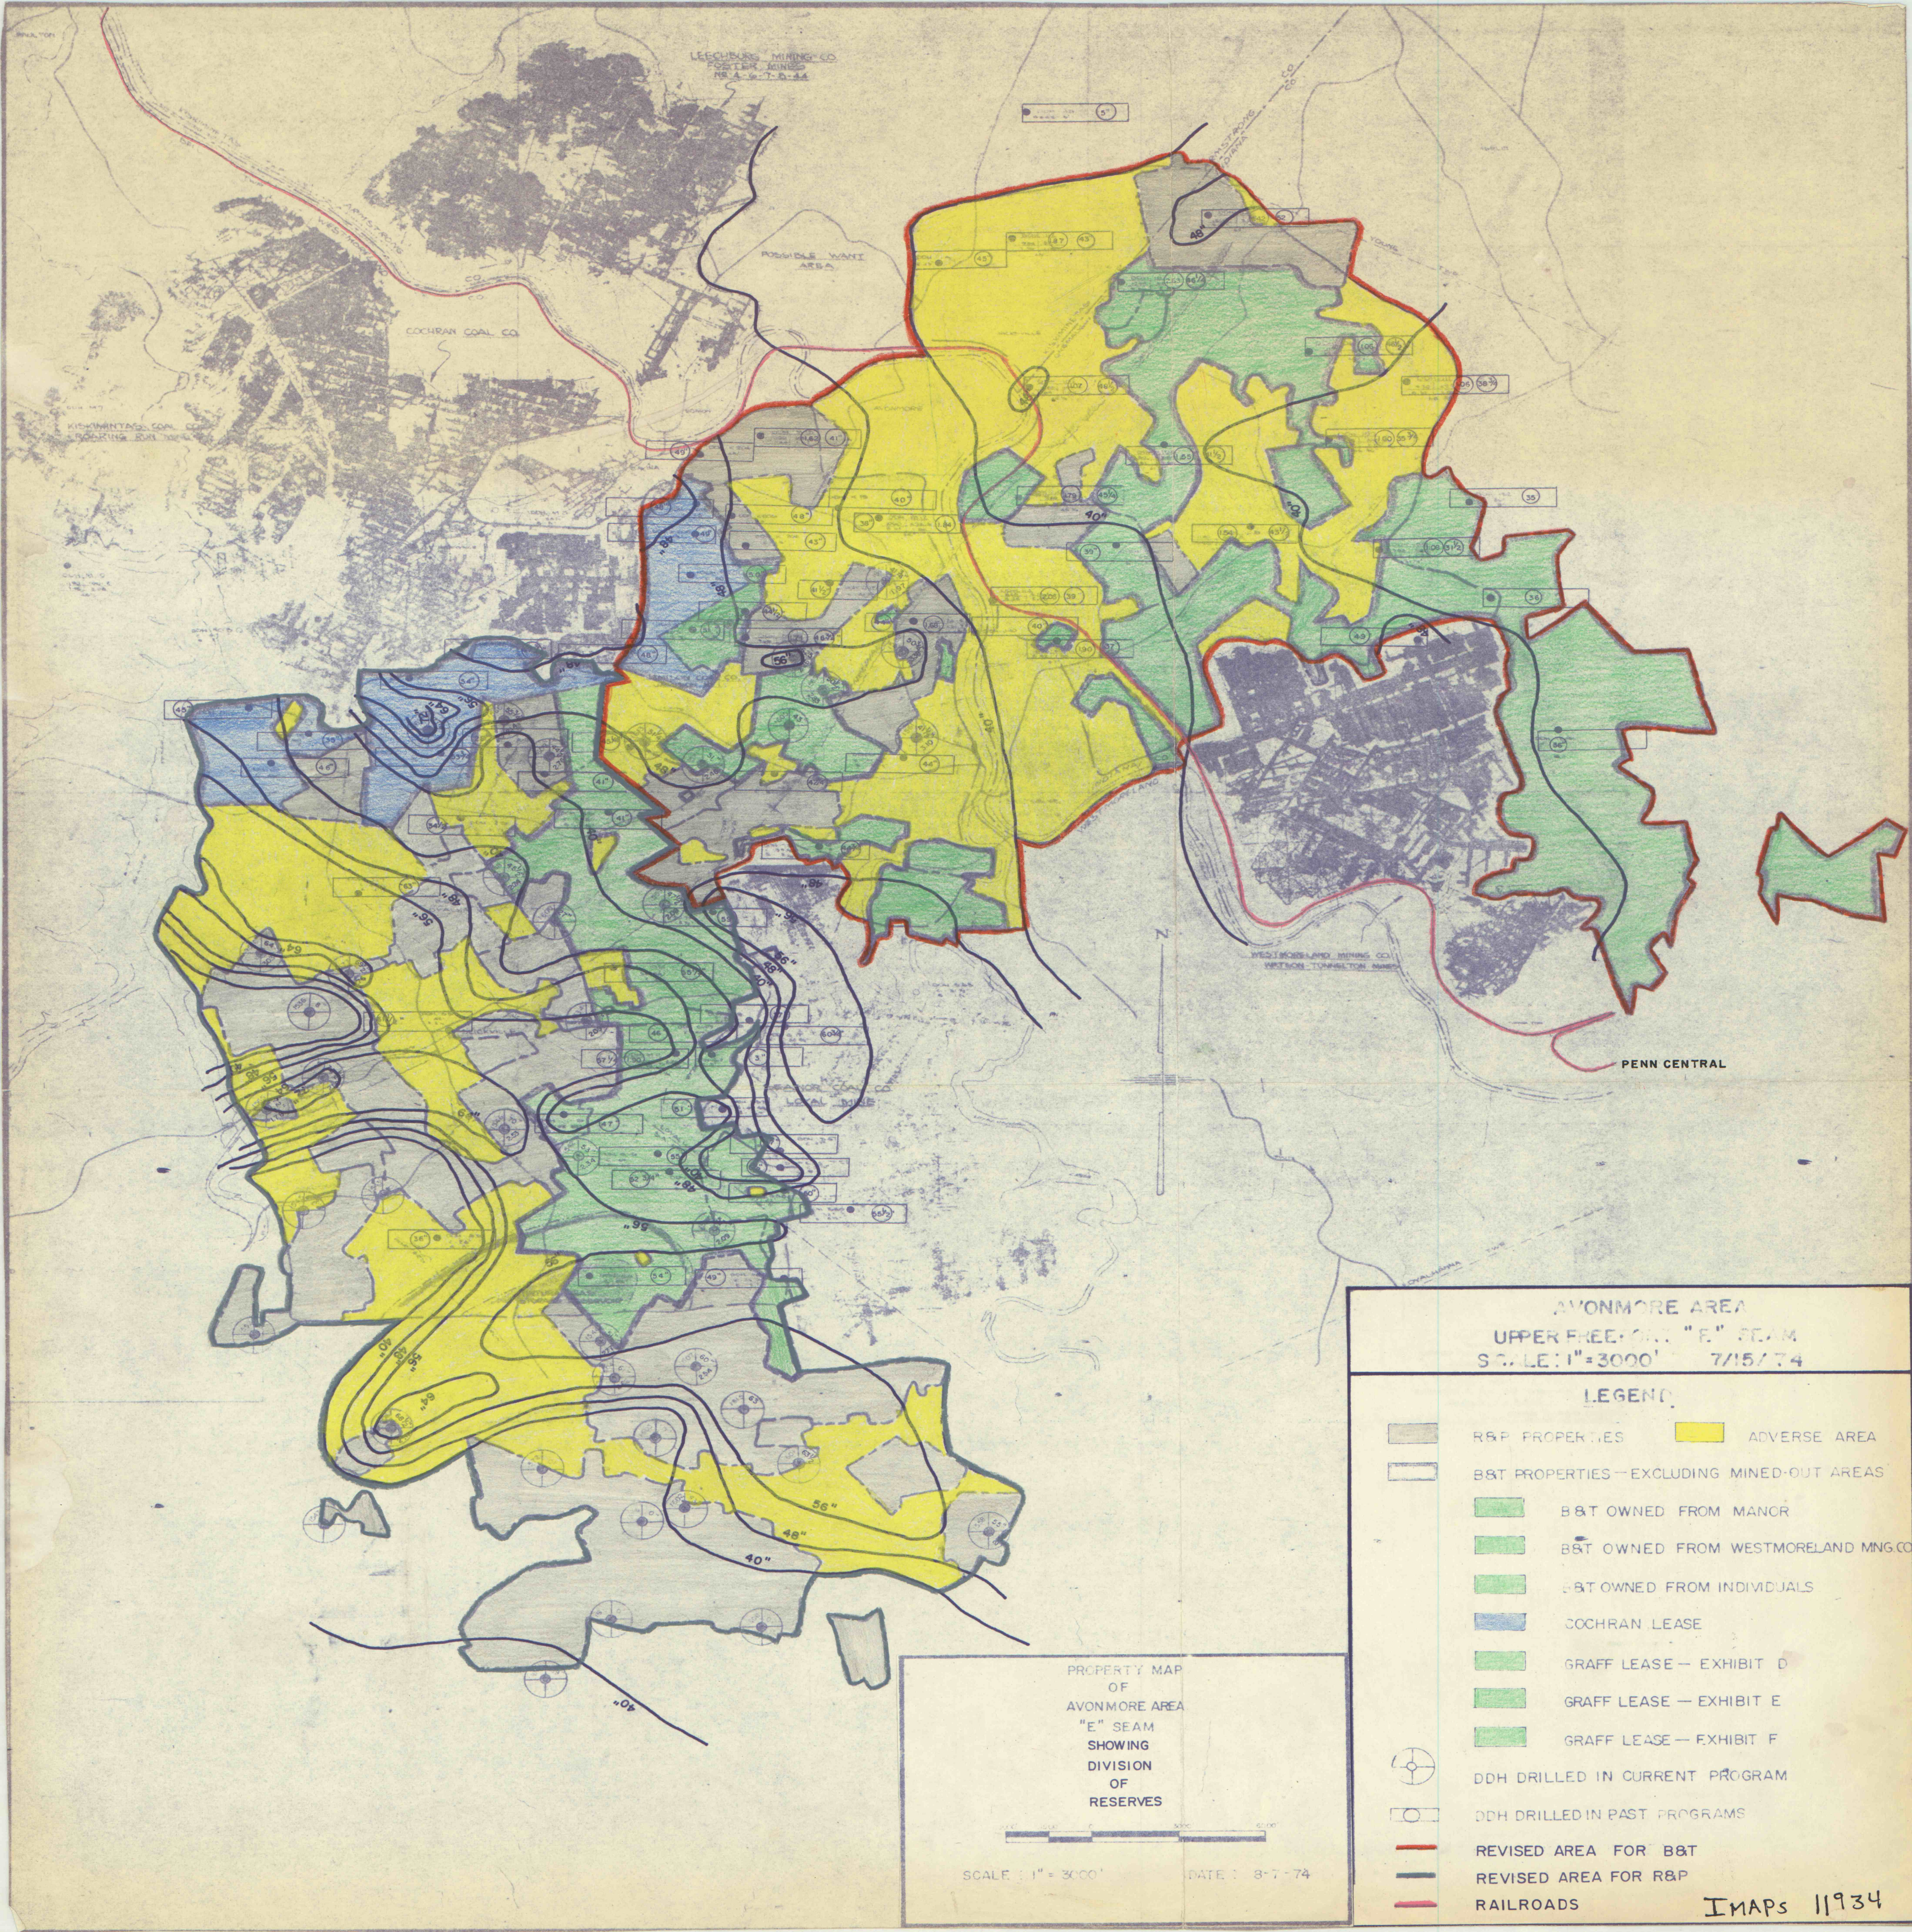

AVONMORE AREA
UPPER FREE-OUT "E" SEAM
SCALE: 1"=3000' 7/15/74

LEGEND

	R&P PROPERTIES		ADVERSE AREA
	B&T PROPERTIES—EXCLUDING MINED-OUT AREAS		B&T OWNED FROM MANOR
	B&T OWNED FROM WESTMORELAND MNG. CO.		B&T OWNED FROM INDIVIDUALS
	COCHRAN LEASE		GRAFF LEASE—EXHIBIT D
	GRAFF LEASE—EXHIBIT E		GRAFF LEASE—EXHIBIT F
	DDH DRILLED IN CURRENT PROGRAM		
	DDH DRILLED IN PAST PROGRAMS		
	REVISED AREA FOR B&T		
	REVISED AREA FOR R&P		
	RAILROADS		

PROPERTY MAP
OF
AVONMORE AREA
"E" SEAM
SHOWING
DIVISION
OF
RESERVES

SCALE: 1"=3000' DATE: 8-7-74