


AVONMORE FIELD

DRILL HOLE LOCATION MAP

MAP I

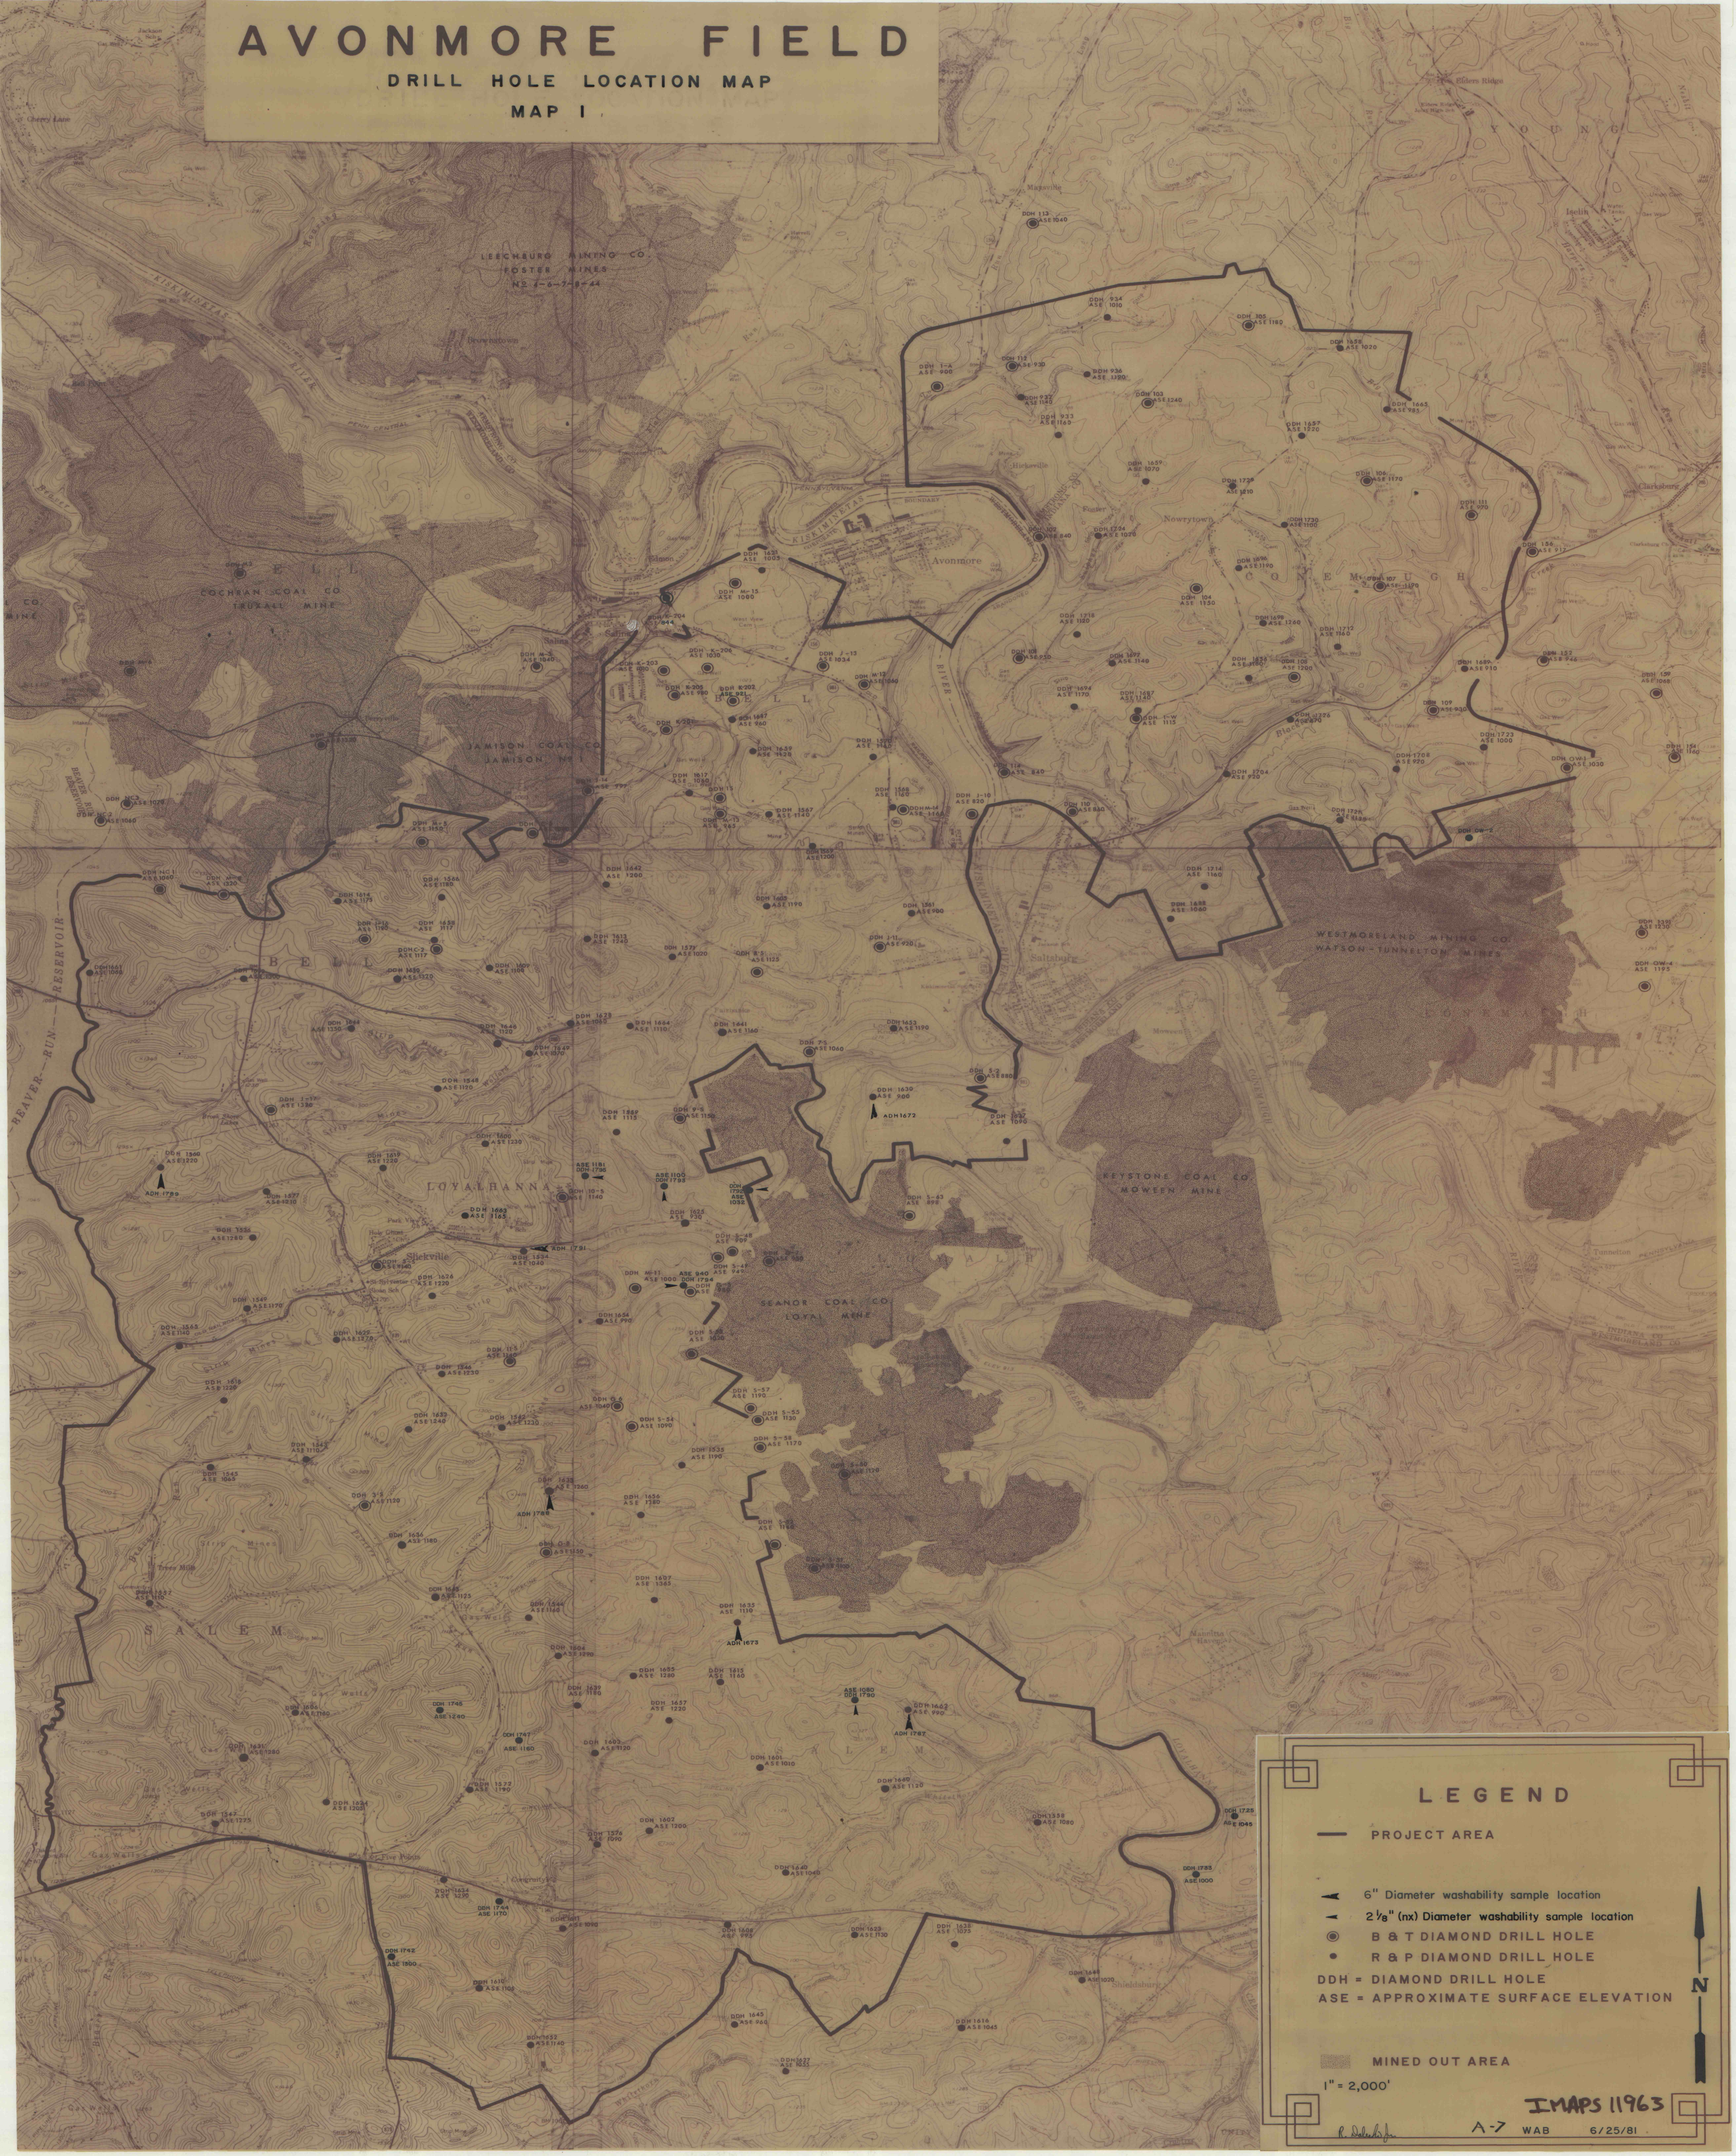

LEGEND

— PROJECT AREA

- ▲ 6" Diameter washability sample location
- 2 1/8" (nx) Diameter washability sample location
- B & T DIAMOND DRILL HOLE
- R & P DIAMOND DRILL HOLE
- DDH = DIAMOND DRILL HOLE
- ASE = APPROXIMATE SURFACE ELEVATION

MINED OUT AREA

1" = 2,000'

IMAPS 11963

A-7 WAB 6/25/81