


Rochester & Pittsburgh Coal Company

AVONMORE

UPPER FREEPORT (E) SEAM

STRUCTURAL CONTOUR MAP

MAP 2

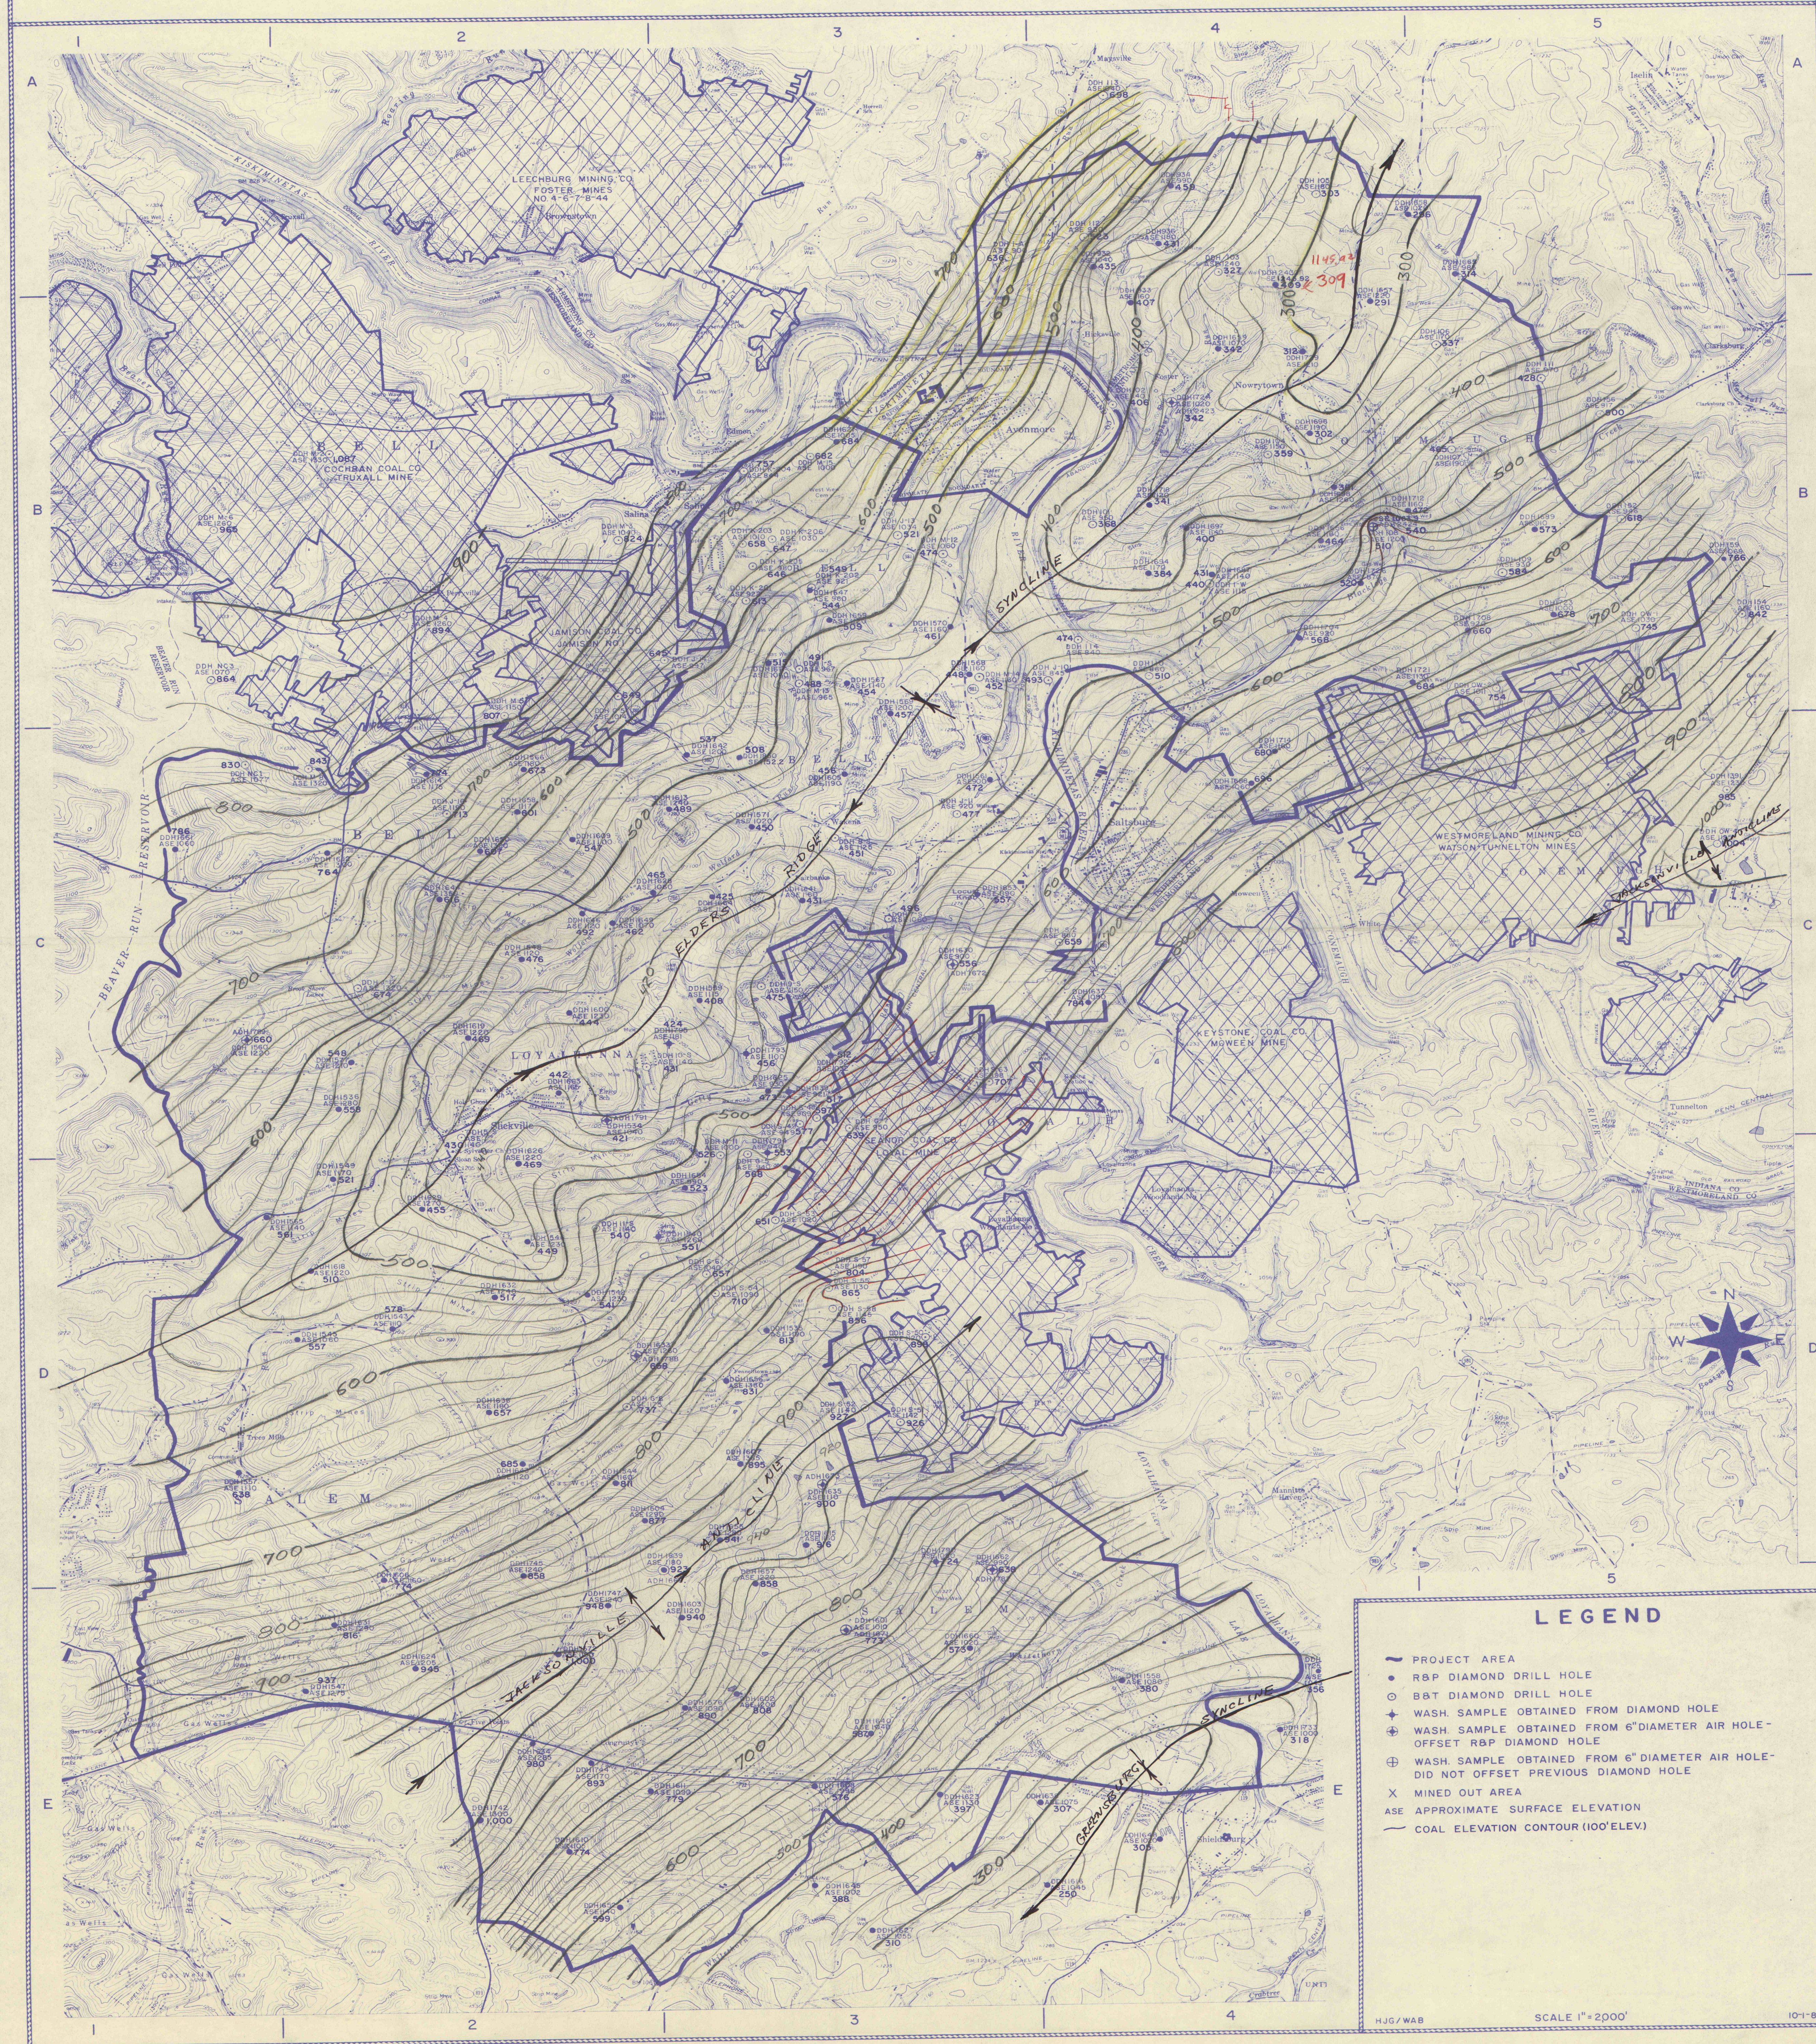

LEGEND

- PROJECT AREA
- R&P DIAMOND DRILL HOLE
- ⊙ B&T DIAMOND DRILL HOLE
- + WASH. SAMPLE OBTAINED FROM DIAMOND HOLE
- ⊕ WASH. SAMPLE OBTAINED FROM 6" DIAMETER AIR HOLE - OFFSET R&P DIAMOND HOLE
- ⊕ WASH. SAMPLE OBTAINED FROM 6" DIAMETER AIR HOLE - DID NOT OFFSET PREVIOUS DIAMOND HOLE
- X MINED OUT AREA
- ASE APPROXIMATE SURFACE ELEVATION
- COAL ELEVATION CONTOUR (100' ELEV.)

HJG/WAB

SCALE 1"=2000'

10-1-82

IMAPS 11965