


SULFUR

B 1245

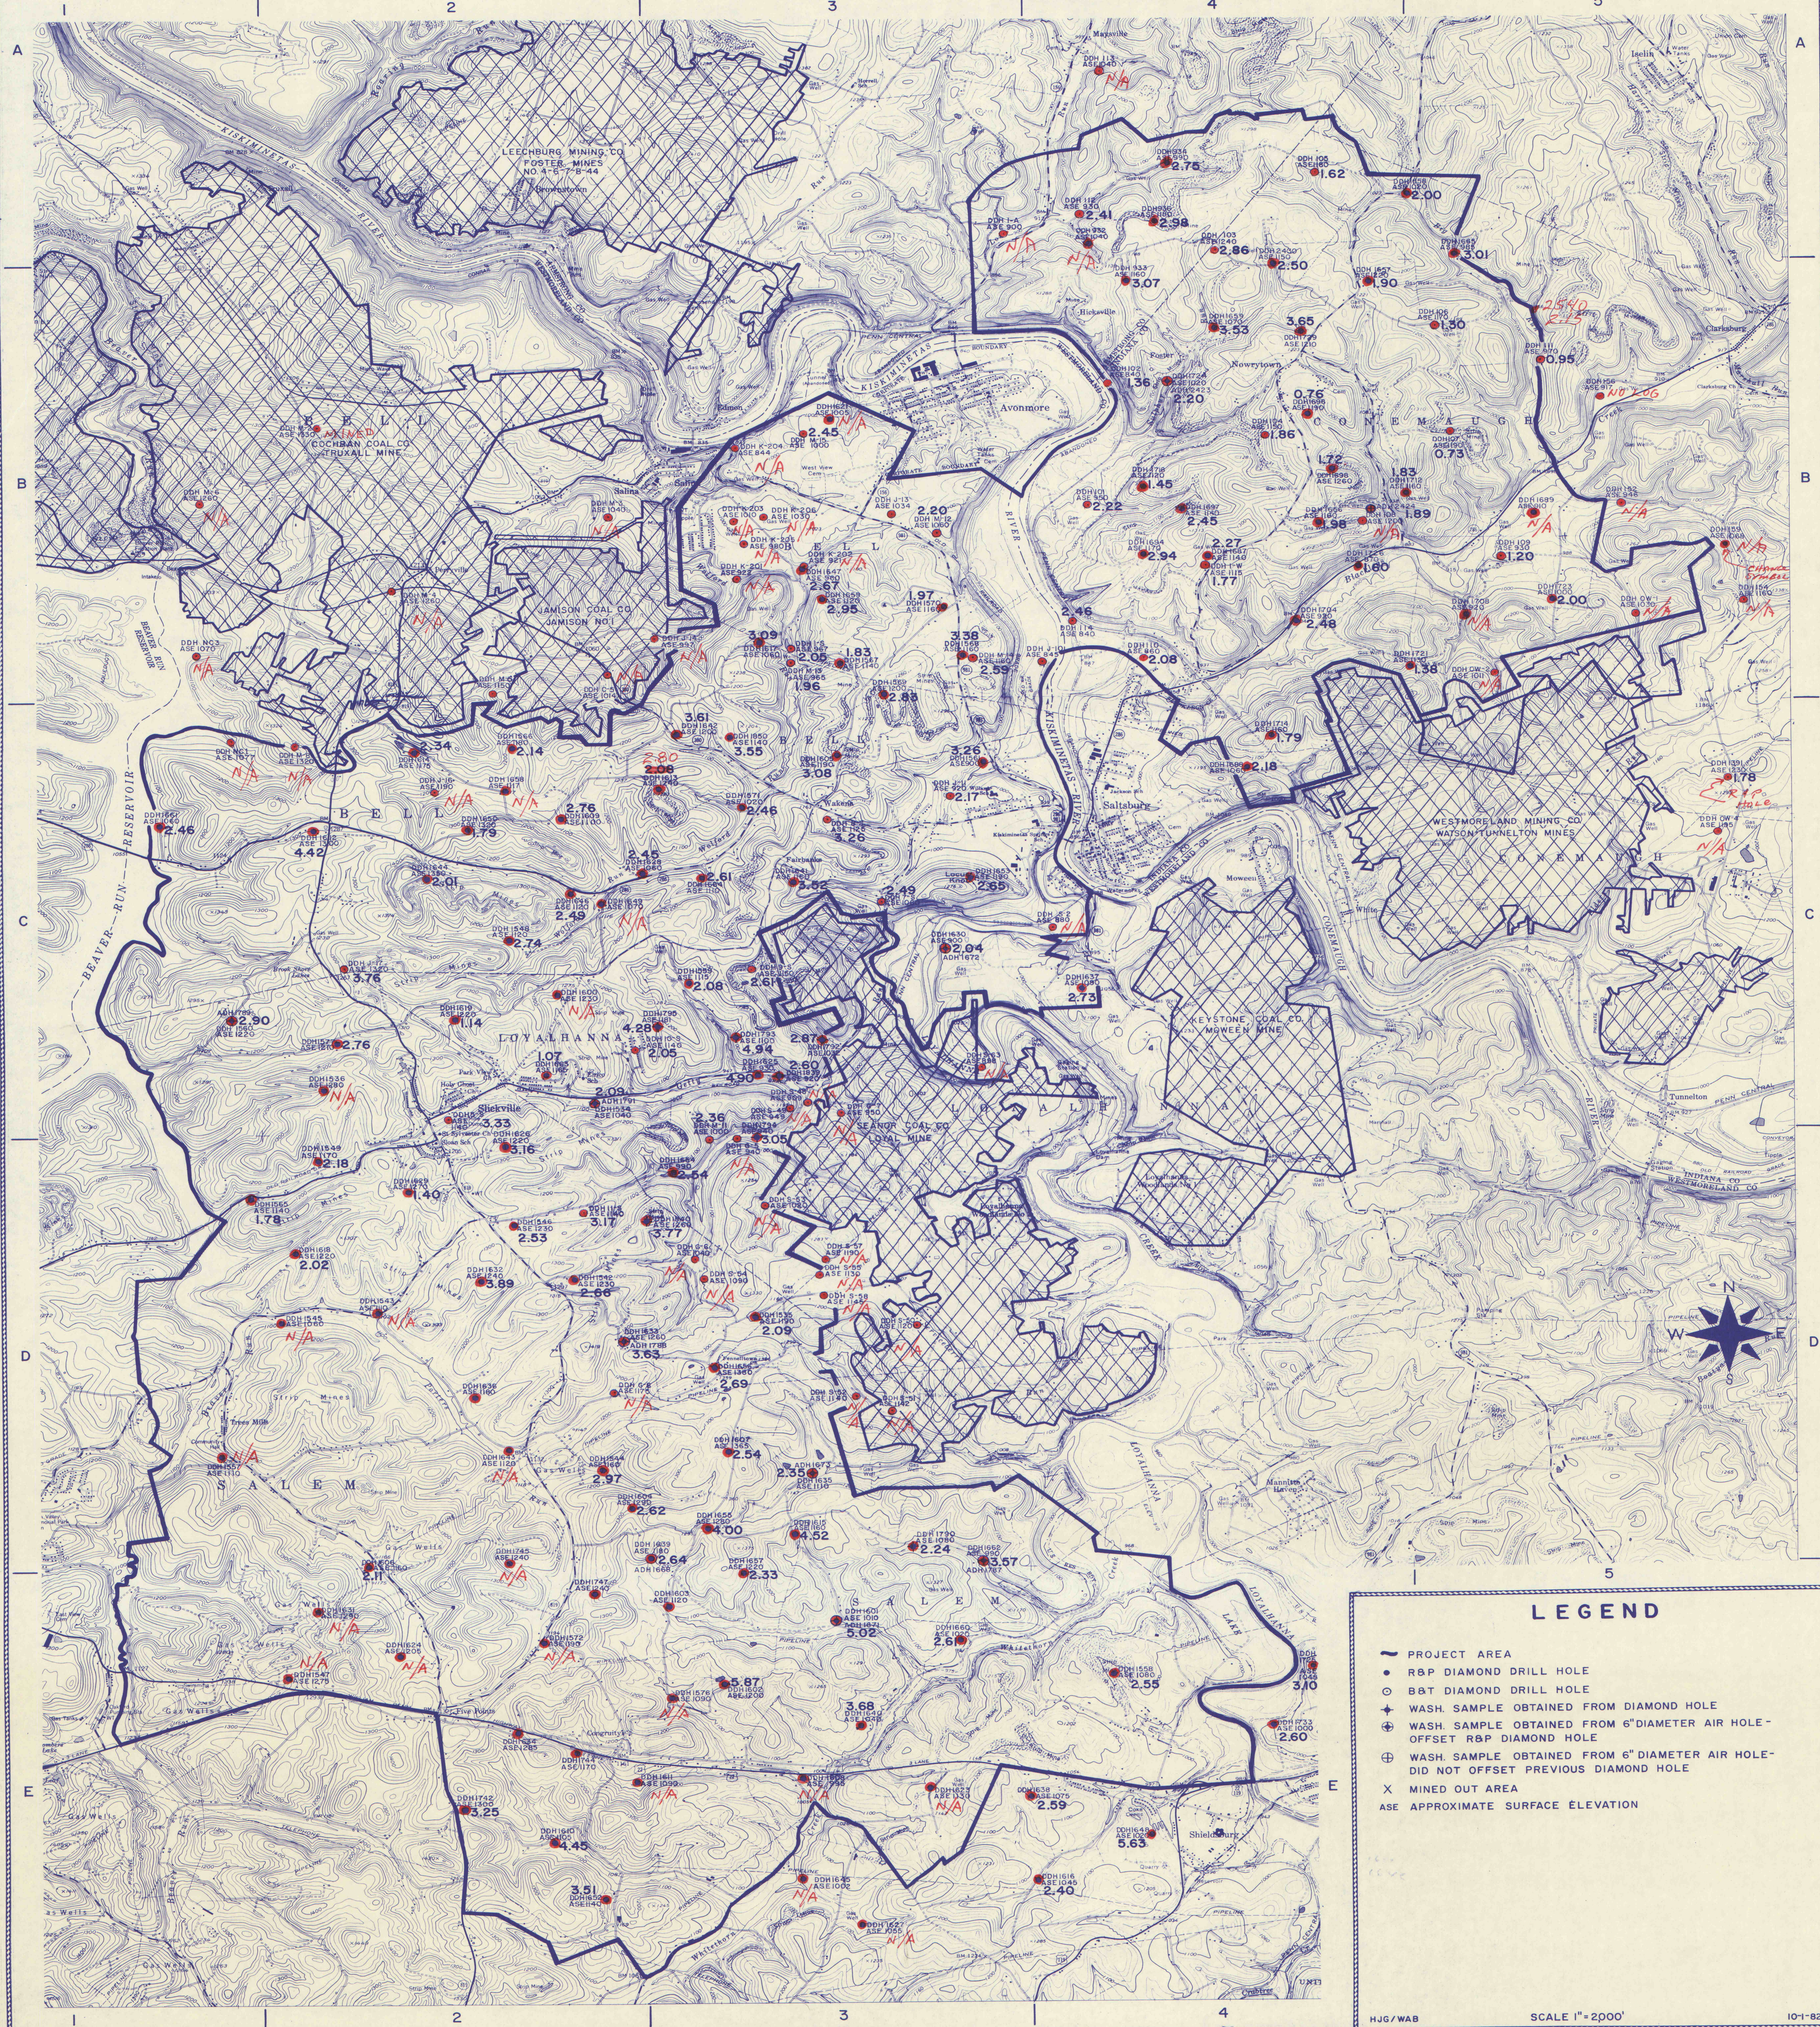

HJG/WAB

SCALE 1" = 2,000'

10-1-

MAPS# 11991