


Rochester & Pittsburgh Coal Company AVONMORE

RAW (R.O.M.) ASH % (MINEABLE SEAM)

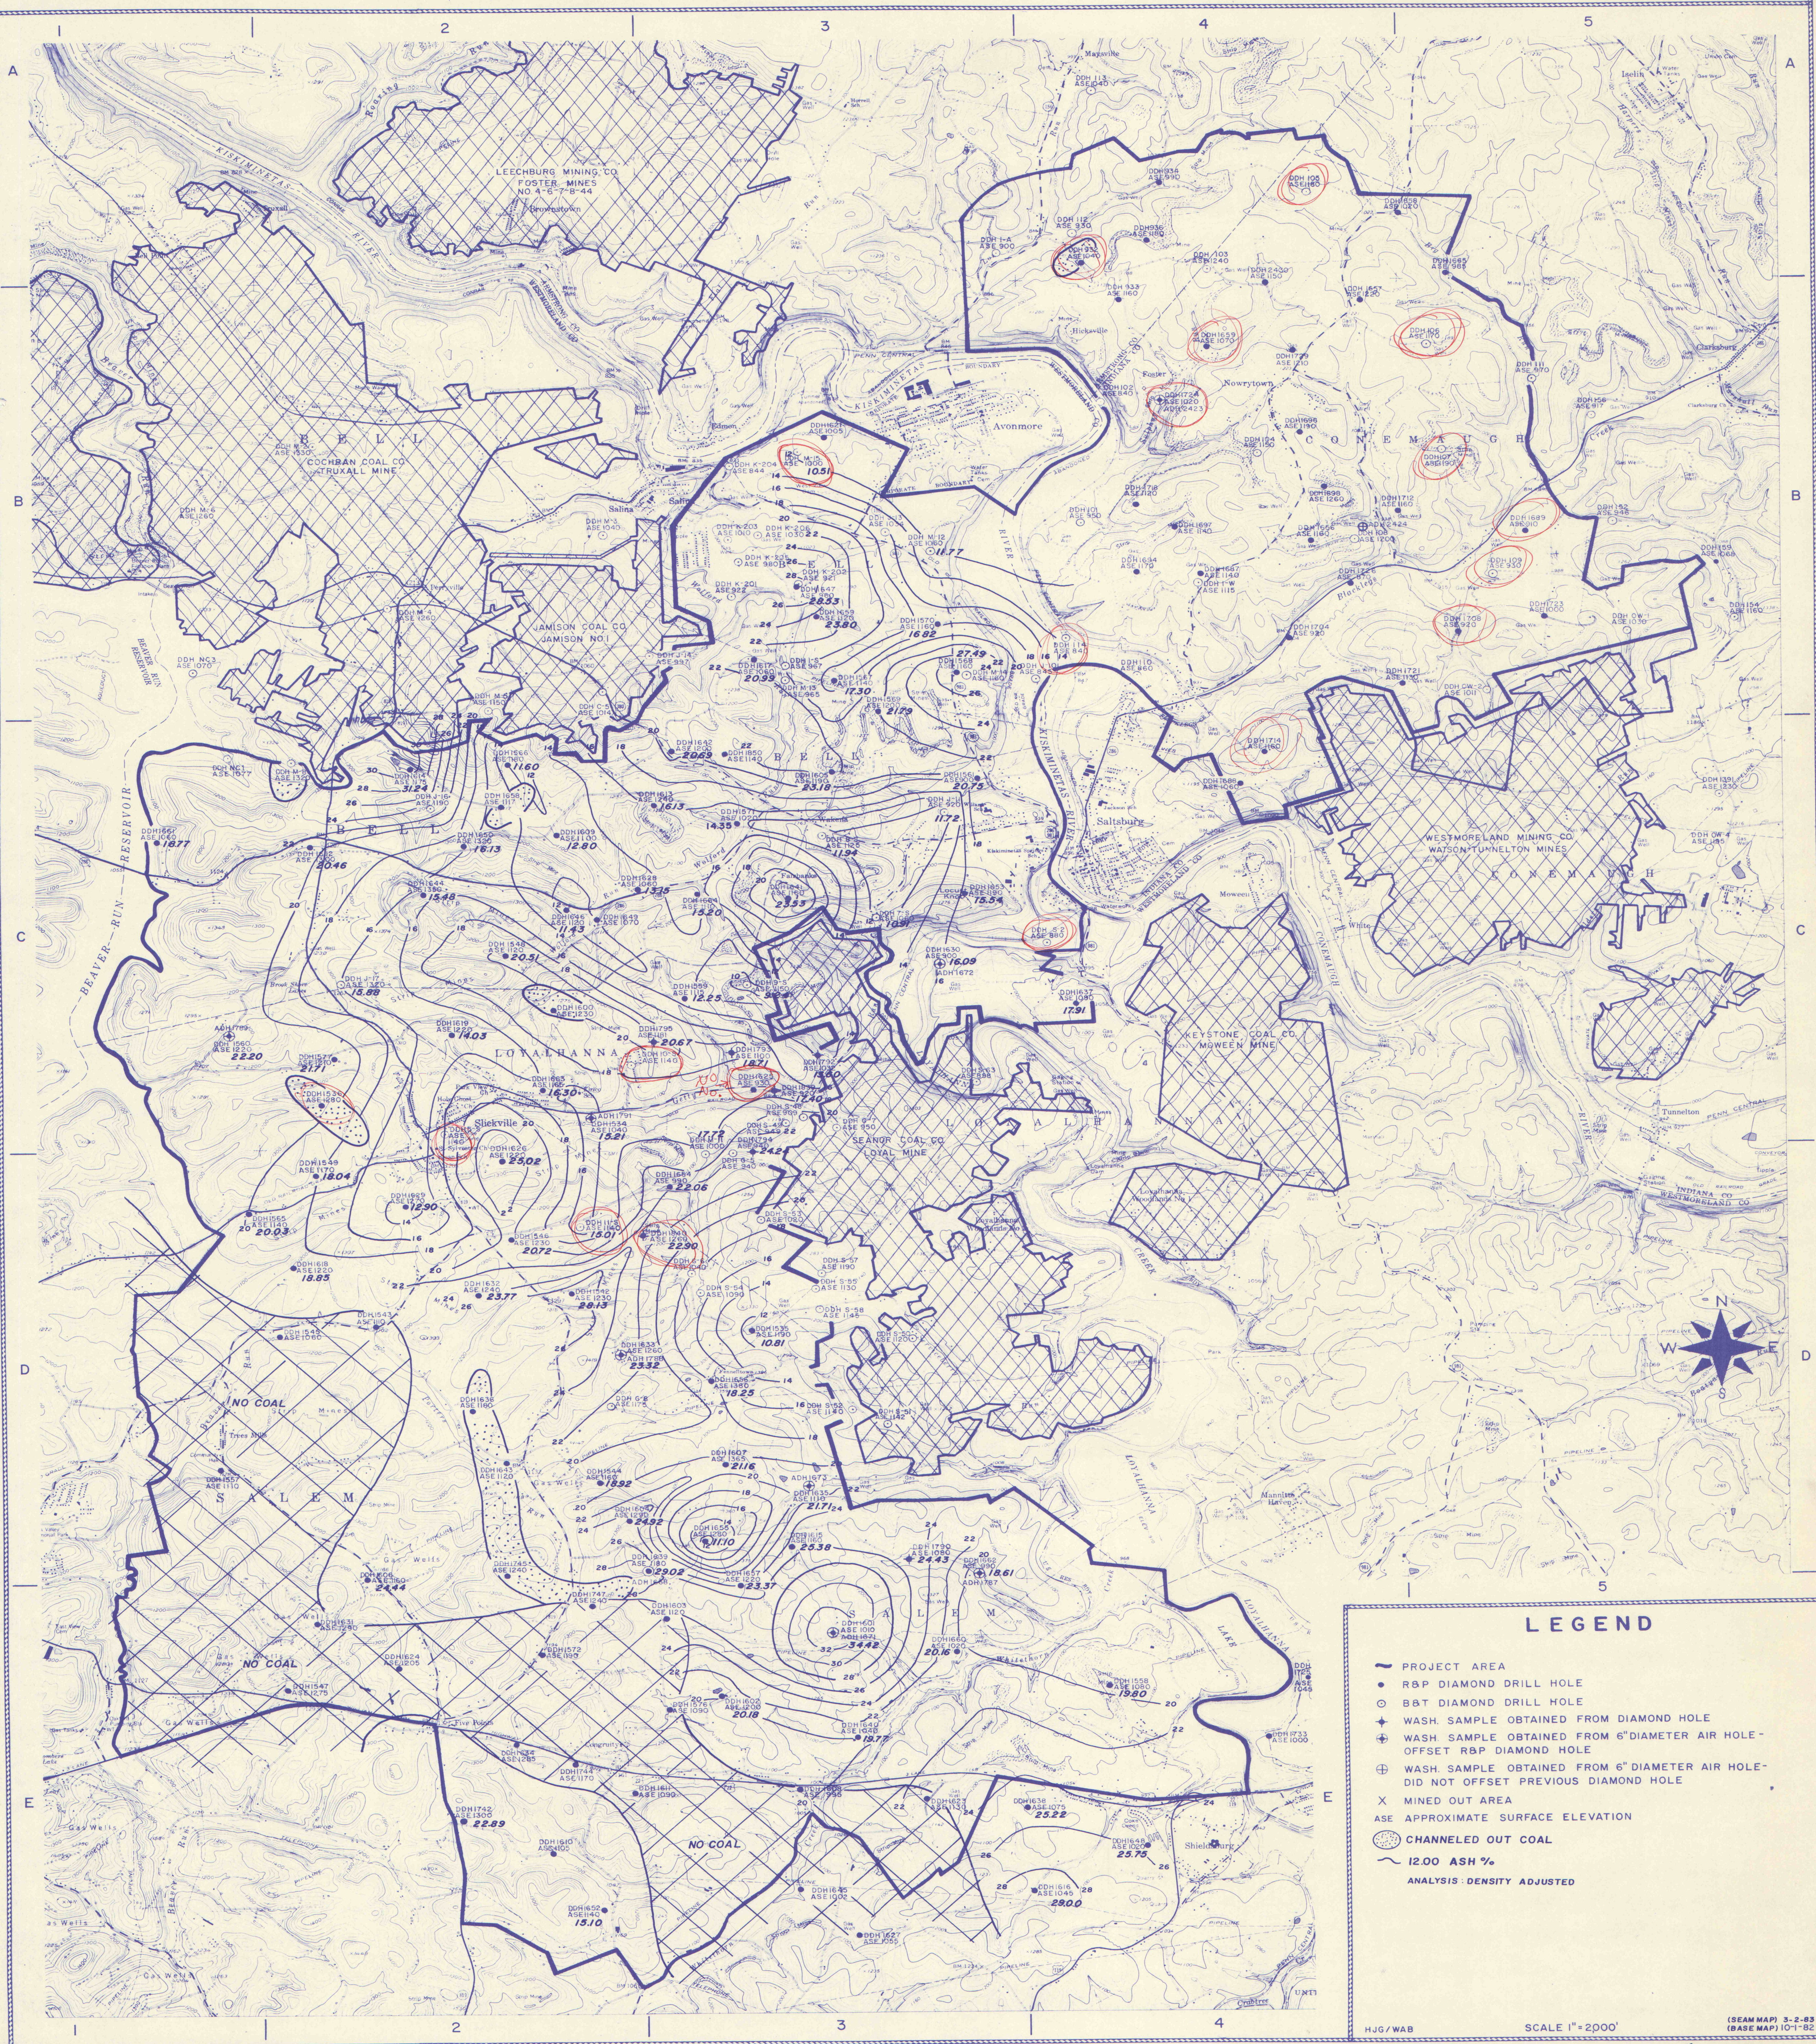

HJG/WAB

SCALE 1"=2000'

(SEAM MAP) 3-2-83
(BASE MAP) 10-1-82

MAPS# 11992