


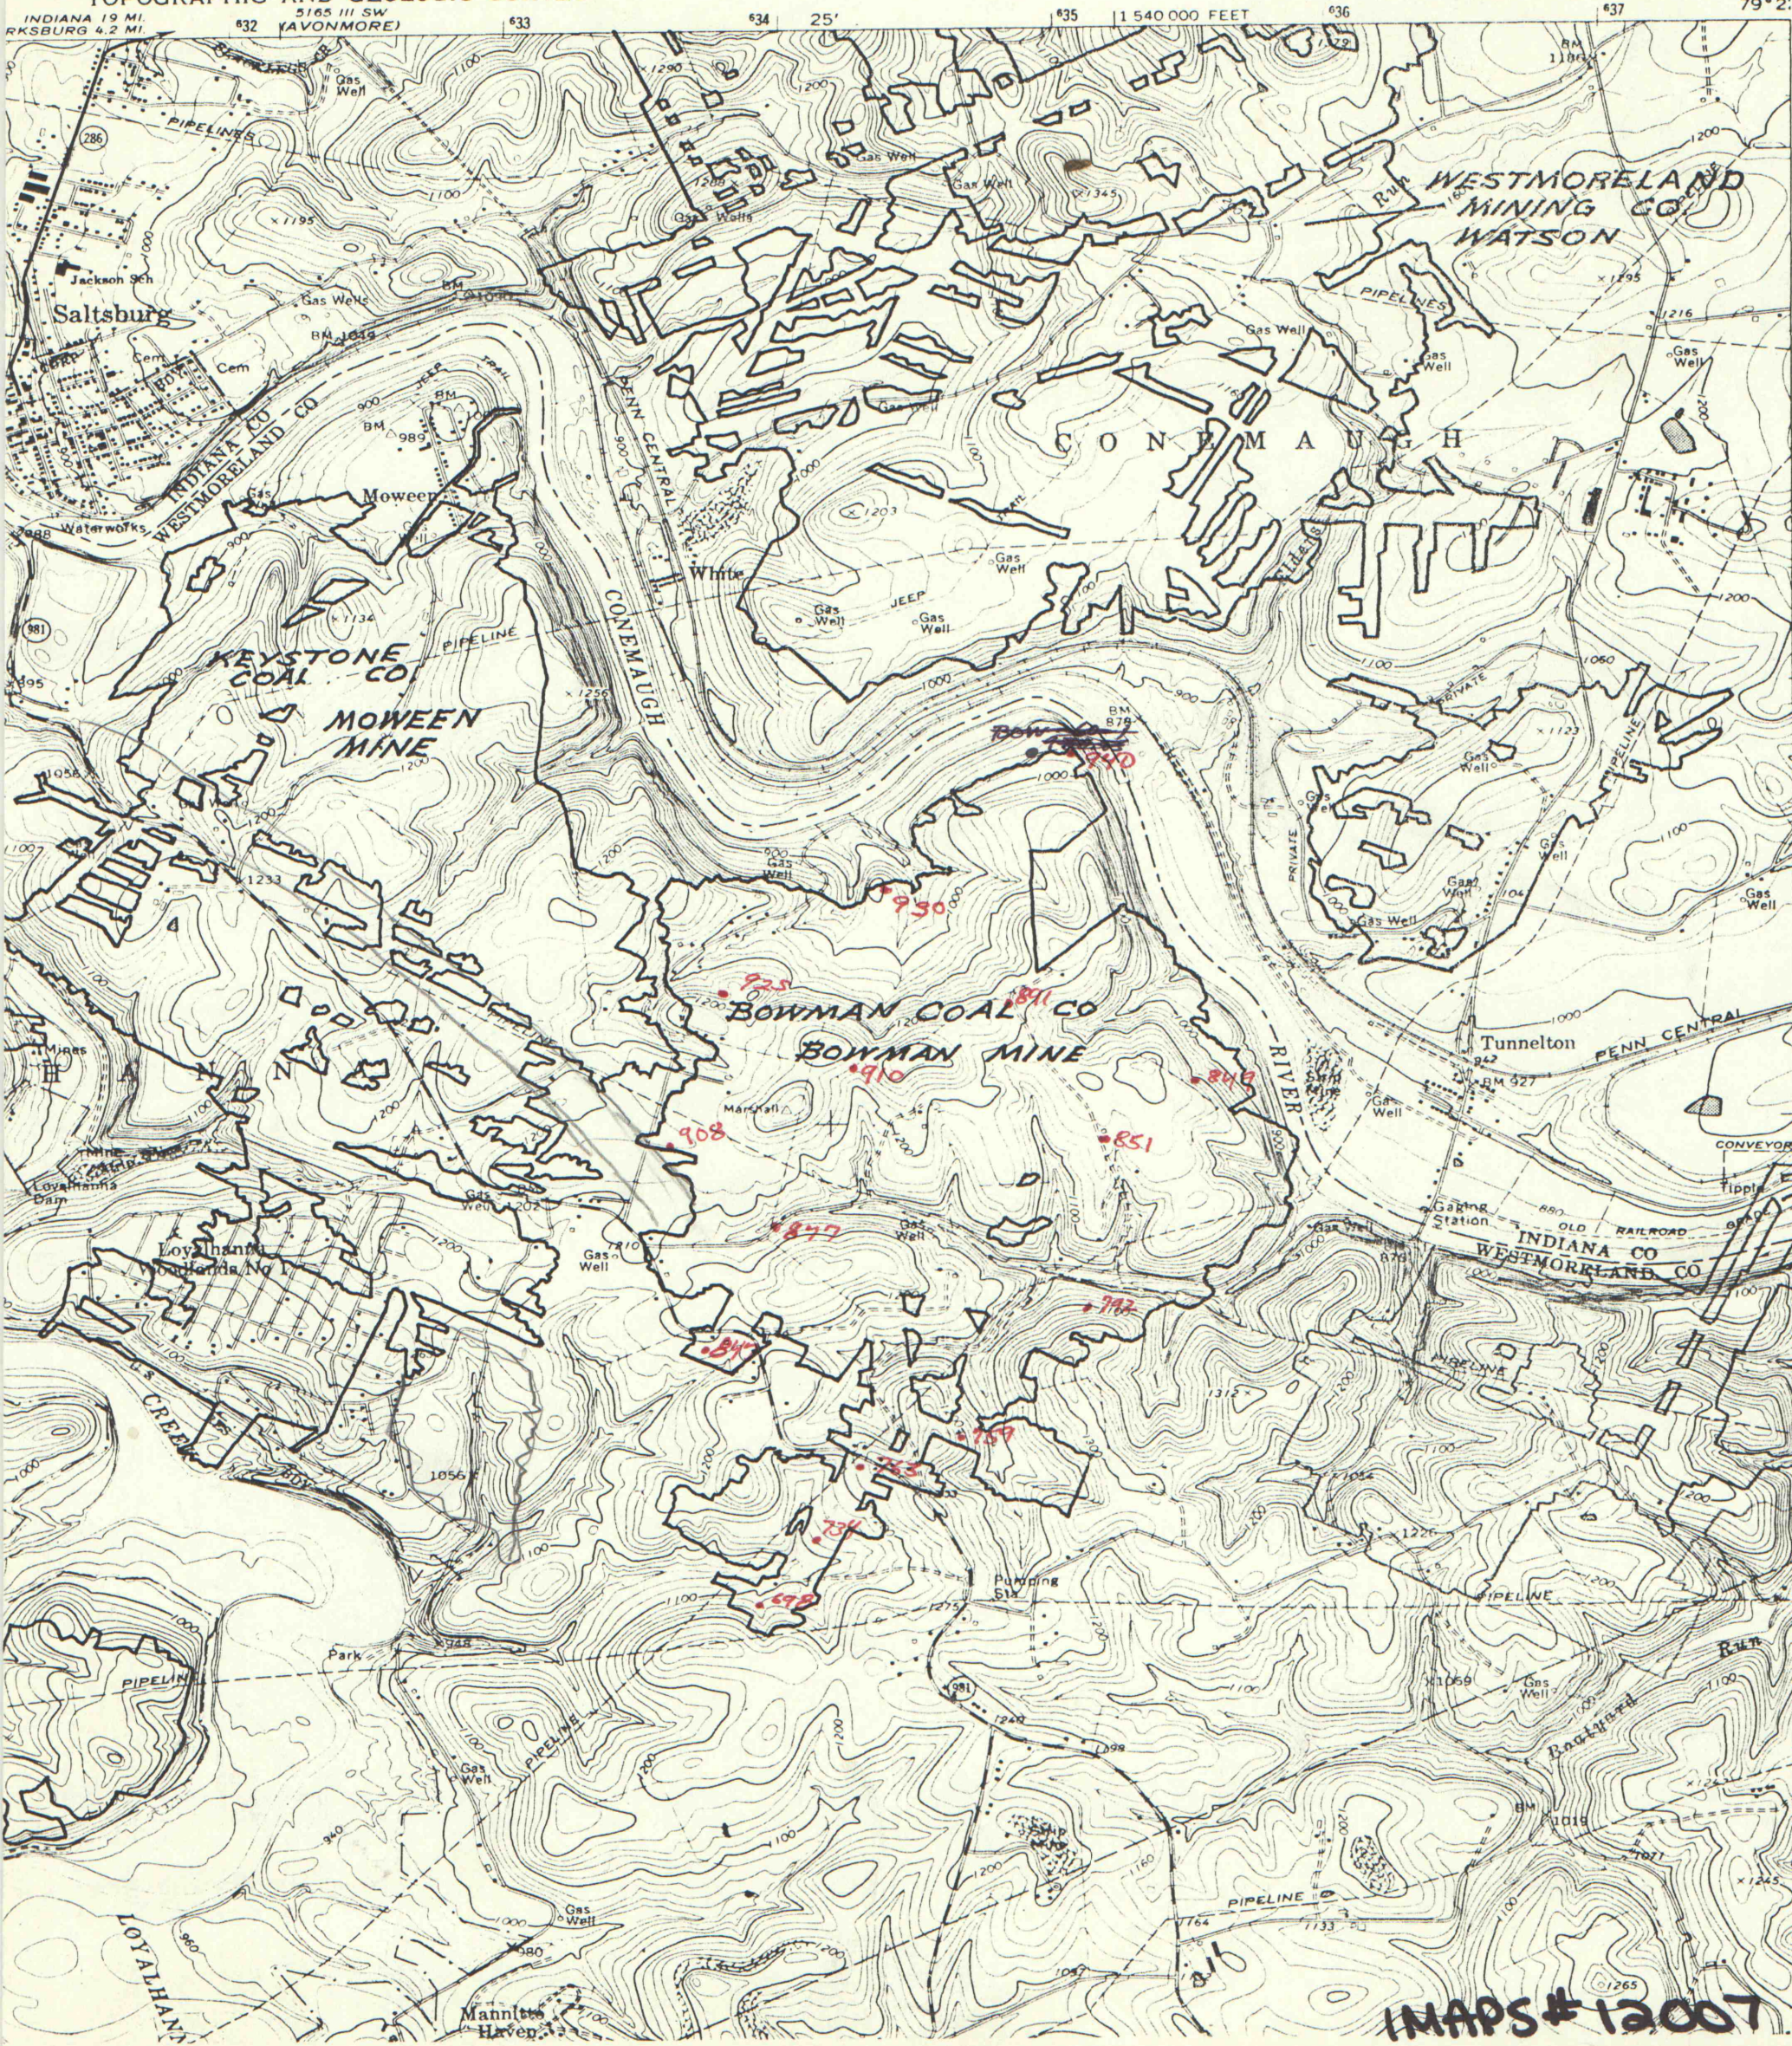

MAPS # 12007