


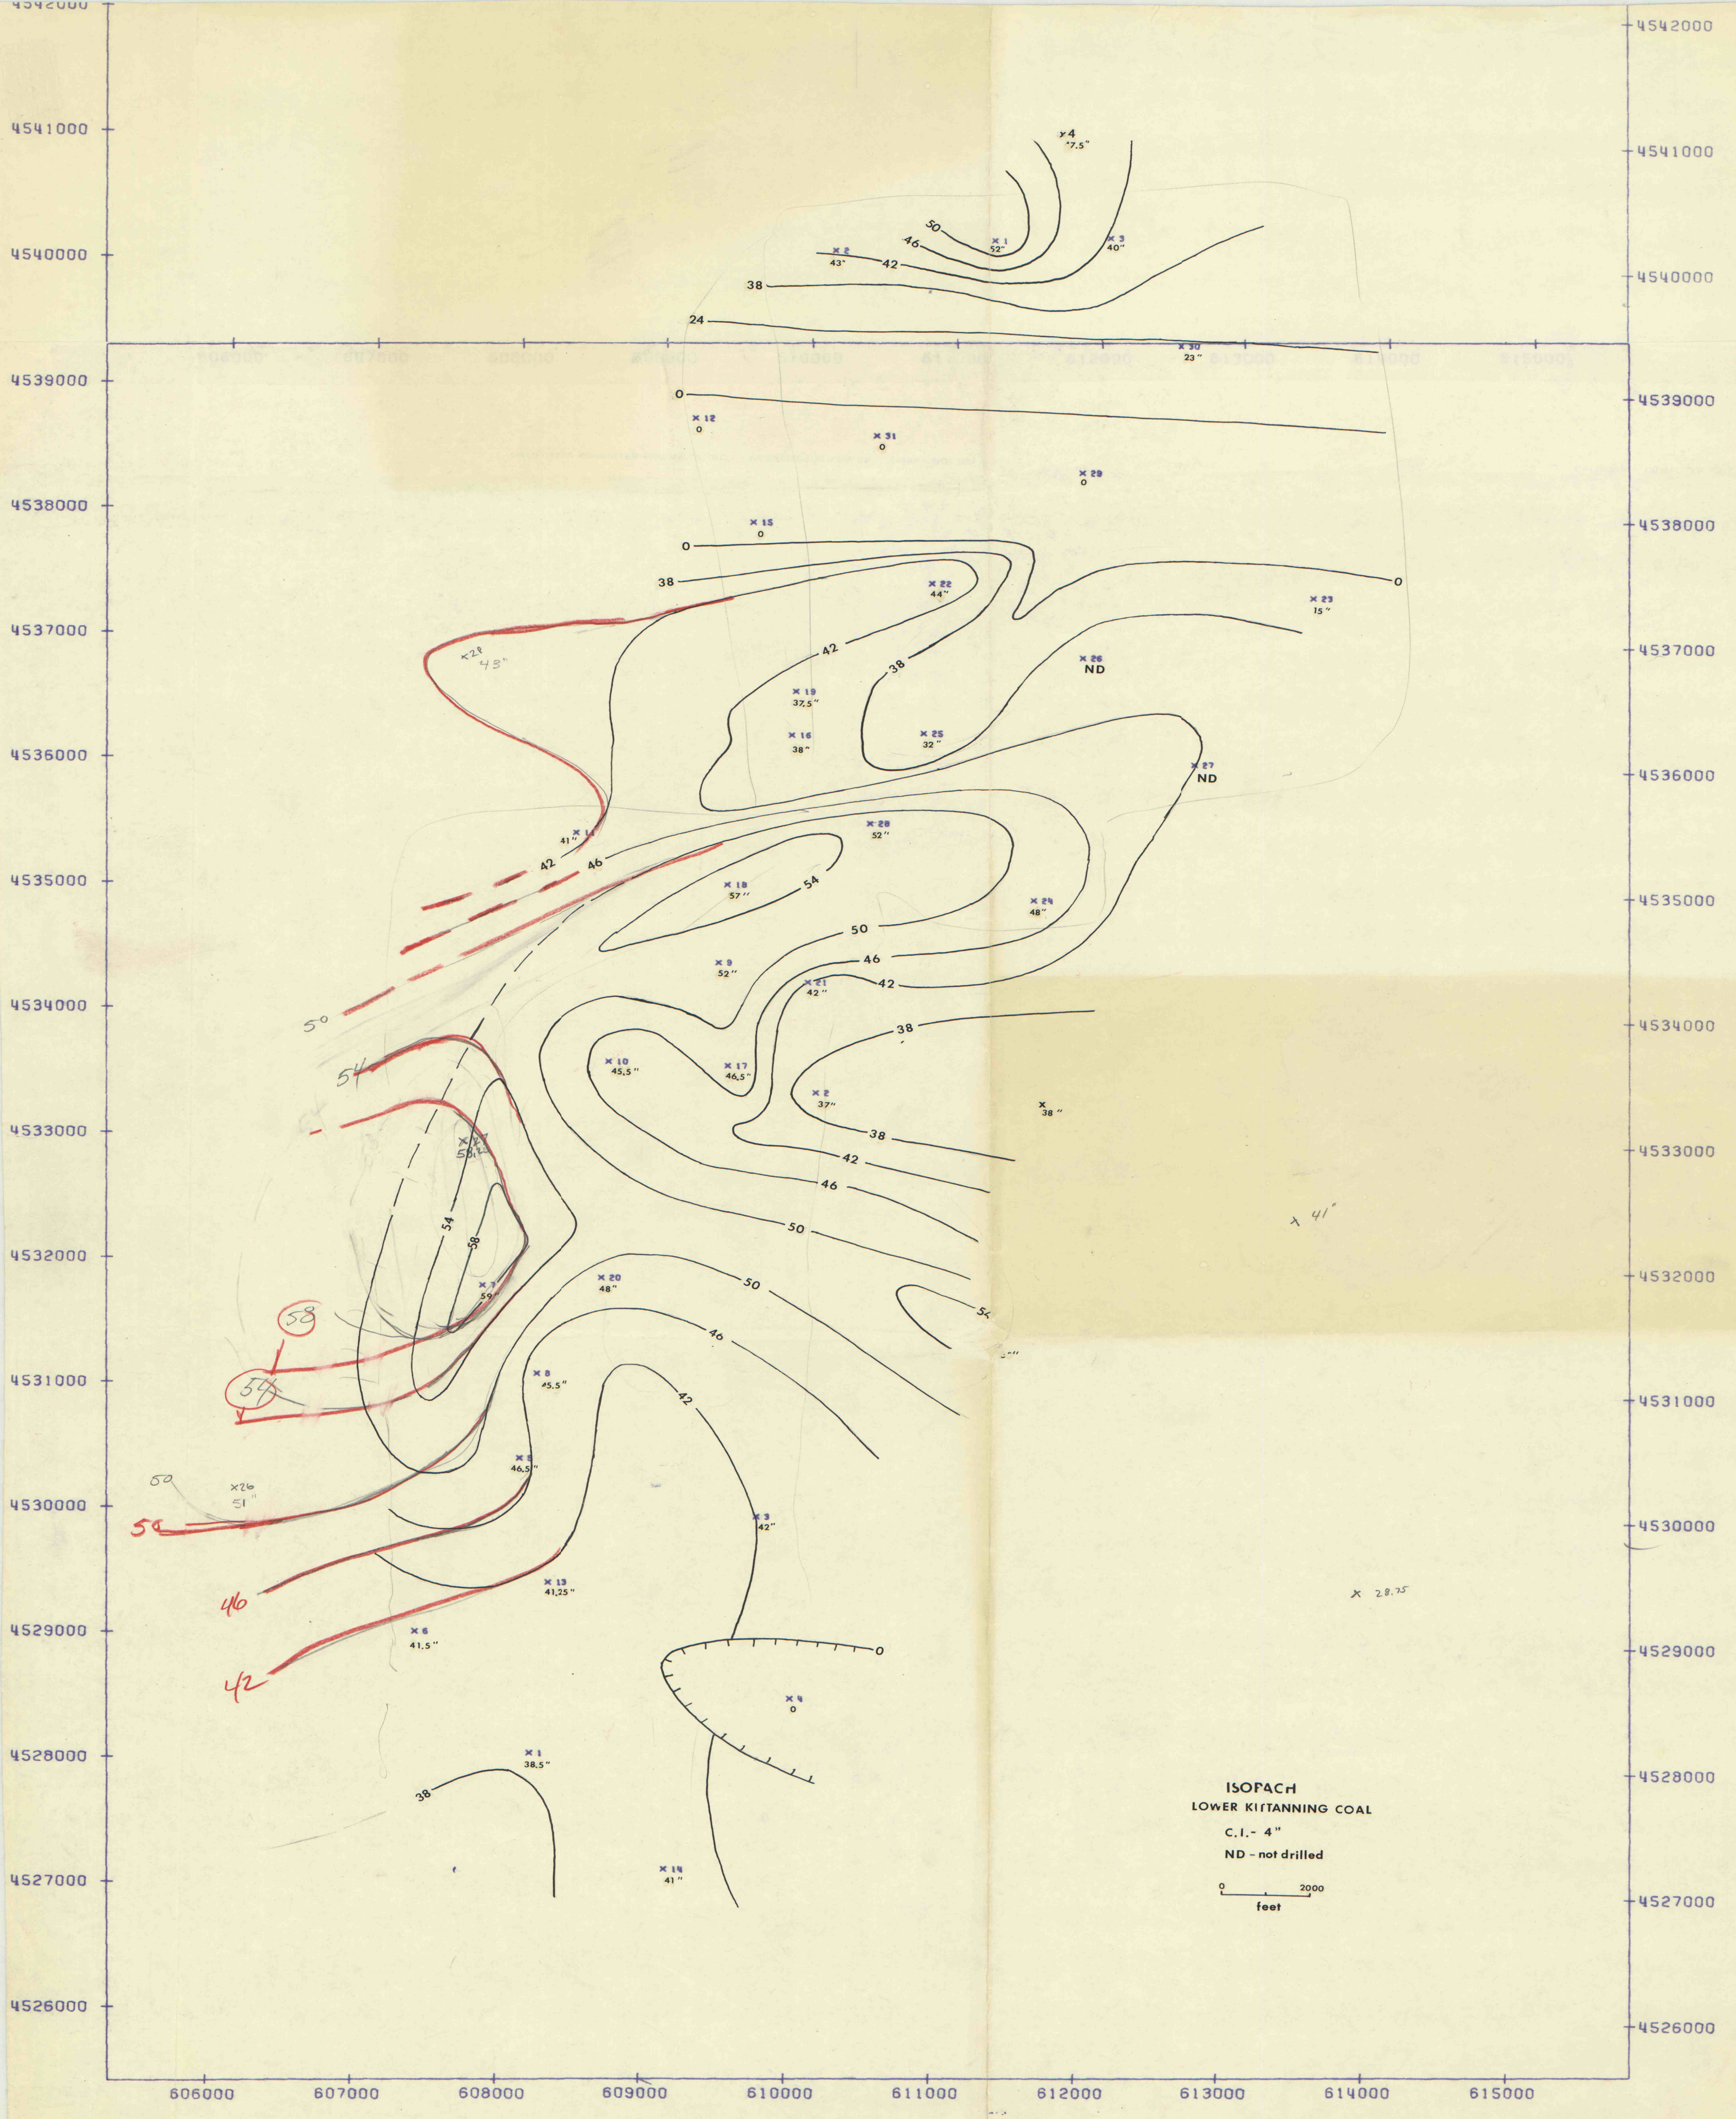

IMAPS#12048